DETAILS

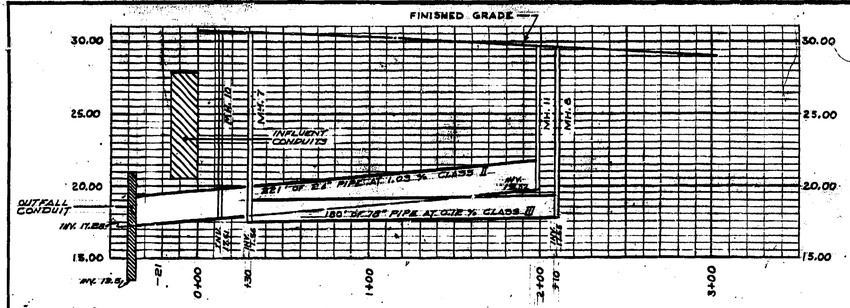

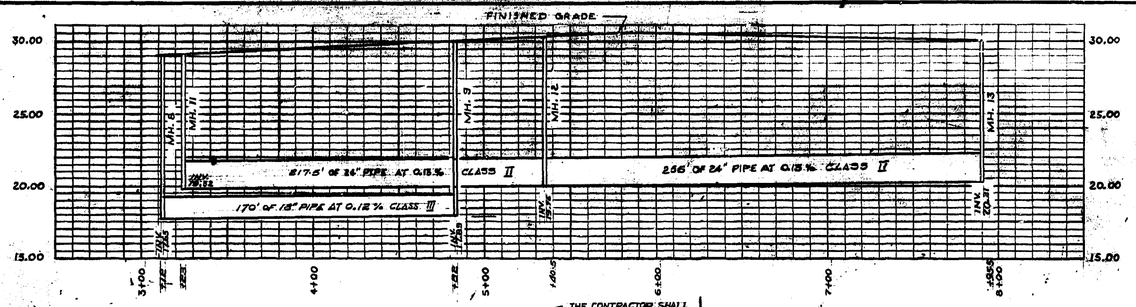

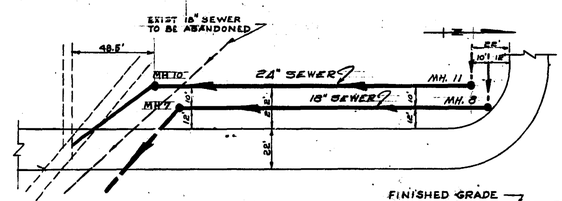

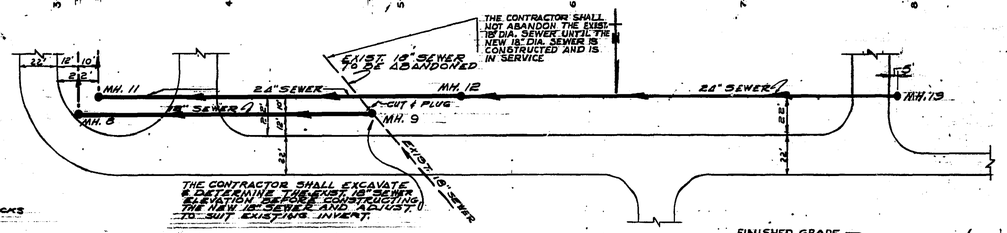

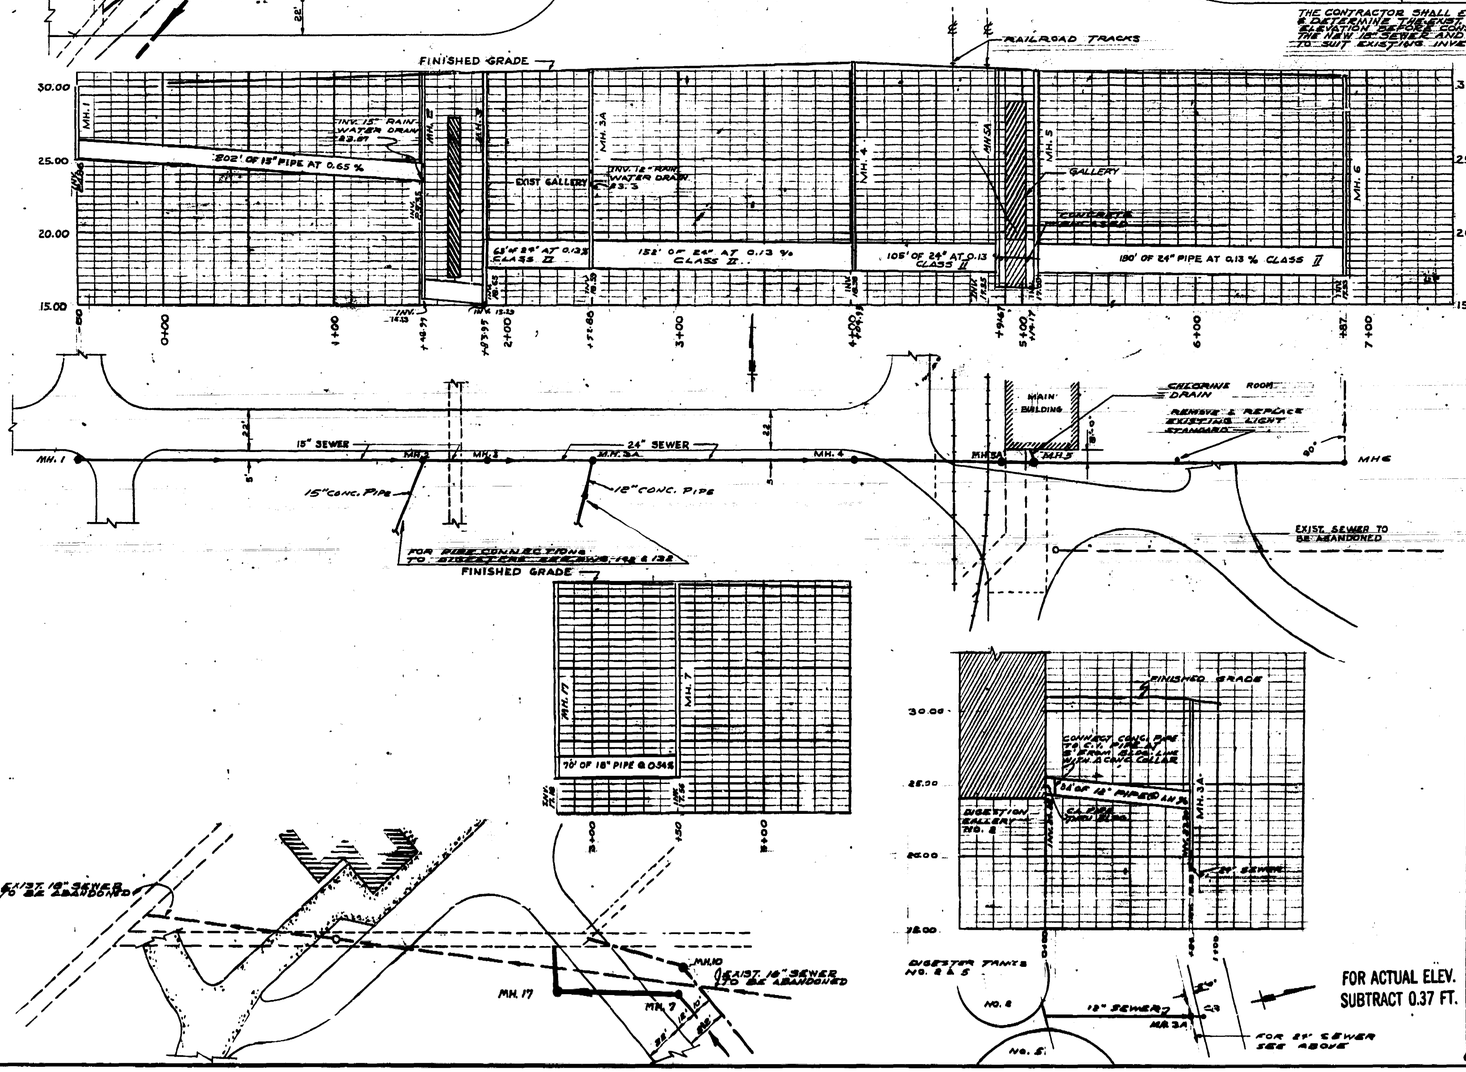

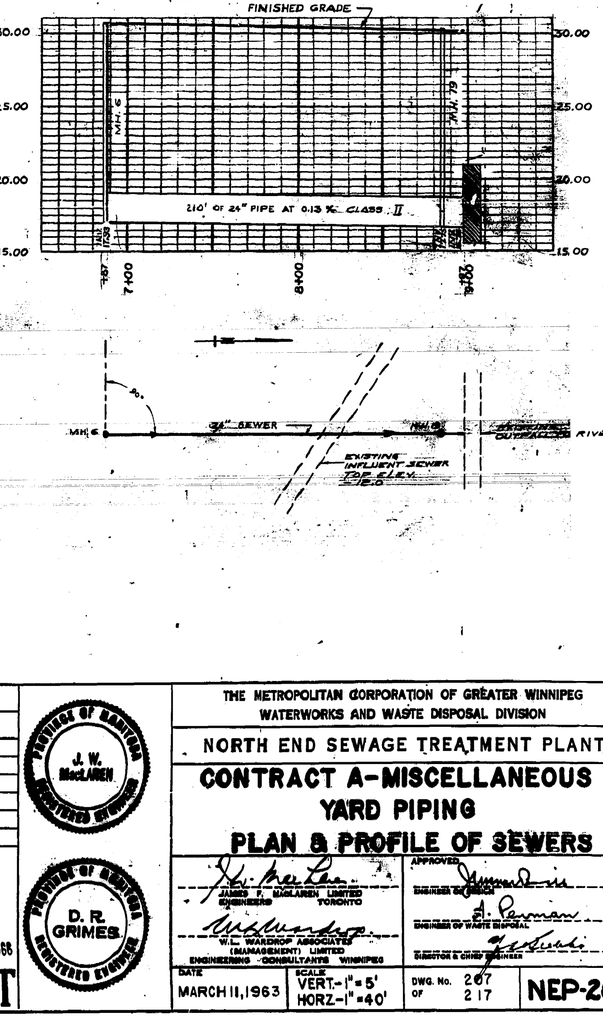

FOR ACTUAL ELEV. SUBTRACT 0.37 FT.

AS BUILT AUG .. 1968

REVISIONS		
No.	DATE	DETAIL

PROVINCE OF MANITOBA J. W. MacLAREN REGISTERED ENGINEER

PROVINCE OF MANITOBA D. R. GRIMES REGISTERED ENGINEER

THE METROPOLITAN CORPORATION OF GREATER WINNIPEG
WATERWORKS AND WASTE DISPOSAL DIVISION

NORTH END SEWAGE TREATMENT PLANT

CONTRACT A-MISCELLANEOUS YARD PIPING

PLAN & PROFILE OF SEWERS

J. W. MacLaren
JAMES F. MACLAREN LIMITED ENGINEERS TORONTO

W.L. WARDROP ASSOCIATES (MANAGEMENT) LIMITED ENGINEERING - CONSULTANTS WINNIPEG

APPROVED
ENGINEER OF WORKS

ENGINEER OF WASTE DISPOSAL

DIRECTOR & CHIEF ENGINEER

DATE MARCH 11, 1963

SCALE VERT.-1" = 5' HORZ.-1" = 40'

DWG. No. 207 OF 217

NEP-207

FILE 530-D-4745