


NOTE :This plot is to be used for general pipe routing information only.  
 All other data to be confirmed by the Gas Distribution Planning & Design Dept.

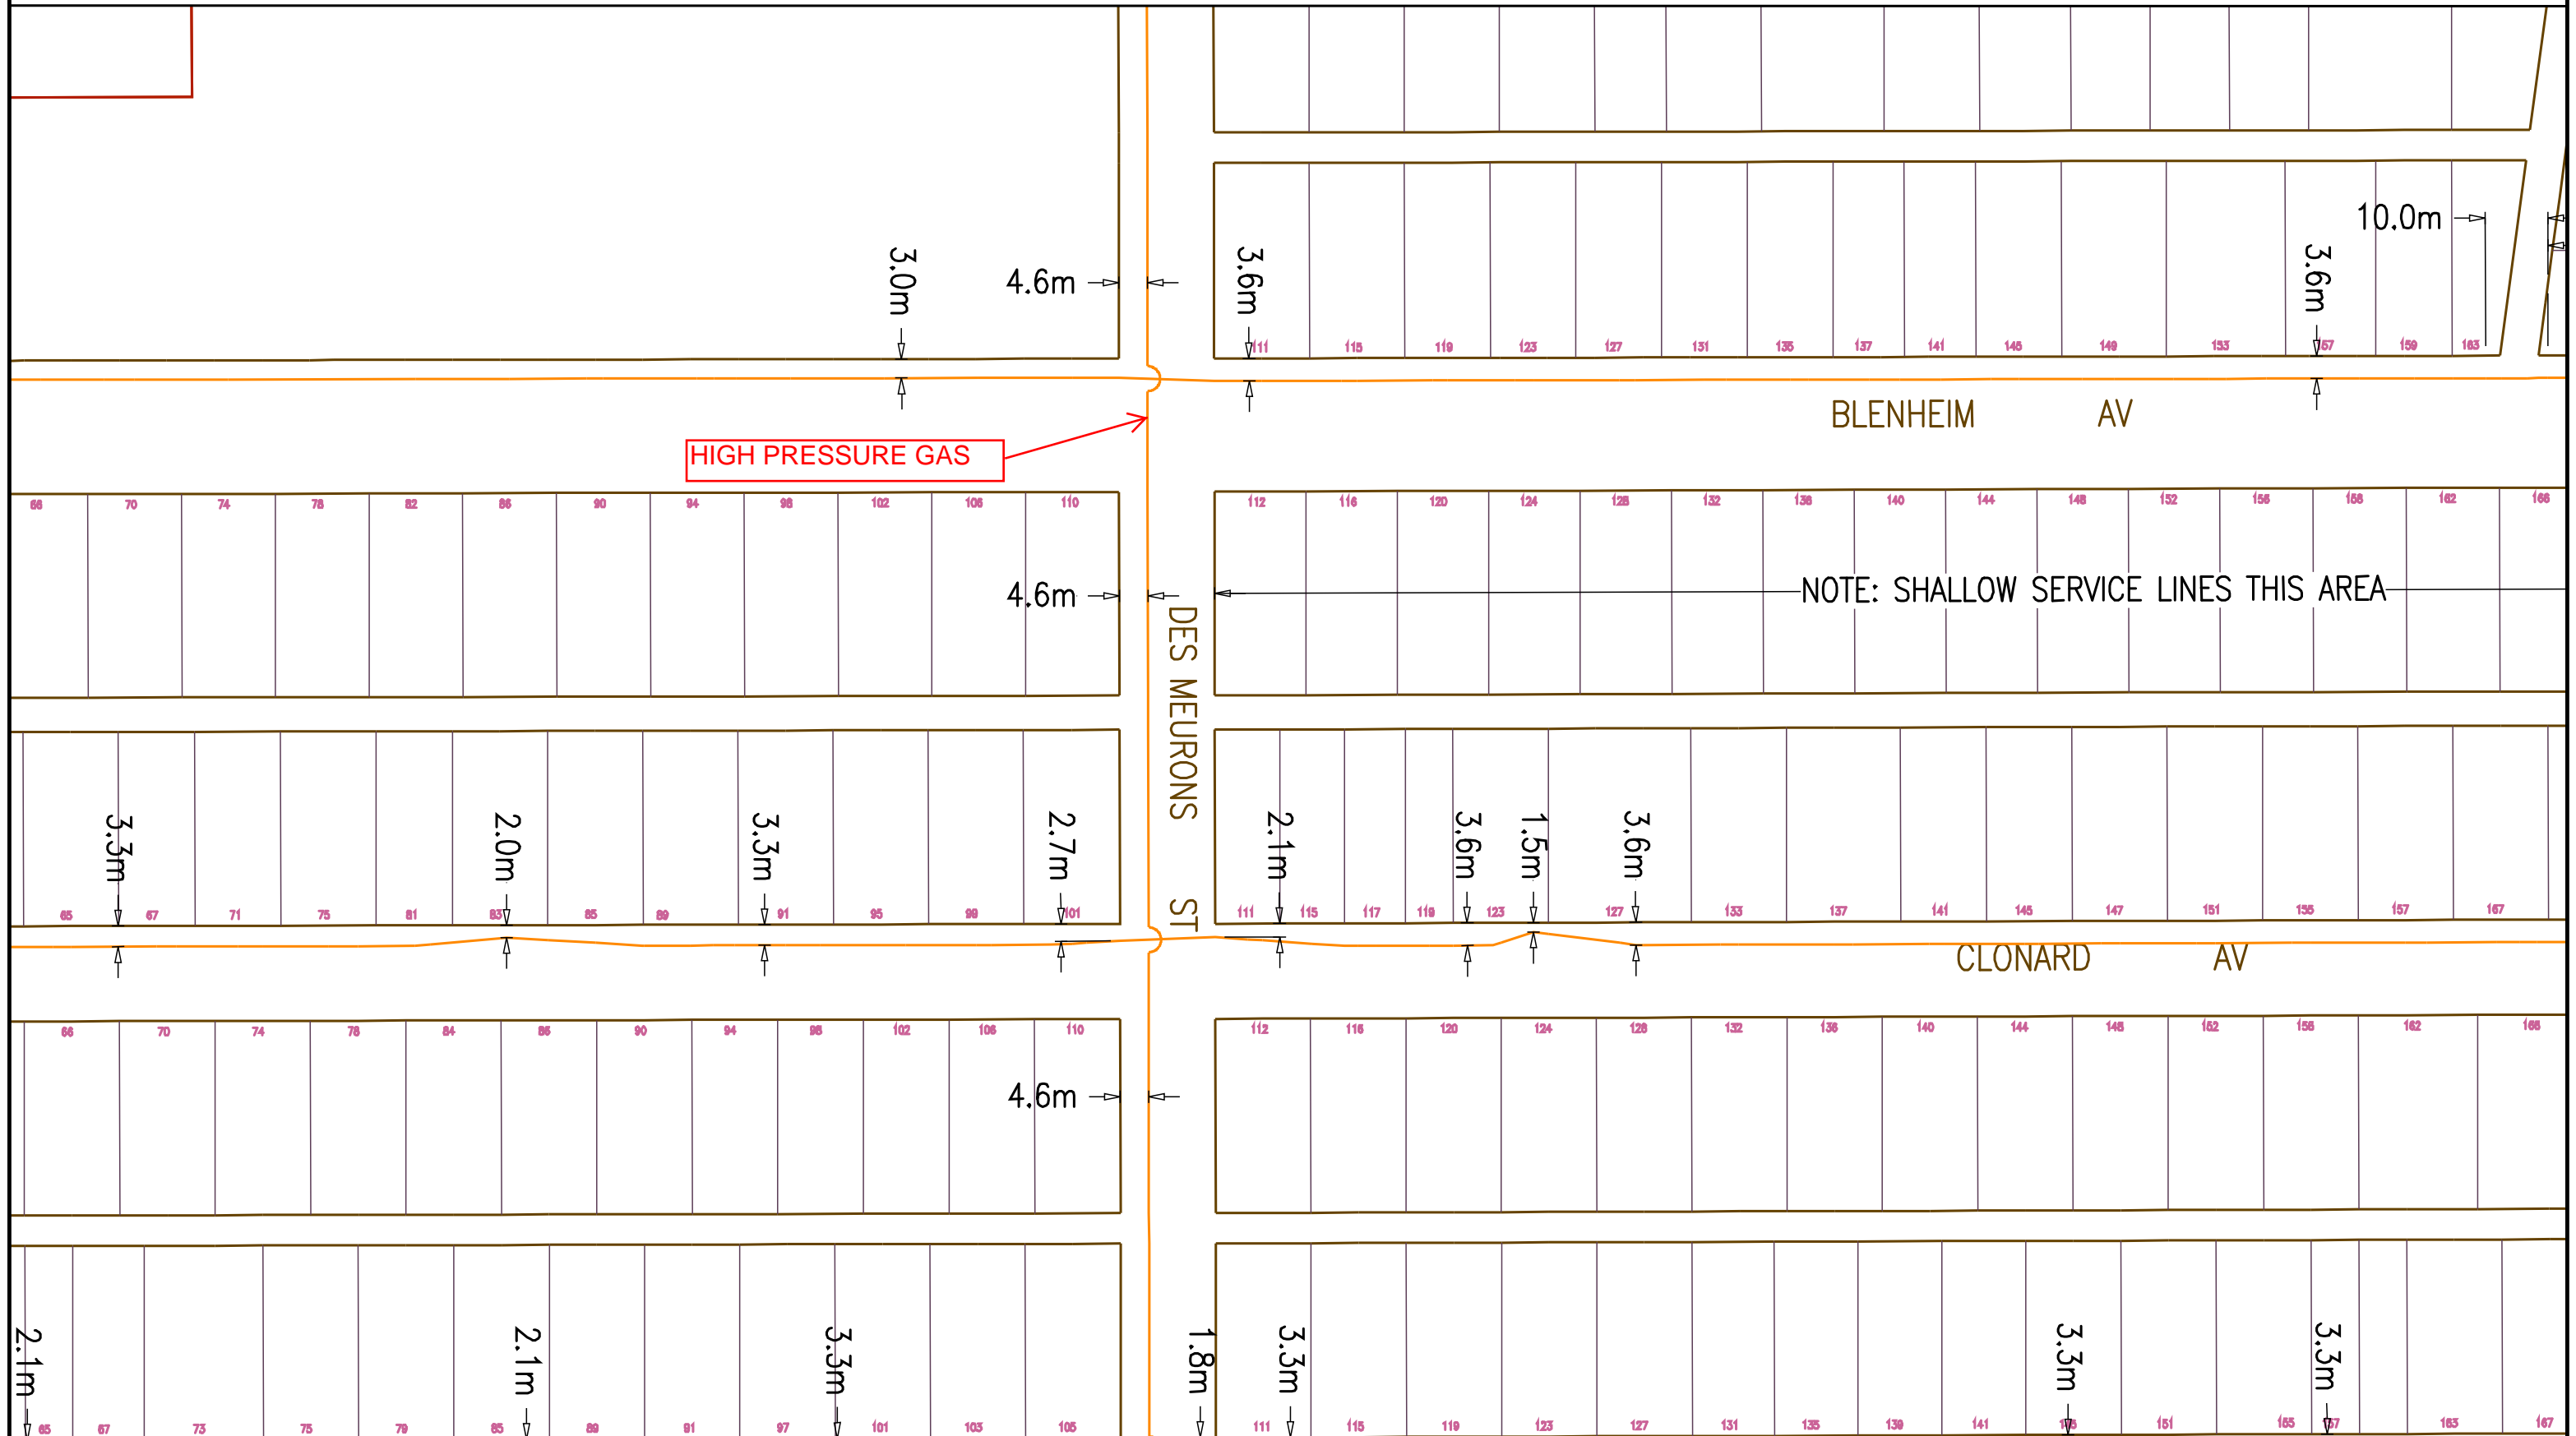

NOTE: Maximum Operating Pressure (MOP) is 420 kpa unless otherwise noted.  
 Outside Diameter (O.D.) of pipe in millimeters unless otherwise noted.

