


NOTES:

- FOR GENERAL NOTES SEE SHEET CS0001
- FOR EXISTING / PROPOSED UTILITY LAYOUT SEE C-1001 TO C-1009

AL - B416594

8033-11-21

AECOMMOB_DEFAULT.CTP

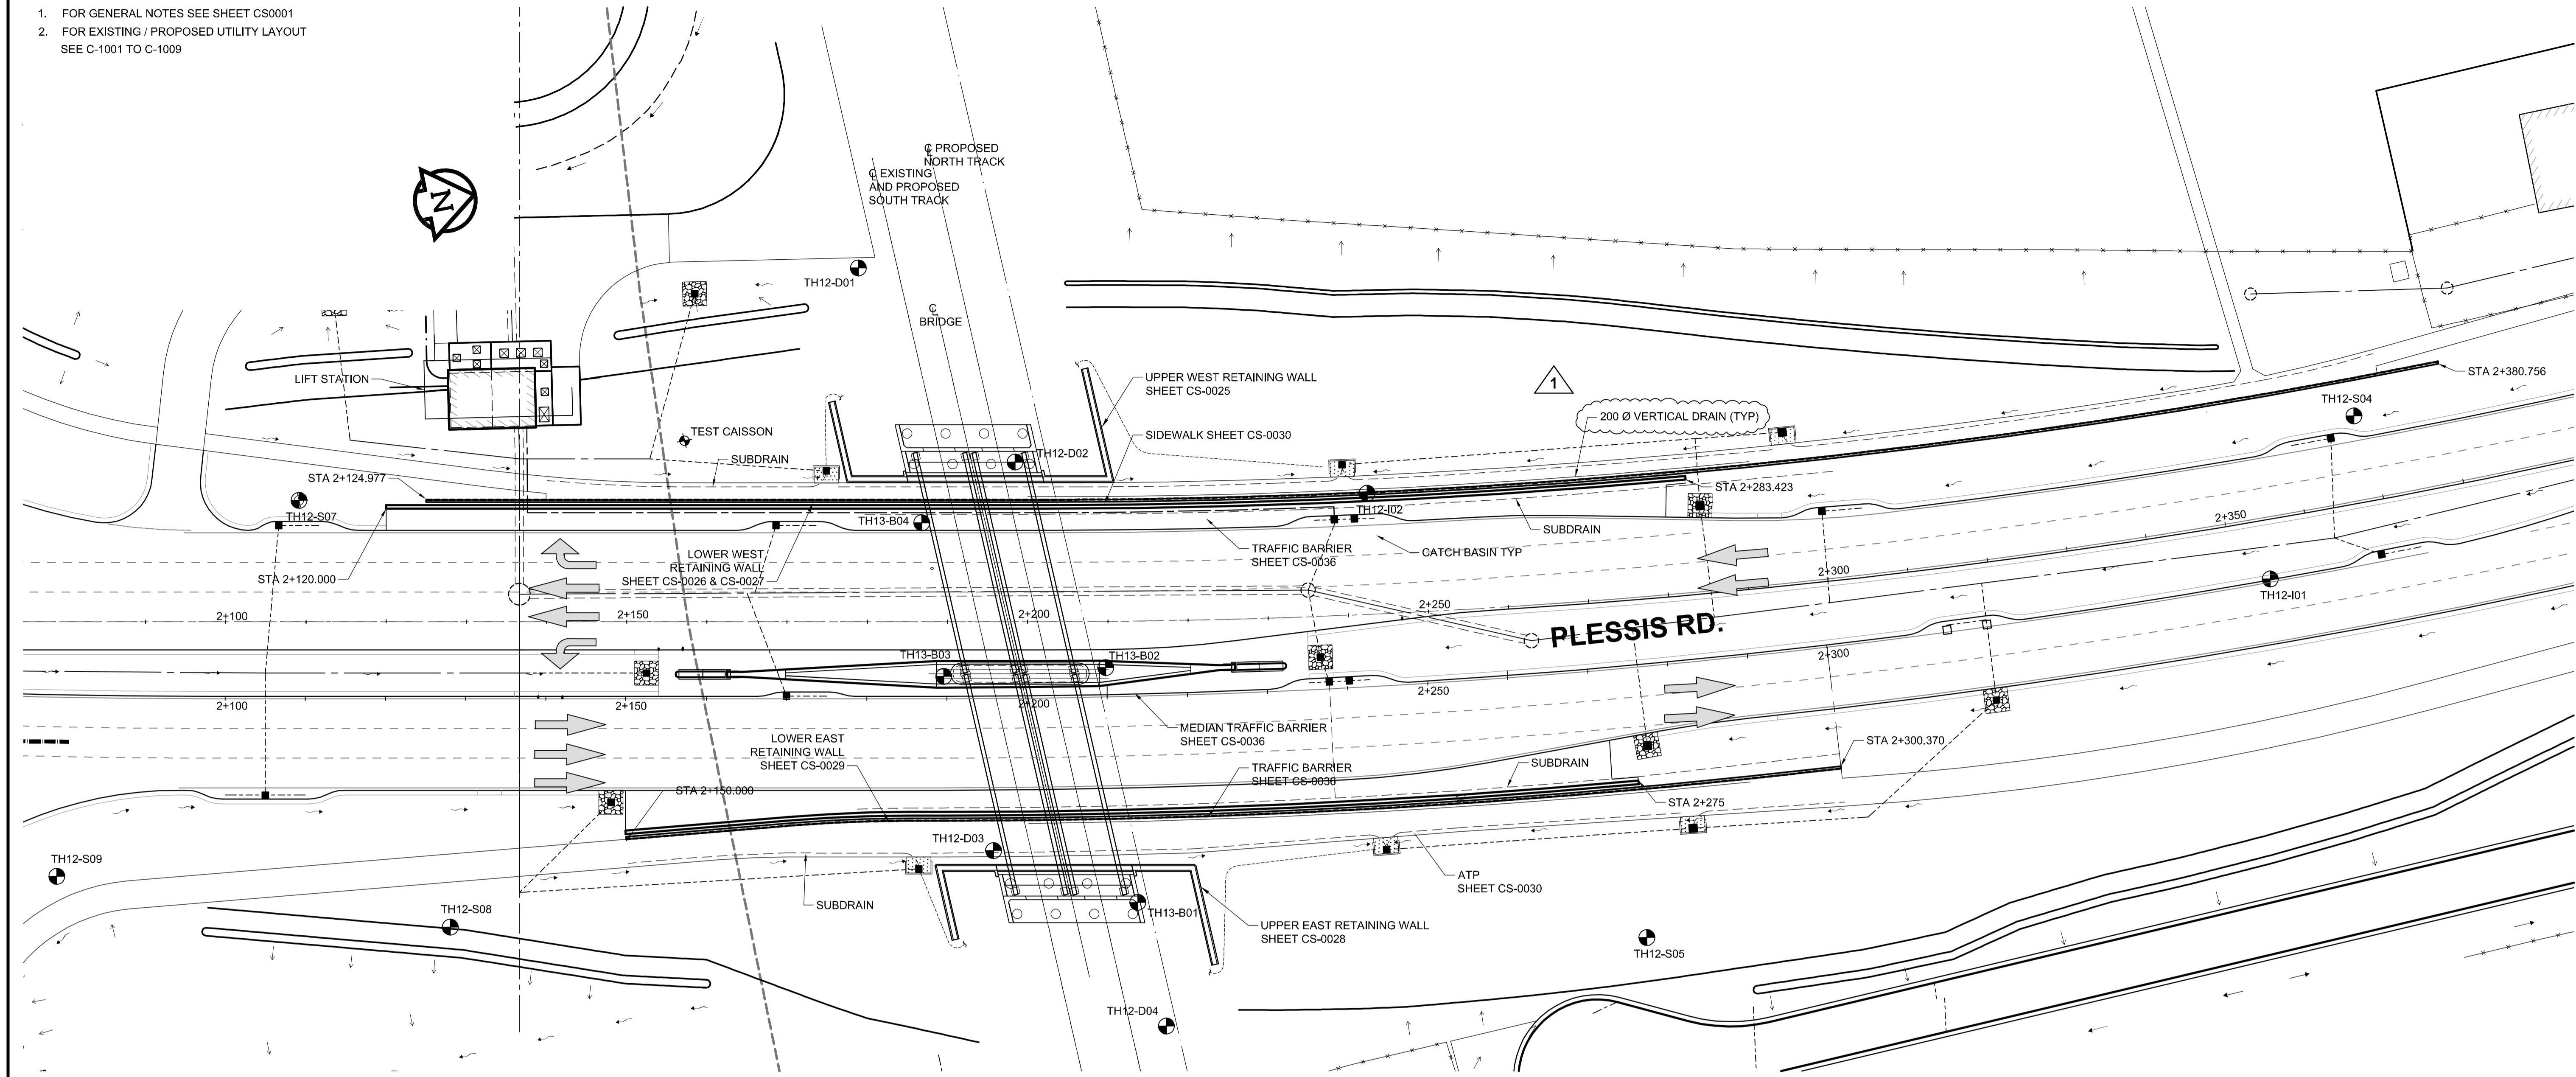

AECOM
 Certificate of Authorization
 AECOM Canada Ltd.
 ORIGINAL SIGNED ON
 No. 4671 Date: 2013/11/21

BID OPPORTUNITY NO. 712-2013

LOCATION APPROVED UNDERGROUND STRUCTURES	B.M. ELEV.
SUPV. U/G STRUCTURES COMMITTEE	DATE
NOTE: LOCATION OF UNDERGROUND STRUCTURES AS SHOWN ARE BASED ON THE BEST INFORMATION AVAILABLE, BUT NO GUARANTEE IS GIVEN THAT ALL EXISTING UTILITIES ARE SHOWN OR THAT THE GIVEN LOCATIONS ARE EXACT. CONFIRMATION OF EXISTENCE AND EXACT LOCATION OF ALL SERVICES MUST BE OBTAINED FROM THE INDIVIDUAL UTILITIES BEFORE PROCEEDING WITH CONSTRUCTION.	

NO.	REVISIONS	DATE	BY
1	ISSUED FOR ADDENDUM	2013/12/10	DJH
0	ISSUED FOR TENDER	2013/11/21	KC

AECOM

DESIGNED BY	FT	CHECKED BY	EBL
DRAWN BY	KC	APPROVED BY	EBL
HOR. SCALE:	AS NOTED	RELEASED FOR CONSTRUCTION BY:	
VERTICAL:	AS NOTED	DATE	2013-06-04

ENGINEER'S SEAL
 PROVINCE OF MANITOBA
 ORIGINAL SIGNED BY
F. TABET
 Member 39699
 ON NOV 21, 2013
 REGISTERED PROFESSIONAL ENGINEER

THE CITY OF WINNIPEG
 PUBLIC WORKS DEPARTMENT

PLESSIS ROAD TWINNING AND GRADE SEPARATION AT CN REDDITT SUBDIVISION CONTRACT 3

CITY DRAWING NUMBER U238-2014-2023
 SHEET 23 OF 37

RETAINING WALL LAYOUT

CS-0023

CONSULTANT DRAWING NO. 60273041-01-CS-501