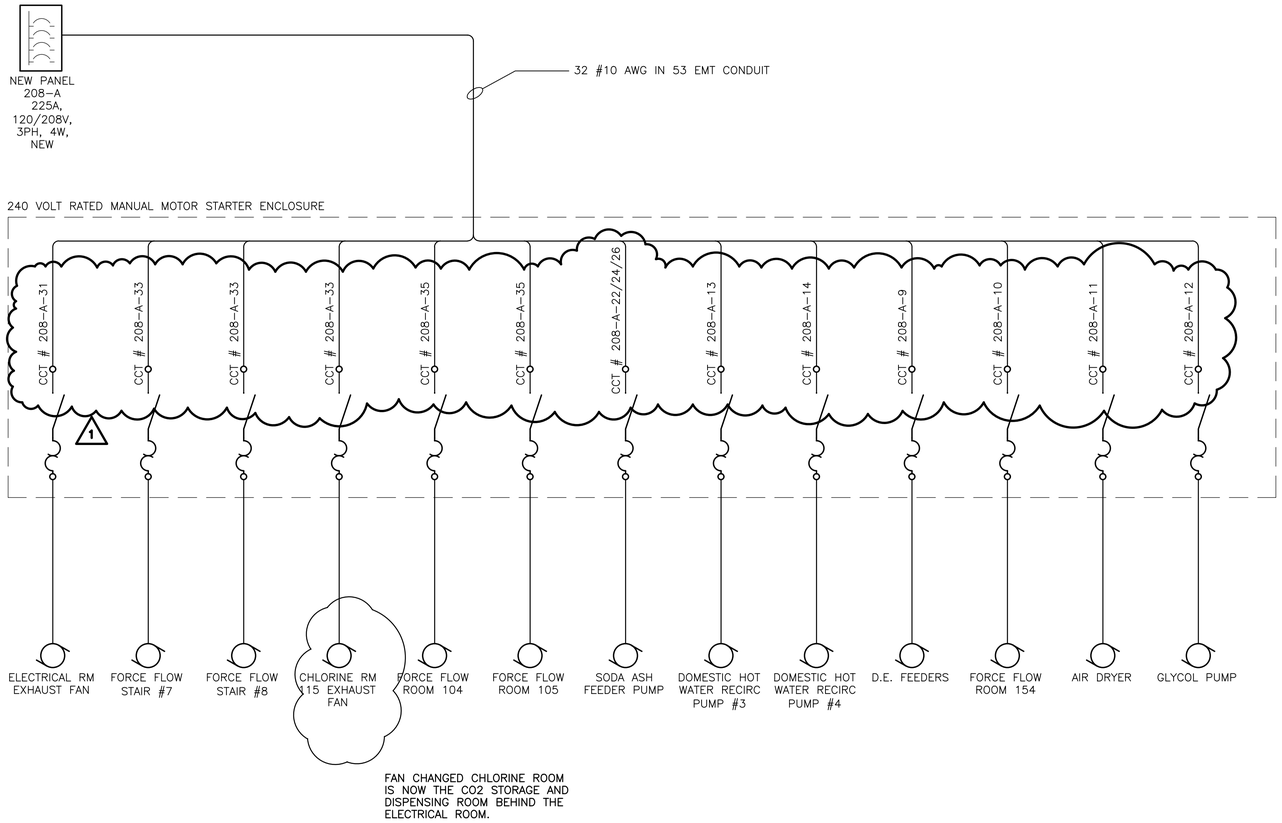

DILLON CONSULTING LIMITED 495 RICHMOND STREET, LONDON, ONTARIO, N6A 5A9, PHONE (519) 438-6192, FAX (519) 672-9209

File Name: g:\cad\137300\contract\current\04-electrical\e01-cd.dwg

Conditions of Use

Verify elevations and/or dimensions on drawing prior to use. Report any discrepancies to Dillon Consulting Limited.

Do not scale dimensions from drawing.

Do not modify drawing, re-use it, or use it for purposes other than those intended at the time of its preparation without prior written permission from Dillon Consulting Limited.

PROVINCE OF MANITOBA
ORIGINAL STAMPED BY
B.L. MOORE
NOV.20,13
REGISTERED PROFESSIONAL ENGINEER

APEGM
Certificate of Authorization
Dillon Consulting Limited (MB)
No. 1789 Date: 2013-11-20

DILLON CONSULTING

No.	ISSUED FOR	DATE	BY
1	ISSUED FOR ADDENDUM No.1	13-12-10	SCK
0	ISSUED FOR BID OPPORTUNITY NUMBER 850-2013	13-11-20	SCK

DESIGN | REVIEWED BY
DRAWN | CHECKED BY
DATE FEB. 12, 2013
SCALE N.T.S.

PAN AM POOL ELECTRICAL UPGRADE

ELECTRICAL
120 VOLT MOTOR STARTERS

PROJECT NO. 137300

SHEET NO. **E413**