

GENERAL NOTES:

- ELECTRICAL WORK/MODIFICATION TO BE COMPLETED BY ELECTRICAL TRADE.

- MECHANICAL WORK/MODIFICATION TO BE COMPLETED BY MECHANICAL TRADE.

 RELOCATE UTILITIES TO NEW LOCATIONS WHERE AND AS REQUIRED. (SEE MECHANICAL & ELECTRICAL DRAWINGS.)

- READ NEW PROPOSED FLOOR PLAN IN CONJUNCTION WITH DEMOLITION PLAN, STRUCTURAL, MECHANICAL AND ELECTRICAL DOCUMENTS.

- PATCH AND REPAIR ALL EXISTING GYPSUM CEILINGS WERE WALLS HAVE BEEN DEMOLISHED. SEAMLESSLY TRANSITION BETWEEN NEW AND EXISTING - TYPICAL.


- CONSULT THE ARCHITECT IF ANY UNCERTAINTIES AND/OR DISCREPANCIES ARISE.

- ALL NON-FIXED MILLWORK MAY NOT BE SHOWN AND WILL REQUIRE STORAGE AND RELOCATION AFTER CONSTRUCTION IS COMPLETED.

- MECHANICAL AND ELECTRICAL EQUIPMENT, FIXTURES, ETC. TO BE MODIFIED, REMOVED, RELOCATED AND/OR REPLACED AS REQUIRED FOR RENOVATION AND AS PER MECHANICAL AND ELECTRICAL DEMOLITION DRAWINGS.

- ALLOW FOR INSTALLATION OF NEW ACCESS PANELS IN EXISTING GYPSUM CEILINGS AS REQUIRED BY MECHANICAL AND ELECTRICAL COORDINATE QUANTITY AND LOCATIONS WITH MECHANICAL AND ELECTRICAL DRAWINGS - TYPICAL.

- MAKE GOOD ALL DISTURBED EXISTING CONDITIONS SHOWN TO REMAIN.

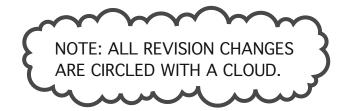

revision

The drawings, specifications, revisions, addendums, and clarifications, must be read as a whole. Errors and omissions due to separation of the documents by the general contractor become the responsibility of the same.

This drawing must not be scaled.

The general Contractor must verify all dimensions, datums and levels prior to commencement of work. All errors and omissions must be reported immediately to the Architect.

Variations and modifications to work shown on this drawing shall not be carried out without written permission from the Architect

