


**SECTION 1**  
S2 1:20

**RETAINING WALL BACKFILL NOTES:**  
FOR STRUCTURAL BACKFILL WITHIN 1m OF RETAINING WALLS, COMPACT IN LIFTS NOT EXCEEDING 150 THICK USING LIGHT EQUIPMENT.

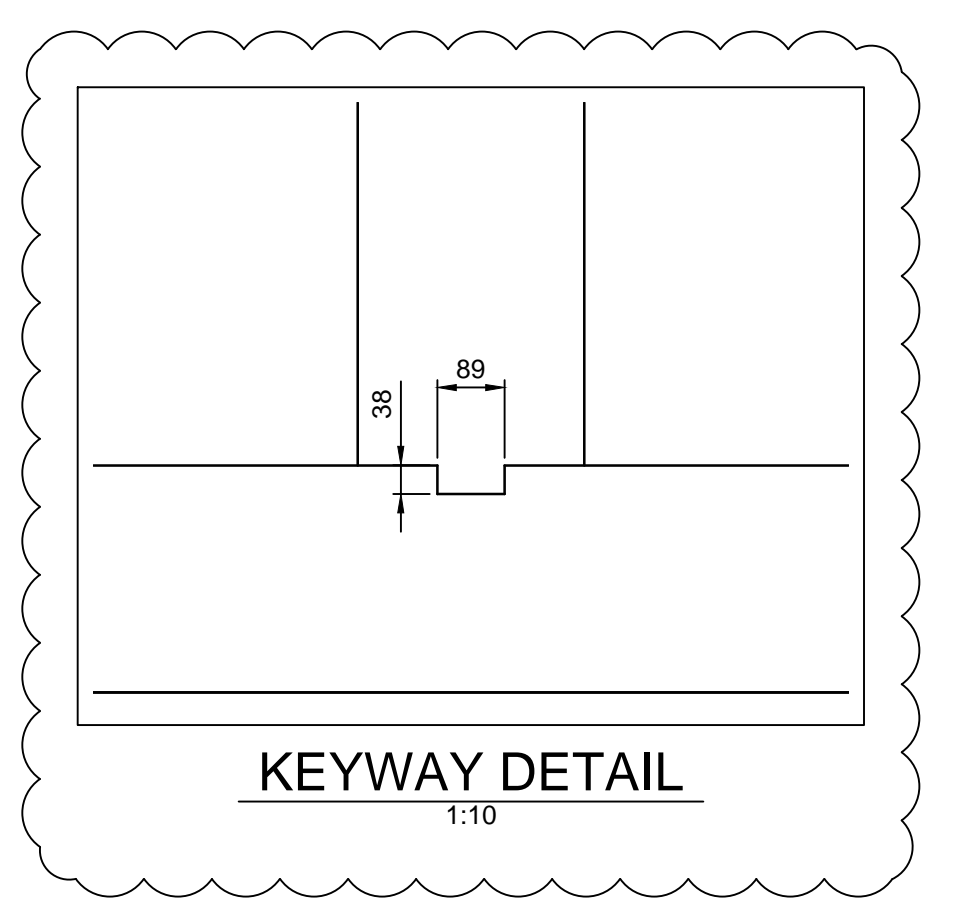

**METRIC**  
WHOLE NUMBERS INDICATE MILLIMETRES  
DECIMALIZED NUMBERS INDICATE METRES

C:\project\win\working\_directory\active\40ak\024576A\138224-09-STRUCT-CON-PACIFIC.dwg

**APEGM**  
Certificate of Authorization  
Dillon Consulting Limited (MB)  
No. 1789 Date: MAR. 4, 2016

NO.	REVISIONS	DATE	BY	DATE
2	ISSUED FOR ADDENDUM # 1	16/03/14	ARR	
1	ISSUED FOR TENDER	16/03/04	ARR	

DESIGNED BY	WH
DRAWN BY	PDR
CHECKED BY	NR
APPROVED BY	ARR
HOR. SCALE	AS NOTED
VERTICAL	VERTICAL

**DILLON CONSULTING**

RELEASED FOR CONSTRUCTION

DATE

ENGINEER'S SEAL

PROVINCE OF MANITOBA

REGISTERED PROFESSIONAL ENGINEER

RATTANWANGCHAROEN

MARCH 4/16

Member 23609

CONSULTANT PROJECT NUMBER

13-8224

**THE CITY OF WINNIPEG**  
PUBLIC WORKS DEPARTMENT

4R WINNIPEG DEPOT  
PACIFIC AVENUE

RETAINING WALL SECTIONS  
AND DETAILS

CITY DRAWING NUMBER  
1-0851A-S0005-001

SHEET 13 OF 43

CONSULTANT DRAWING NUMBER  
S-5