A1 SIZE - 594mm x 841mm

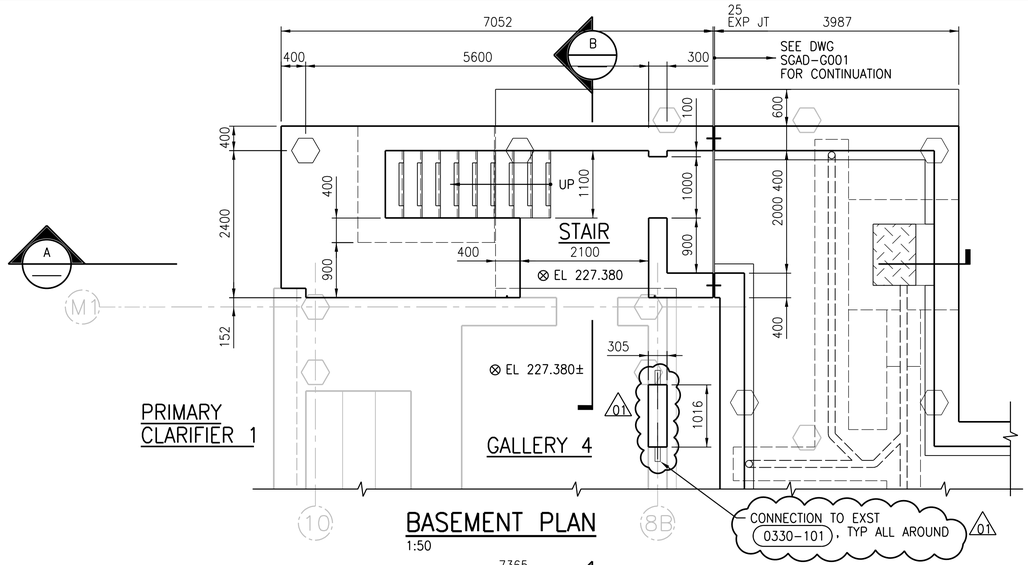

BASEMENT PLAN
1:50

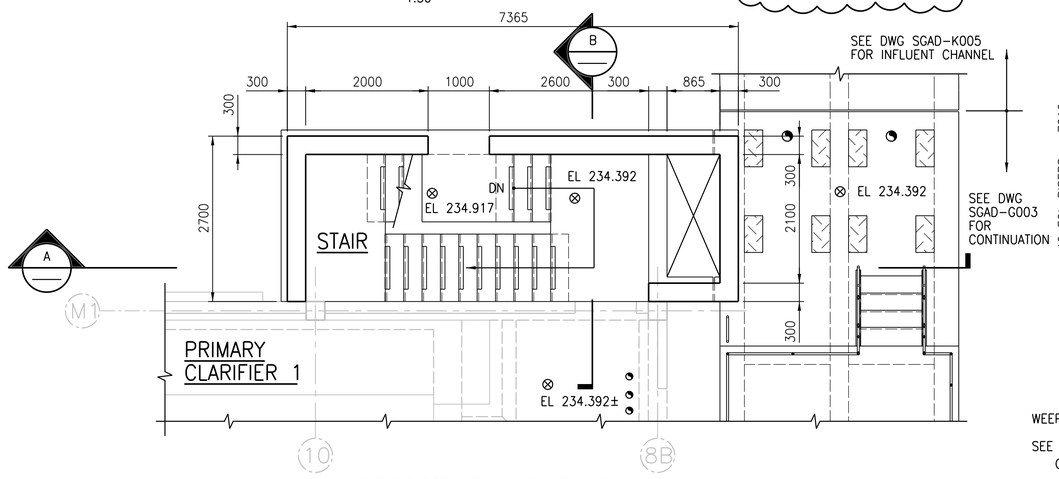

GROUND FLOOR PLAN
1:50

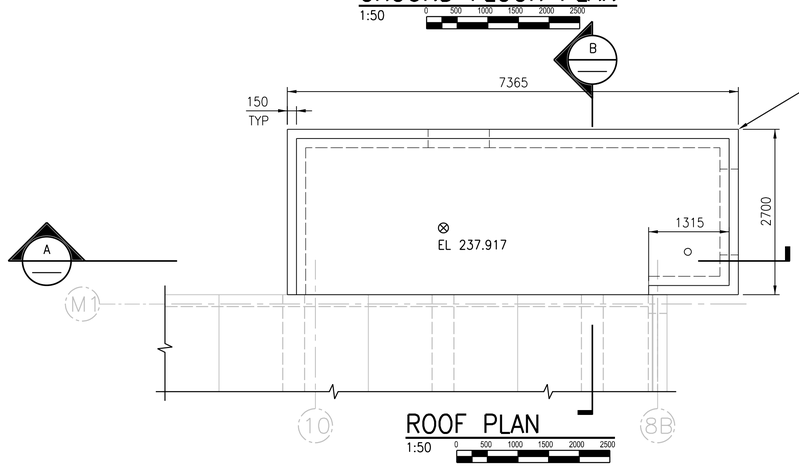

ROOF PLAN
1:50

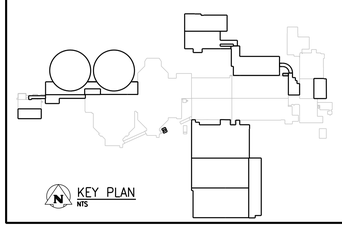

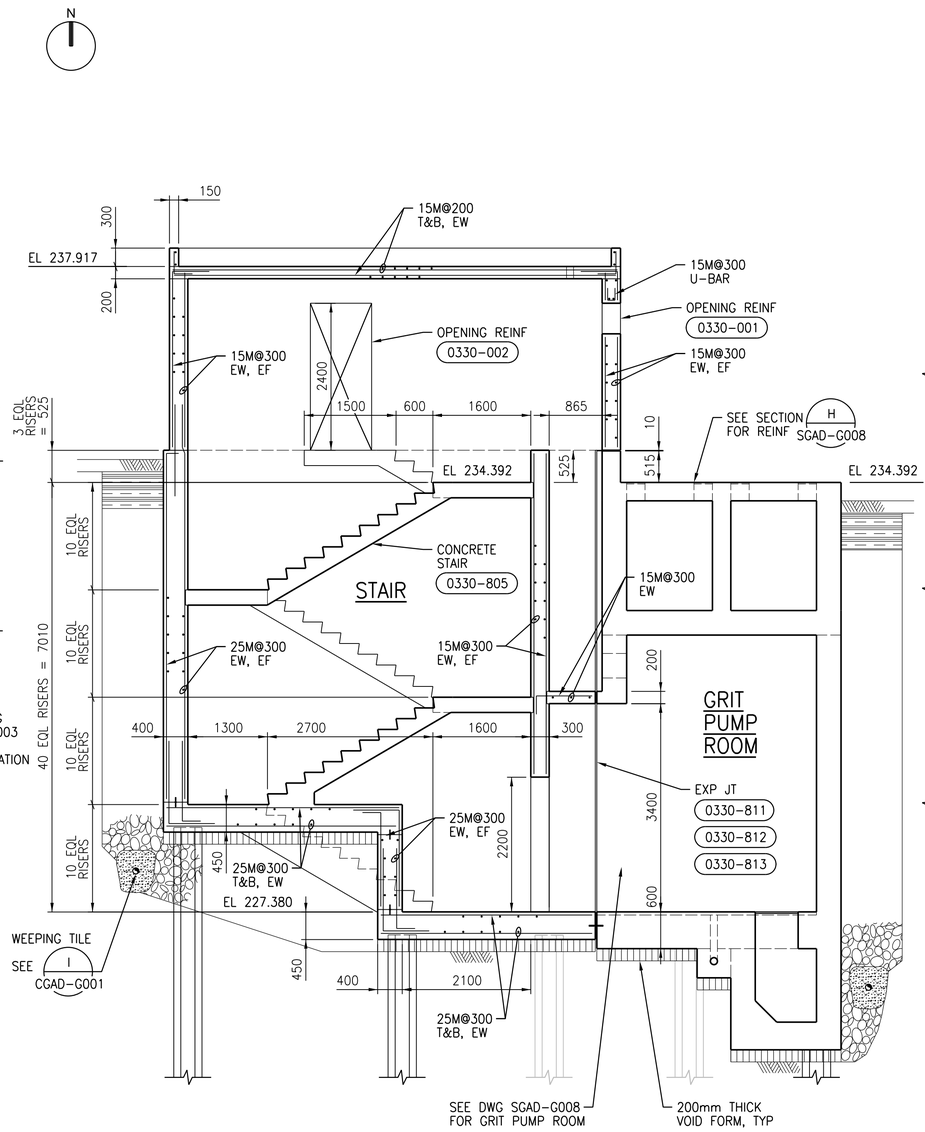

A SECTION
1:50

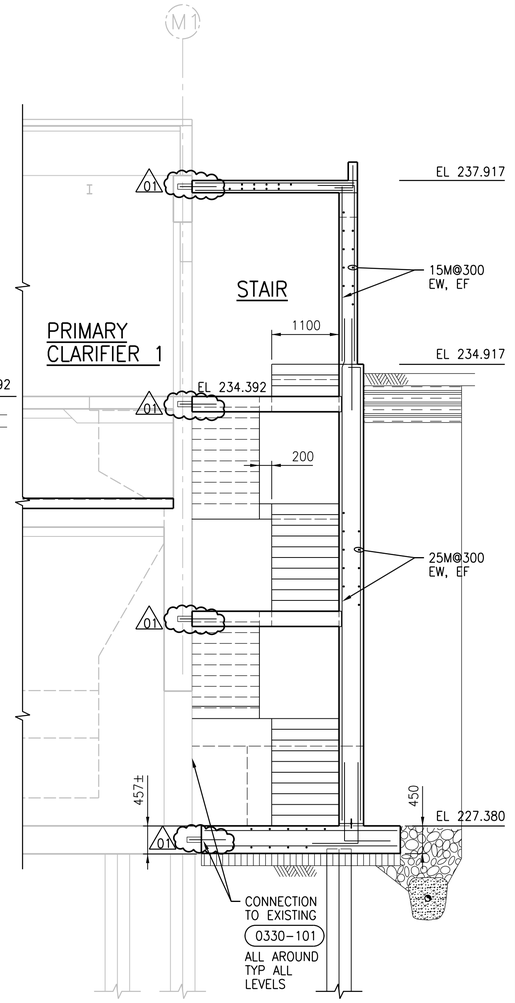

B SECTION
1:50

NOTES:

1. REFER TO DWG SDTL-A001 FOR GENERAL STRUCTURAL NOTES.
2. ELEVATIONS AT BASEMENT AND GROUND FLOOR LANDINGS TO MATCH ELEVATIONS OF EXISTING PRIMARY CLARIFIER TANK 1. NOTIFY CONTRACT ADMINISTRATOR OF DISCREPANCIES.
3. DESIGN LIVE LOAD FOR STAIRS IS 5 kPa.
4. DESIGN LIVE LOAD FOR ROOF IS 1 kPa.
5. DESIGN SNOW LOAD FOR ROOF IS 3 kPa.

APEGM
Certificate of Authorization
CH2M HILL Canada Ltd.
No. 1441

NO.	REVISIONS	DATE	DESIGN	CHECK
01	ISSUED FOR ADDENDUM NO. 2	09/2015	C.R.	J.C.
00	ISSUED FOR TENDER	08/2015	G.O.	J.C.

CH2MHILL
SNC-LAVALIN
KGS GROUP CONSULTING ENGINEERS

DESIGNED BY: E. LUI	CHECKED BY: R. PARIKH
DRAWN BY: G. OMORI	APPROVED BY: J. CHENG
SCALE: 1:50	ISSUED FOR CONSTRUCTION BY: T. TURZAK
DATE: 2015/08/13	DATE: 2015/08/13
CONSULTANT NO.: 474248	

ENGINEER'S SEAL
PROVINCE OF MANITOBA
S.L.F. LUI
Member
37003
REGISTERED PROFESSIONAL ENGINEER

Winnipeg
THE CITY OF WINNIPEG
WATER AND WASTE DEPARTMENT

SOUTH END WATER POLLUTION CONTROL CENTRE
SEWPCC UPGRADING/EXPANSION PROJECT
STRUCTURAL
PRIMARY CLARIFIERS
PLANS AND SECTIONS

CITY DRAWING NUMBER	SHEET	REV.	SIZE
1-0102-SGAD-P001		01	A1

PLOT DATE: 2015\09\10
FILE NAME:

©CH2M HILL 2015. ALL RIGHTS RESERVED.