


B SIZE - 279mm x 432mm

LAST SAVE: 2015/09/29 - 1:09pm  
 PATH: M:\629179\4ENG\48&C\DD - General DWG\1-0169L-A0010-001-01.dwg

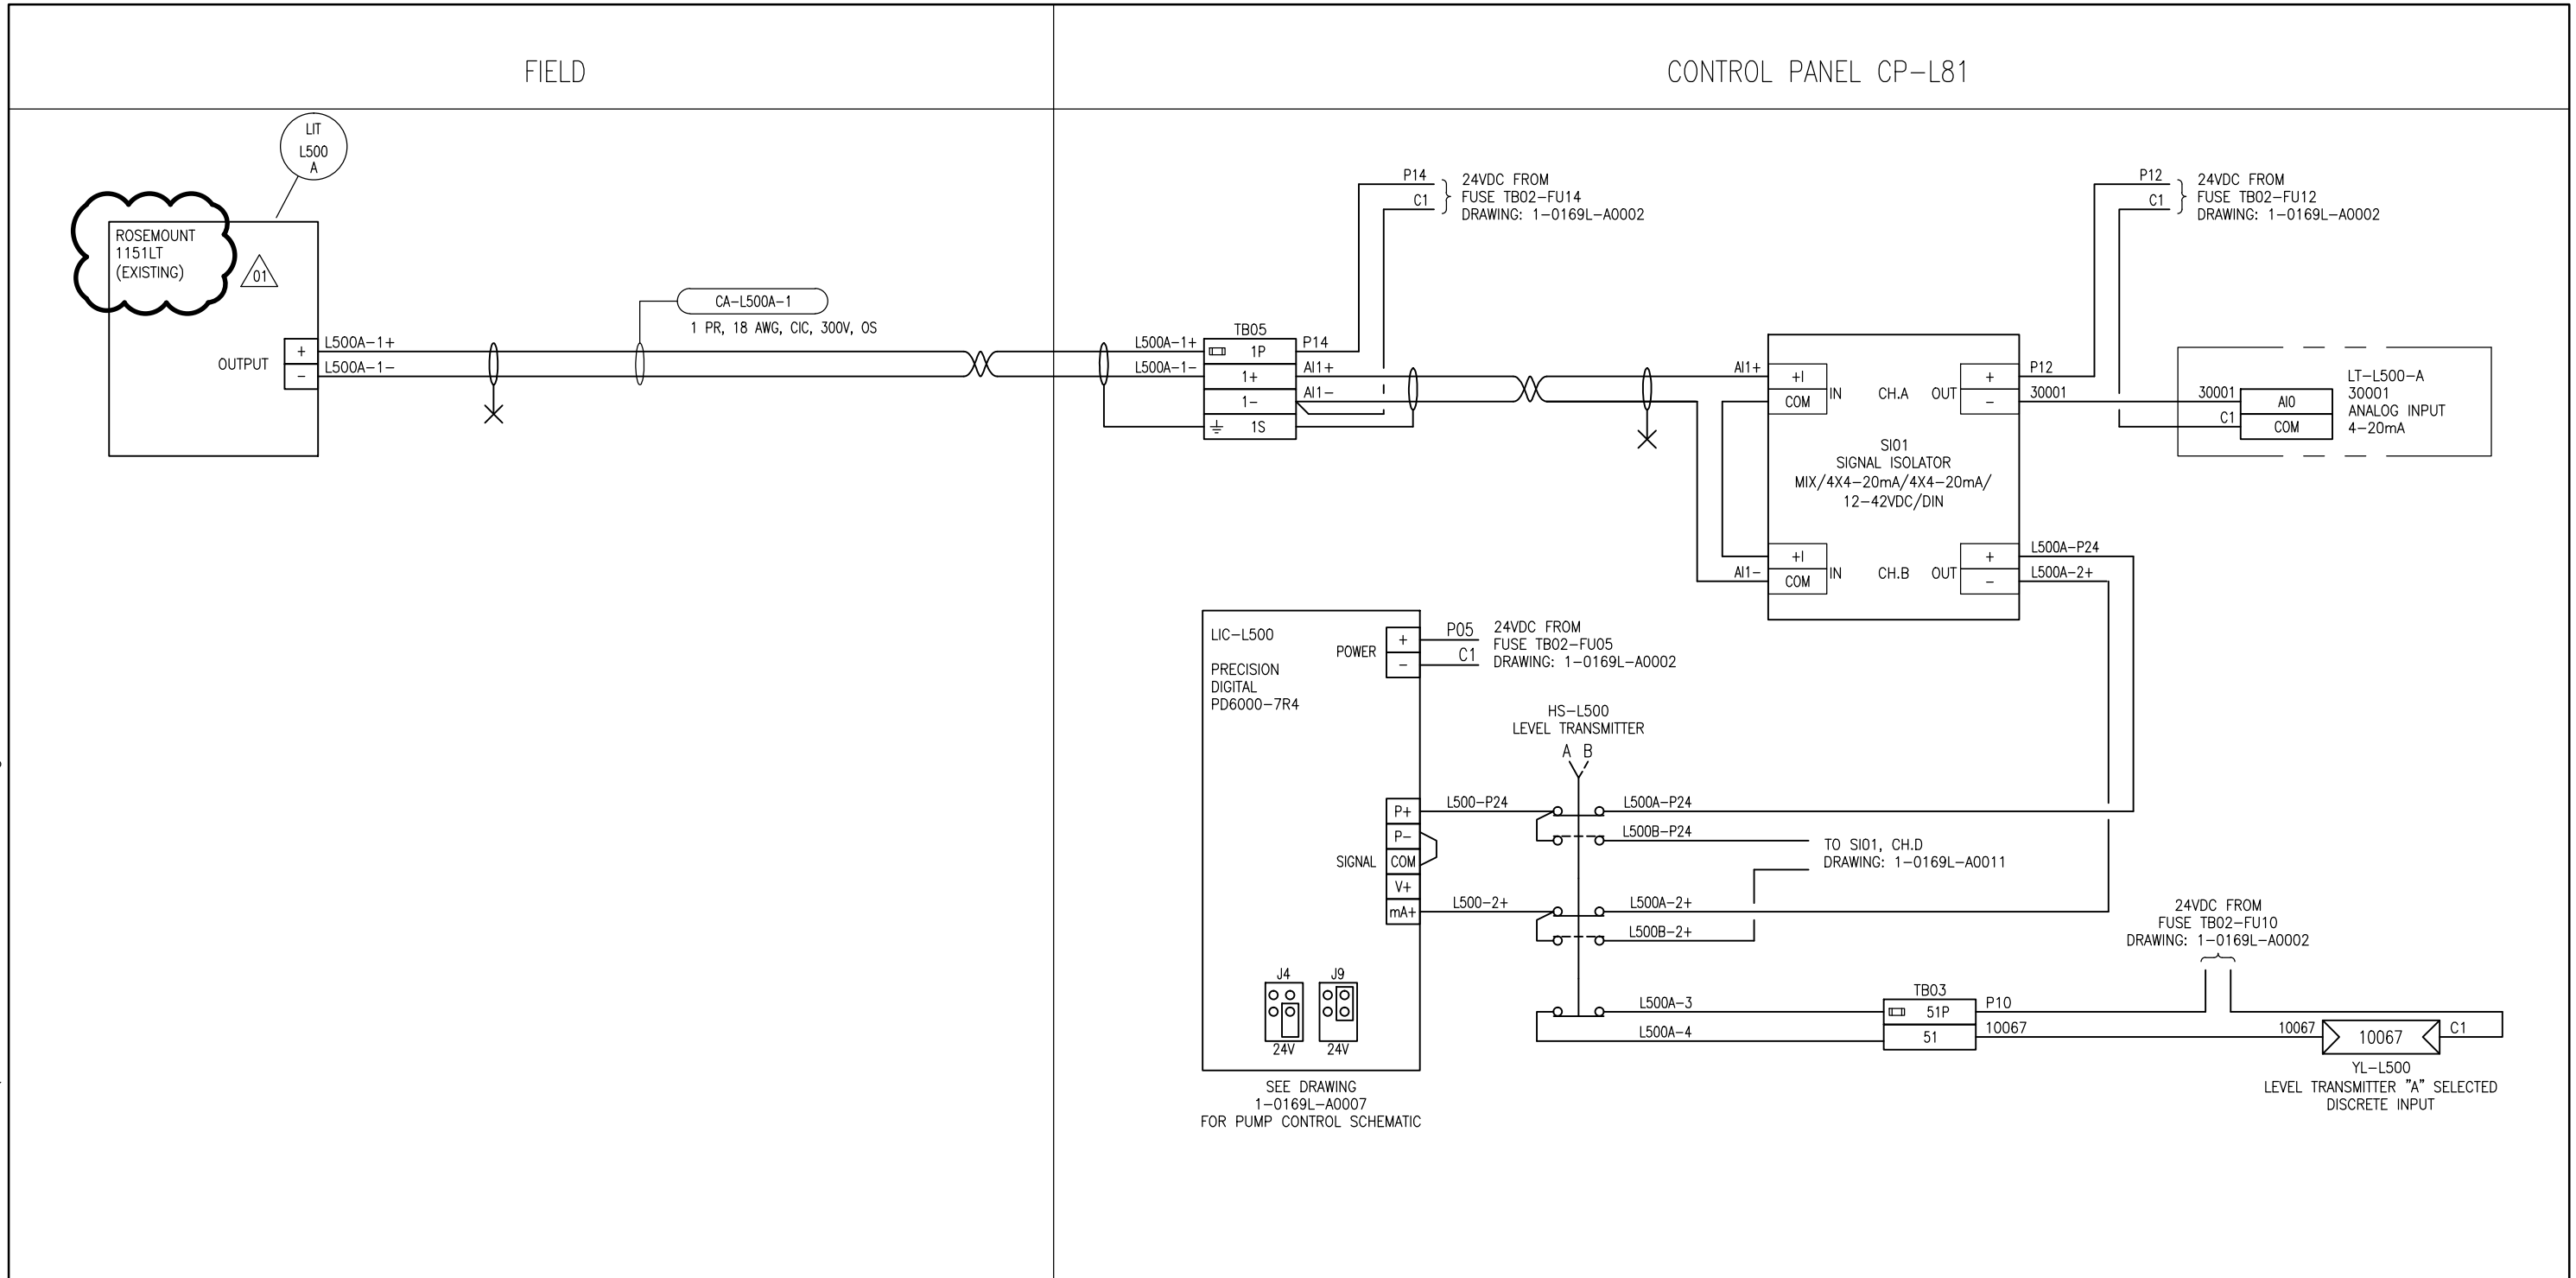

**SNC-LAVALIN INC.**  
 148 Nature Park Way  
 Winnipeg, MB, Canada R3P 0X7  
 204-786-8080

NO.	REVISIONS	DATE	DESIGN	CHECK
01	REVISED TRANSMITTER PART NUMBER	2015/09/28	BJC	-
00	ISSUED FOR TENDER	2015/09/17	BJC	-

DESIGNED BY: B. CLEVEN	CHECKED BY:
DRAWN BY: C. BURZYNSKI	APPROVED BY:
SCALE: NTS	DATE: 2015/08/06
ISSUED FOR CONSTRUCTION DATE:	
BY:	
CONSULTANT NO.:	

ENGINEER'S SEAL

**PRELIMINARY  
 NOT TO BE  
 USED FOR  
 CONSTRUCTION**

**THE CITY OF WINNIPEG**  
 WATER AND WASTE DEPARTMENT

OLIVE WASTEWATER PUMPING STATION  
 2015 UPGRADES  
 LOOP DIAGRAM  
 WET WELL LEVEL TRANSMITTER "A"  
 LIT-L500-A

CITY DRAWING NUMBER	SHEET	REV.	SIZE
1-0169L-A0010	001	01	B