




-ALL PLANS-

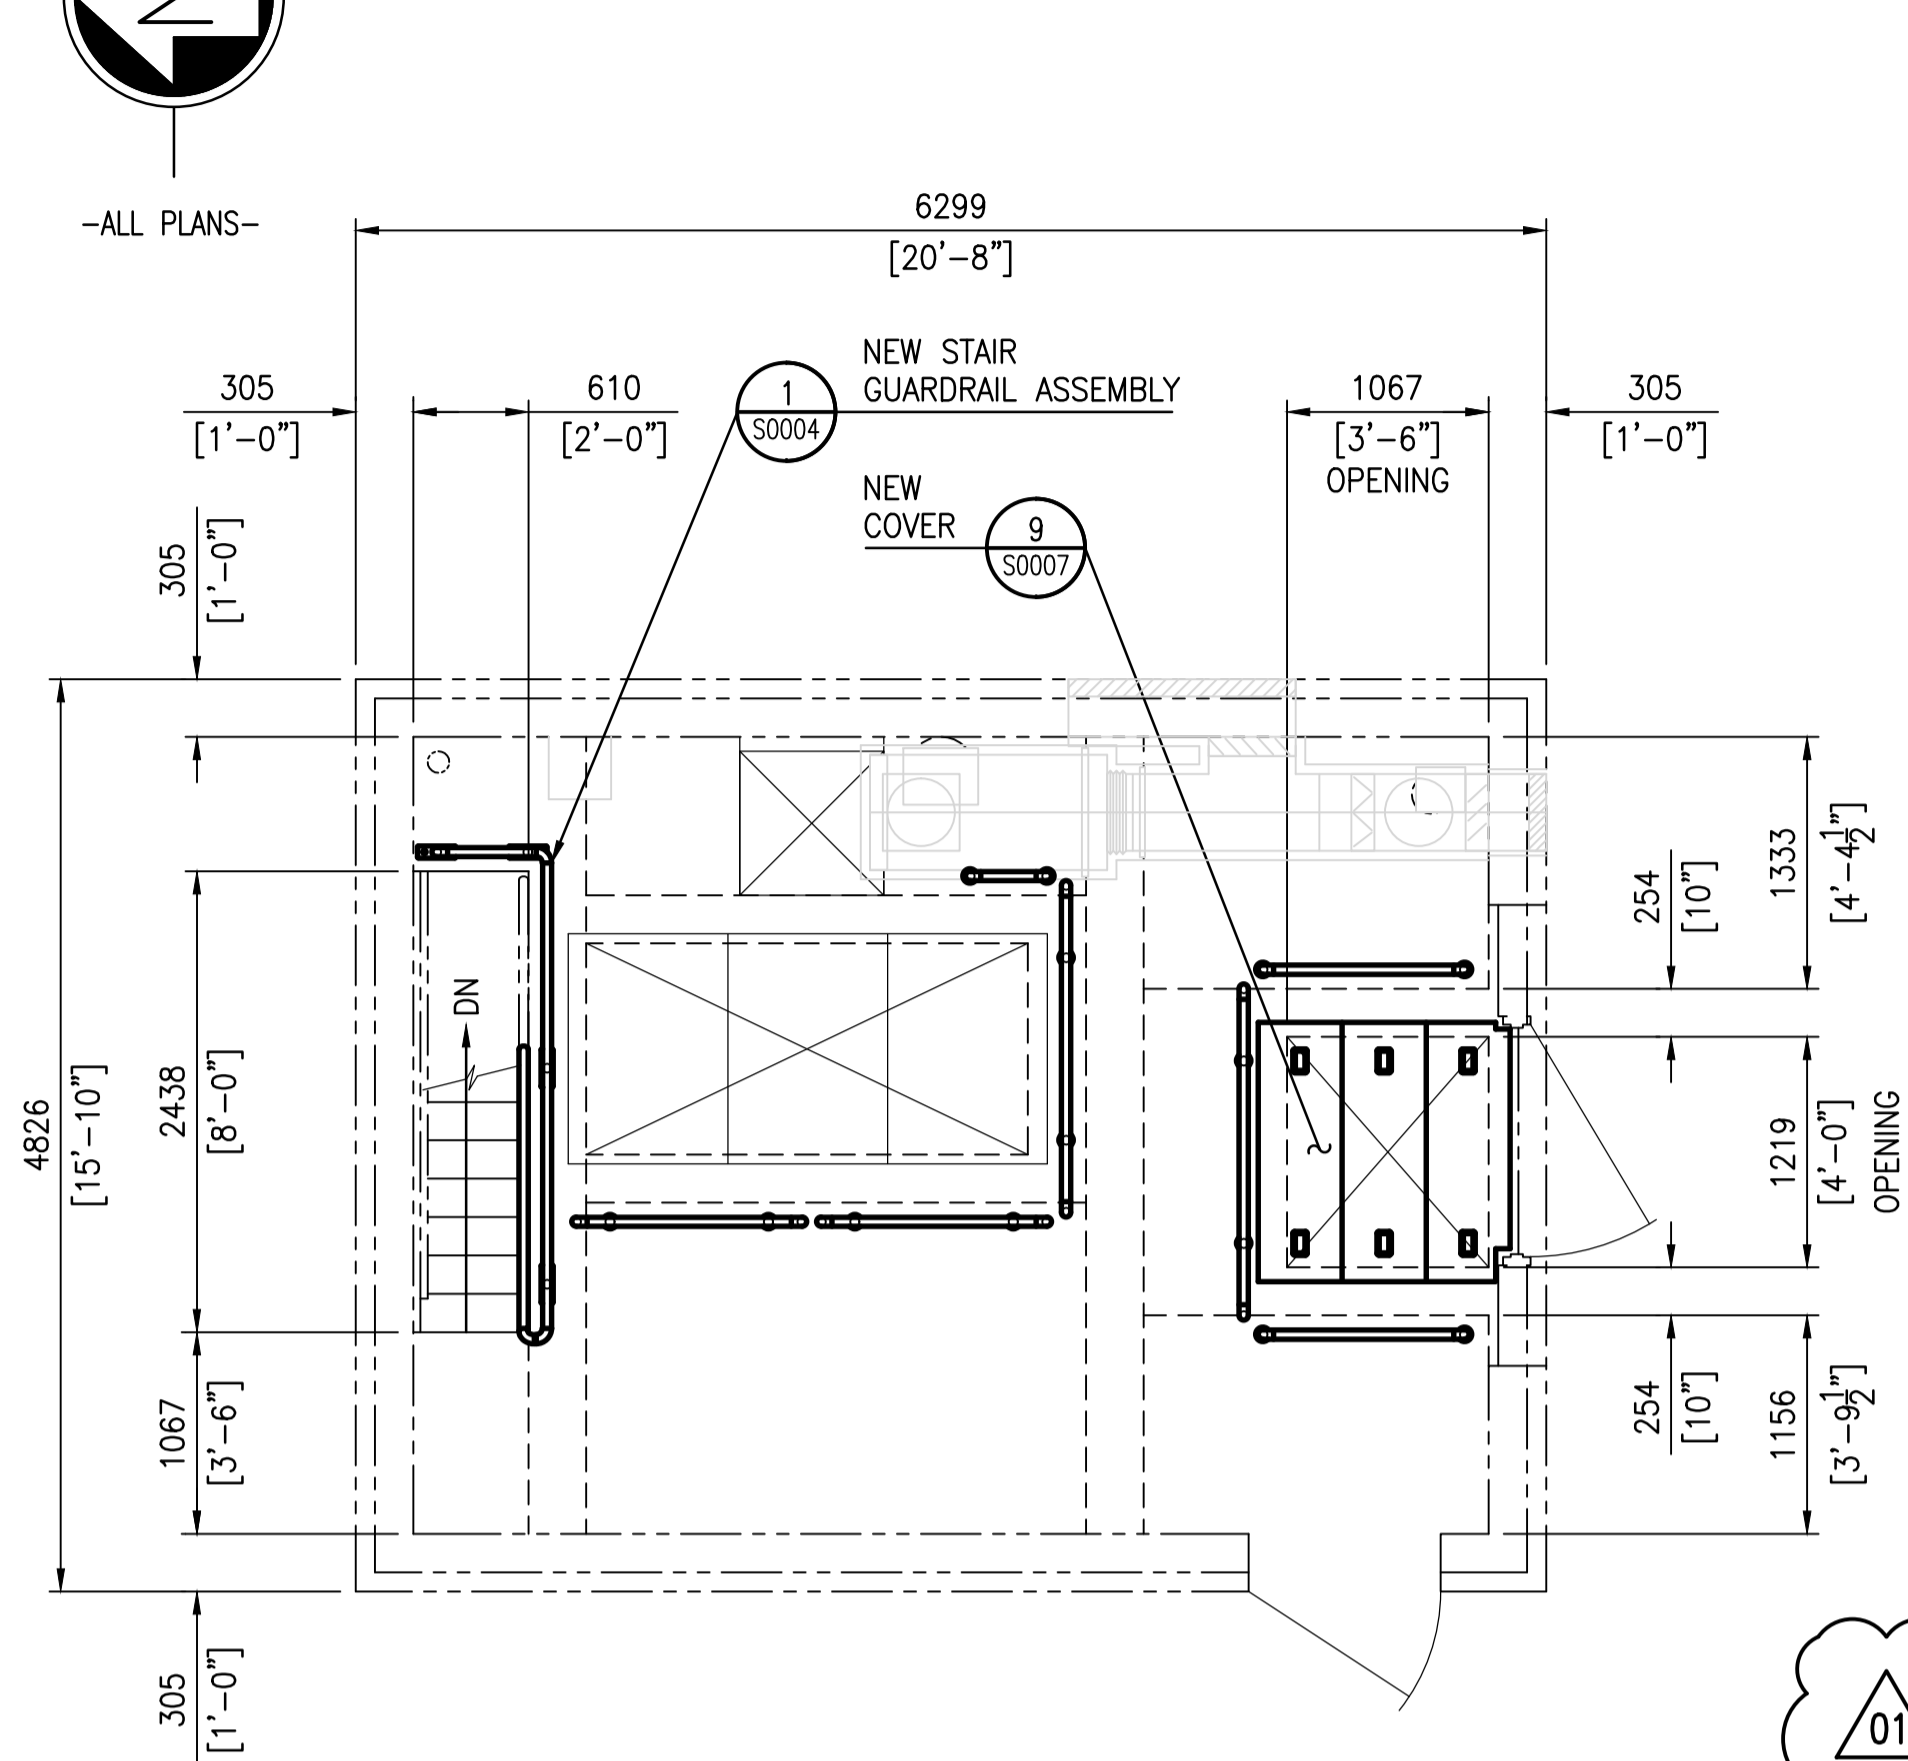


PLAN @ T.O.C. EL. 232.715 (763'-6")
SCALE: 1 : 40

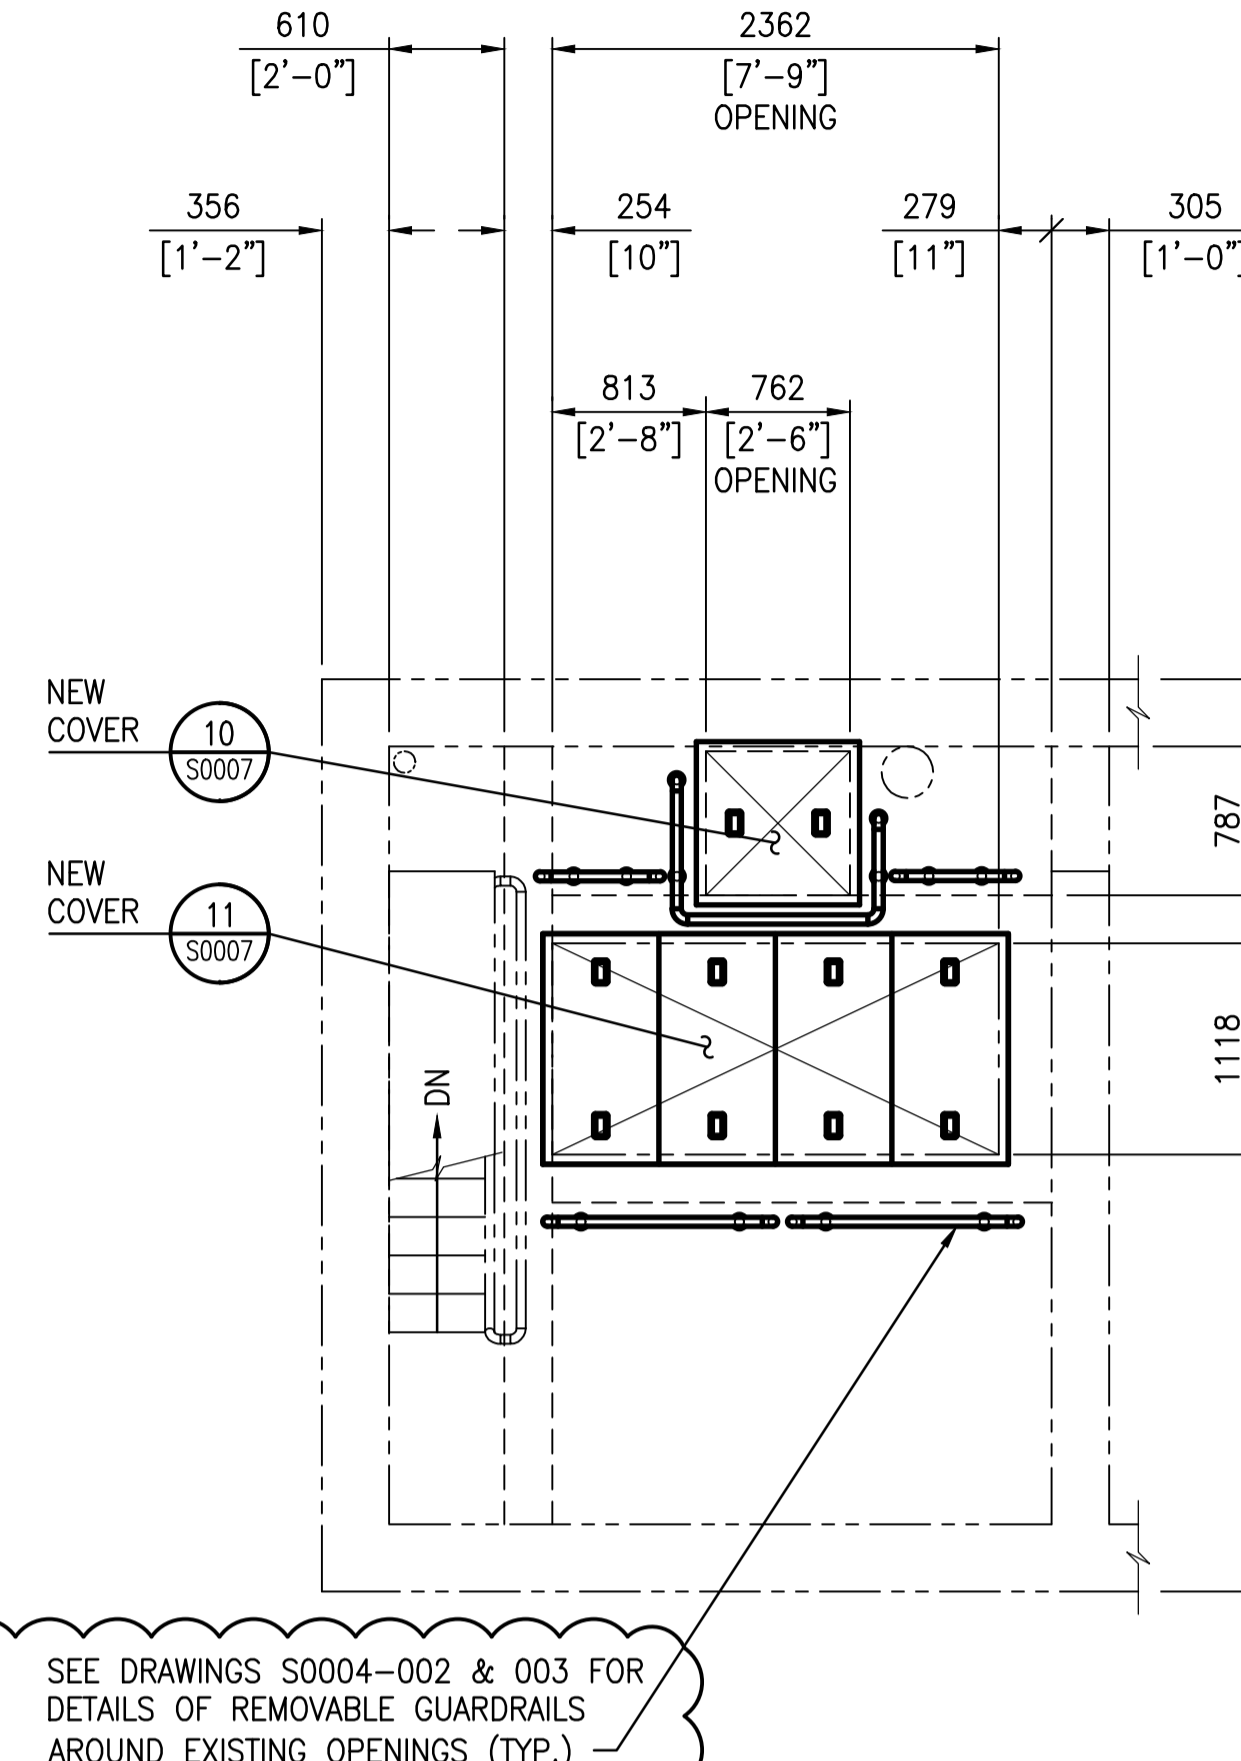

PARTIAL PLAN @ T.O.C. EL. 230.715 (755'-2")
SCALE: 1 : 40

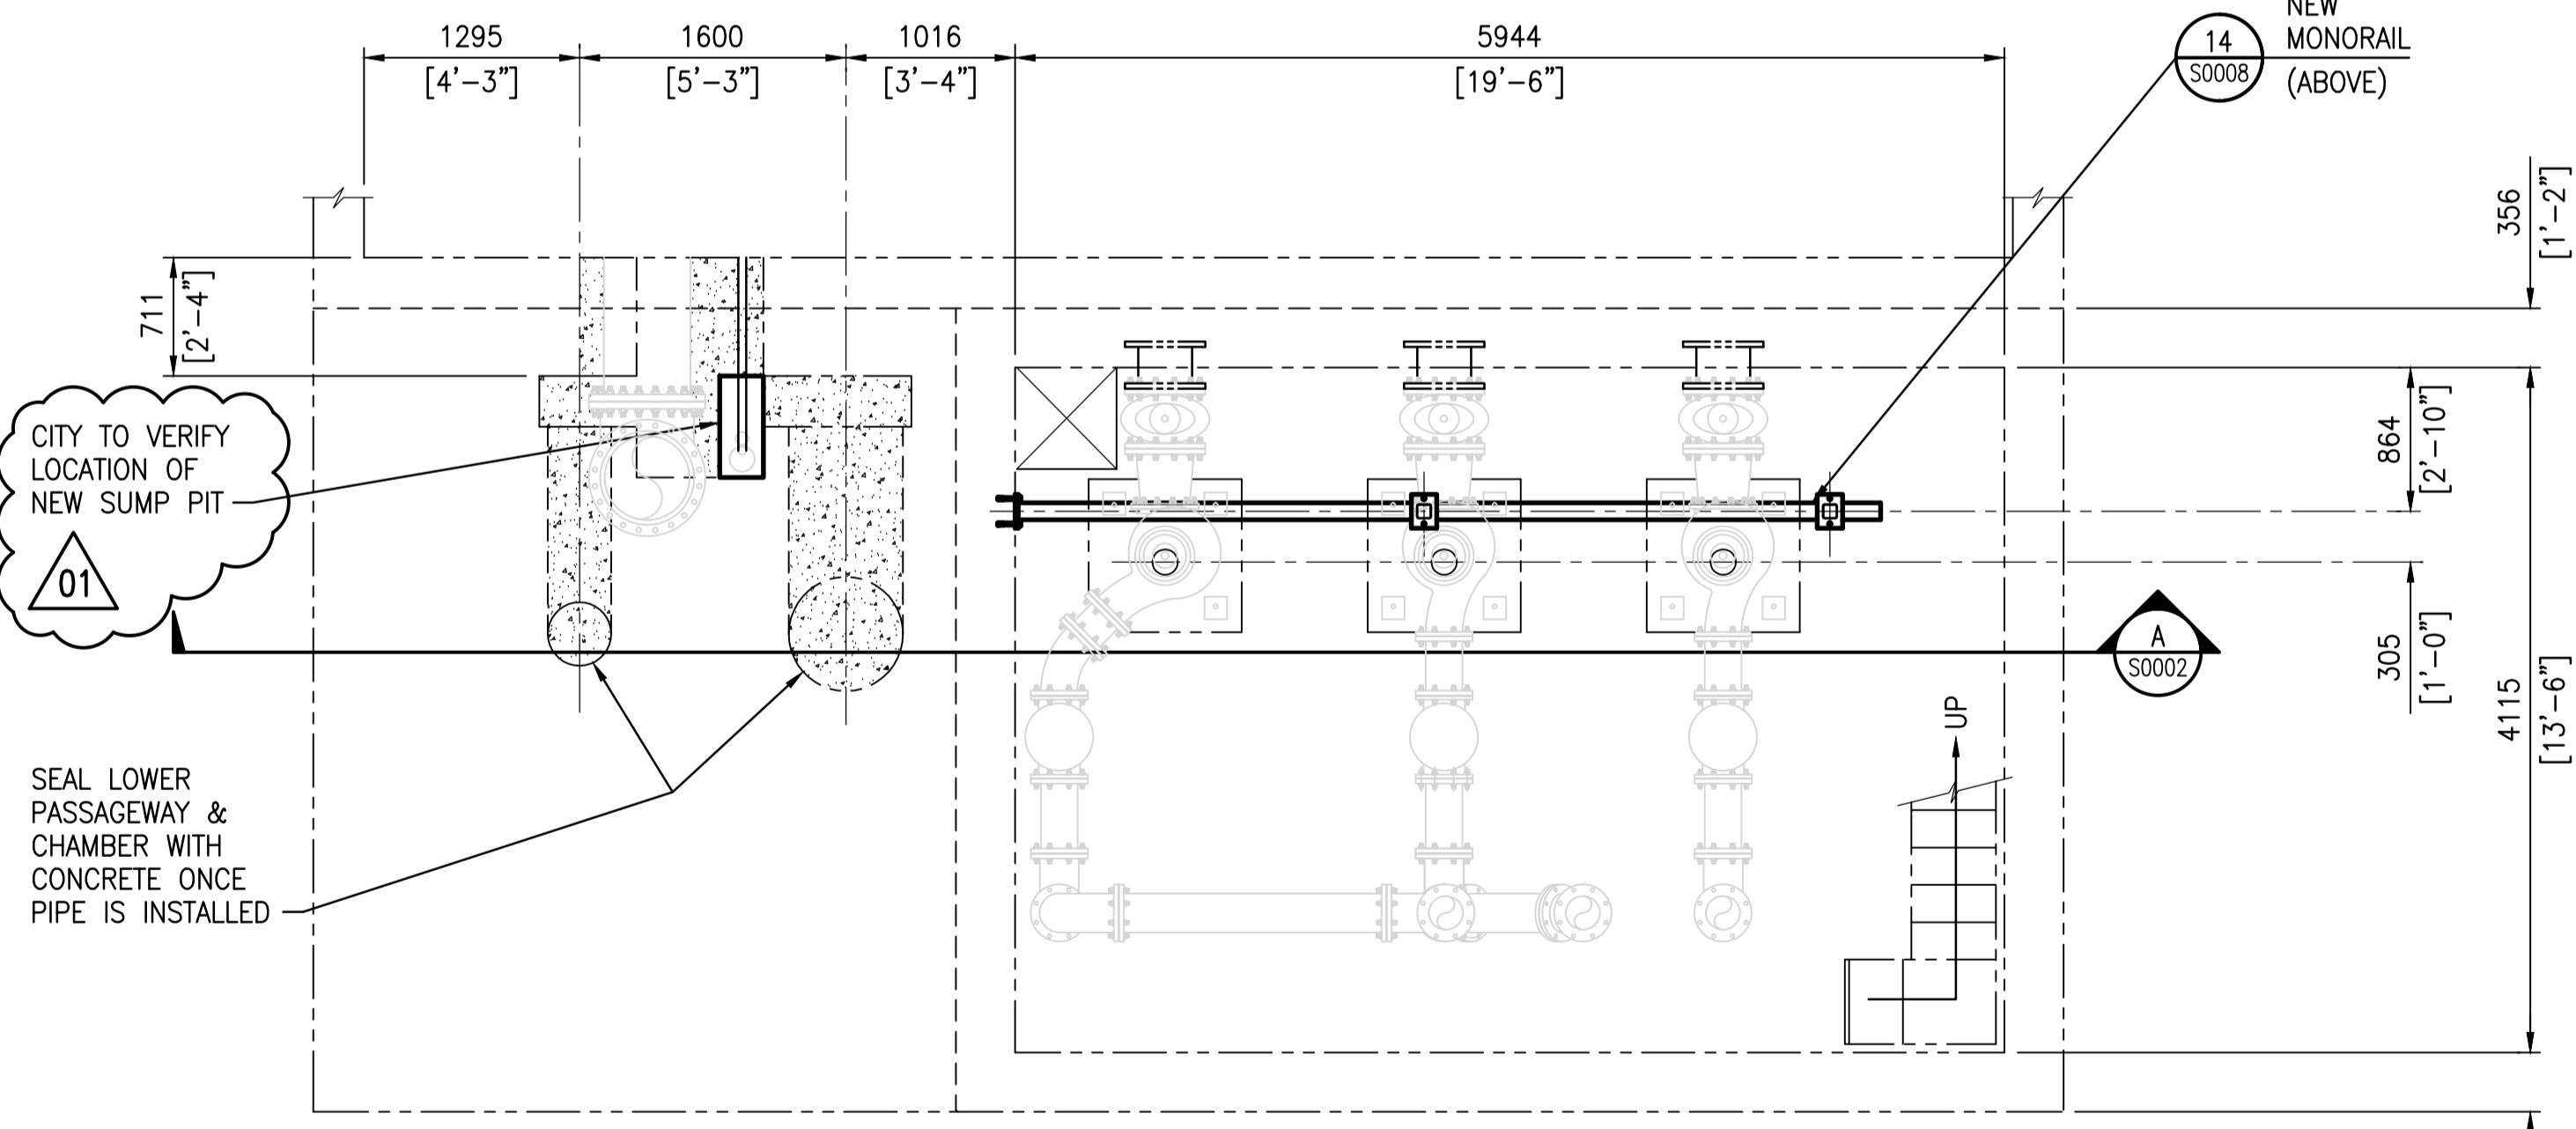

PLAN ABOVE EL. 224.269 (735'-9 1/2")
SCALE: 1 : 40

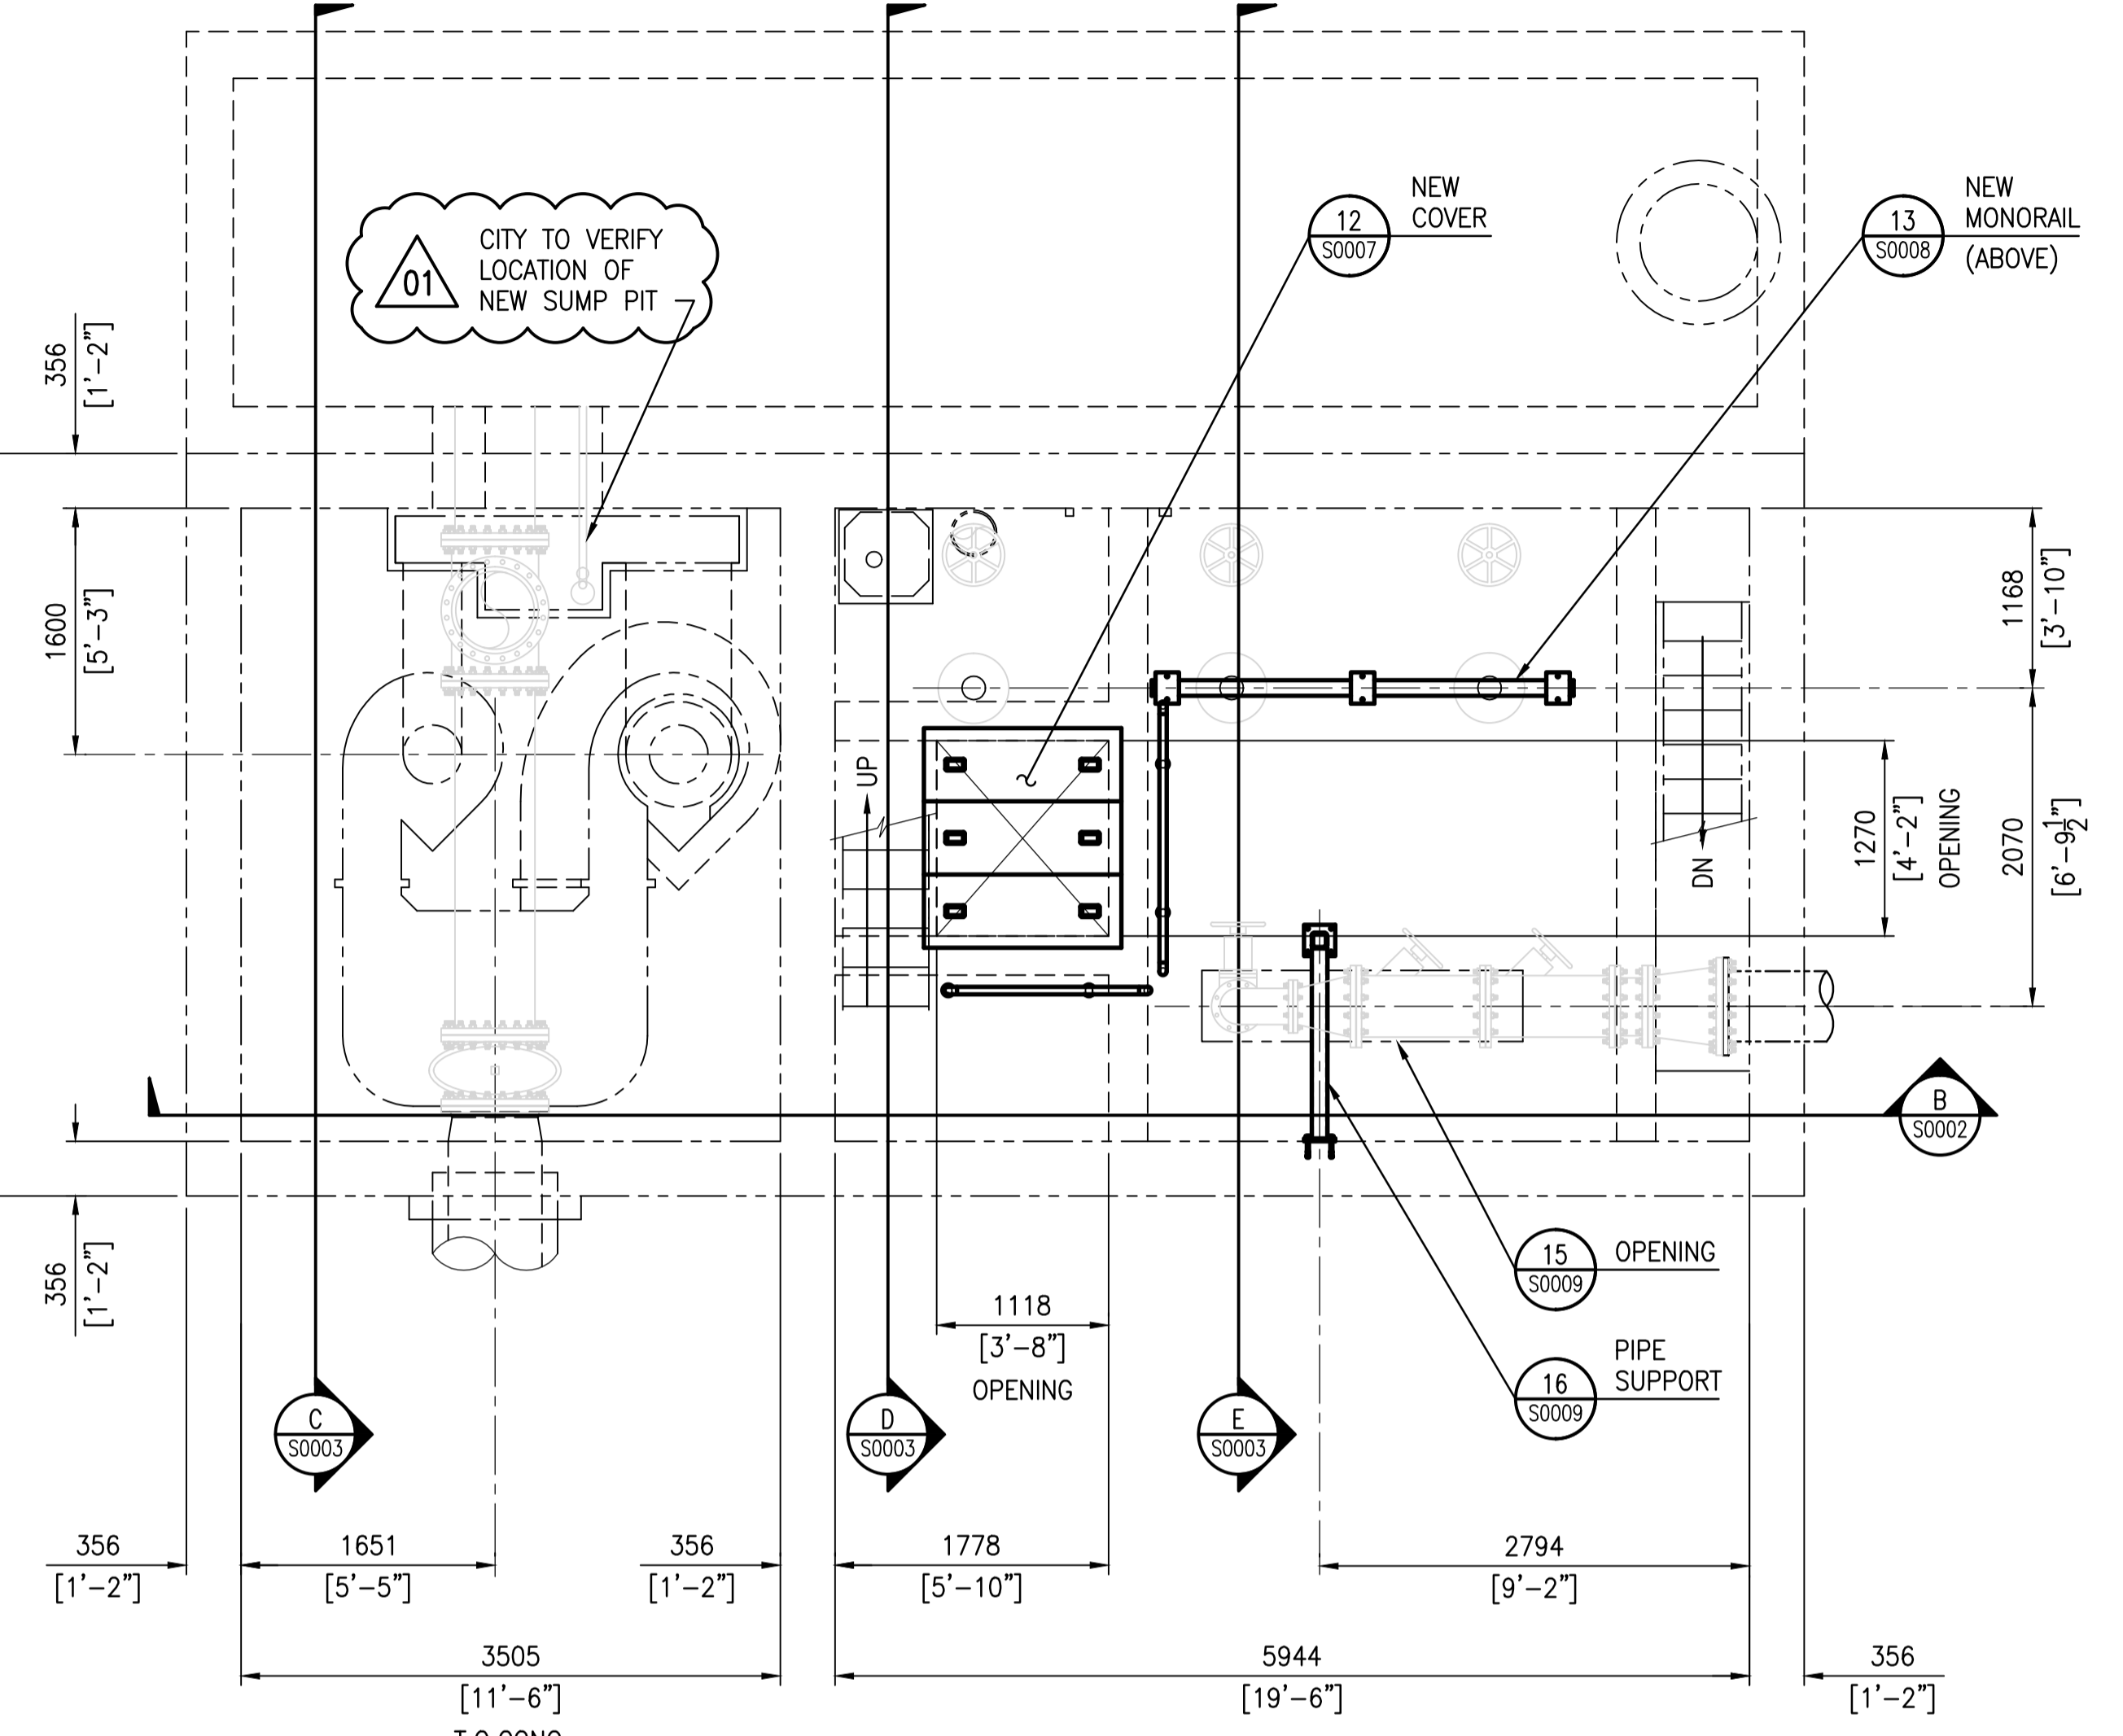

PLAN ABOVE EL. 227.635 (746'-10")
SCALE: 1 : 40


01 SEE DRAWINGS S0004-002 & 003 FOR DETAILS OF REMOVABLE GUARDRAILS AROUND EXISTING OPENINGS (TYP.)

SECTION ARROWS SHOWN TYPICAL ALL PLAN VIEWS

NOTES:

- SEE DRAWING 1-0169L-S0004 FOR GENERAL NOTES.
- SEE DRAWING 1-0169L-S0005 FOR STRUCTURAL NOTES.

DRAWING NUMBER	REFERENCE DRAWINGS
403-B	AINSLIE COMM. & PUMPING STATION - SUPERSTRUCTURE & DETAILS
403-A	AINSLIE COMM. & PUMPING STATION - REINFORCING DETAILS
403	AINSLIE COMM. & PUMPING STATION

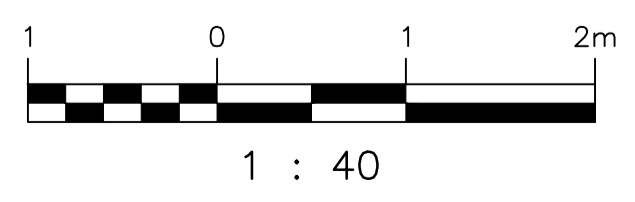

APEGM
Certificate of Authorization
SNC-Lavalin Inc.
No. 4489

NO.	REVISIONS	DATE	DESIGN	CHECK
01	ISSUED FOR ADDENDUM - G.RAILS / SUMP ADDED	2015/09/28	K.K.	
00	ISSUED FOR TENDER	2015/09/17	K.K.	

DESIGNED BY: K. KOTYK	CHECKED BY: D. COATES
DRAWN BY: B. DICKSON	APPROVED BY: I. PARKINSON
SCALE: 1:40	ISSUED FOR CONSTRUCTION BY: DATE: 2015/06/22
CONSULTANT NO.:	

ENGINEER'S SEAL
PRELIMINARY
NOT TO BE
USED FOR
CONSTRUCTION

THE CITY OF WINNIPEG
WATER AND WASTE DEPARTMENT
OLIVE WASTEWATER LIFT STATION
2015 UPGRADES
PLANS
STRUCTURAL MODIFICATIONS

CITY DRAWING NUMBER: 1-0169L-S0001
SHEET: 001
REV: 01
SIZE: A1