



**NOTES:**

- SEE DRAWING 1-0169L-S0004 FOR GENERAL NOTES.
- SEE DRAWING 1-0169L-S0005 FOR STRUCTURAL NOTES.

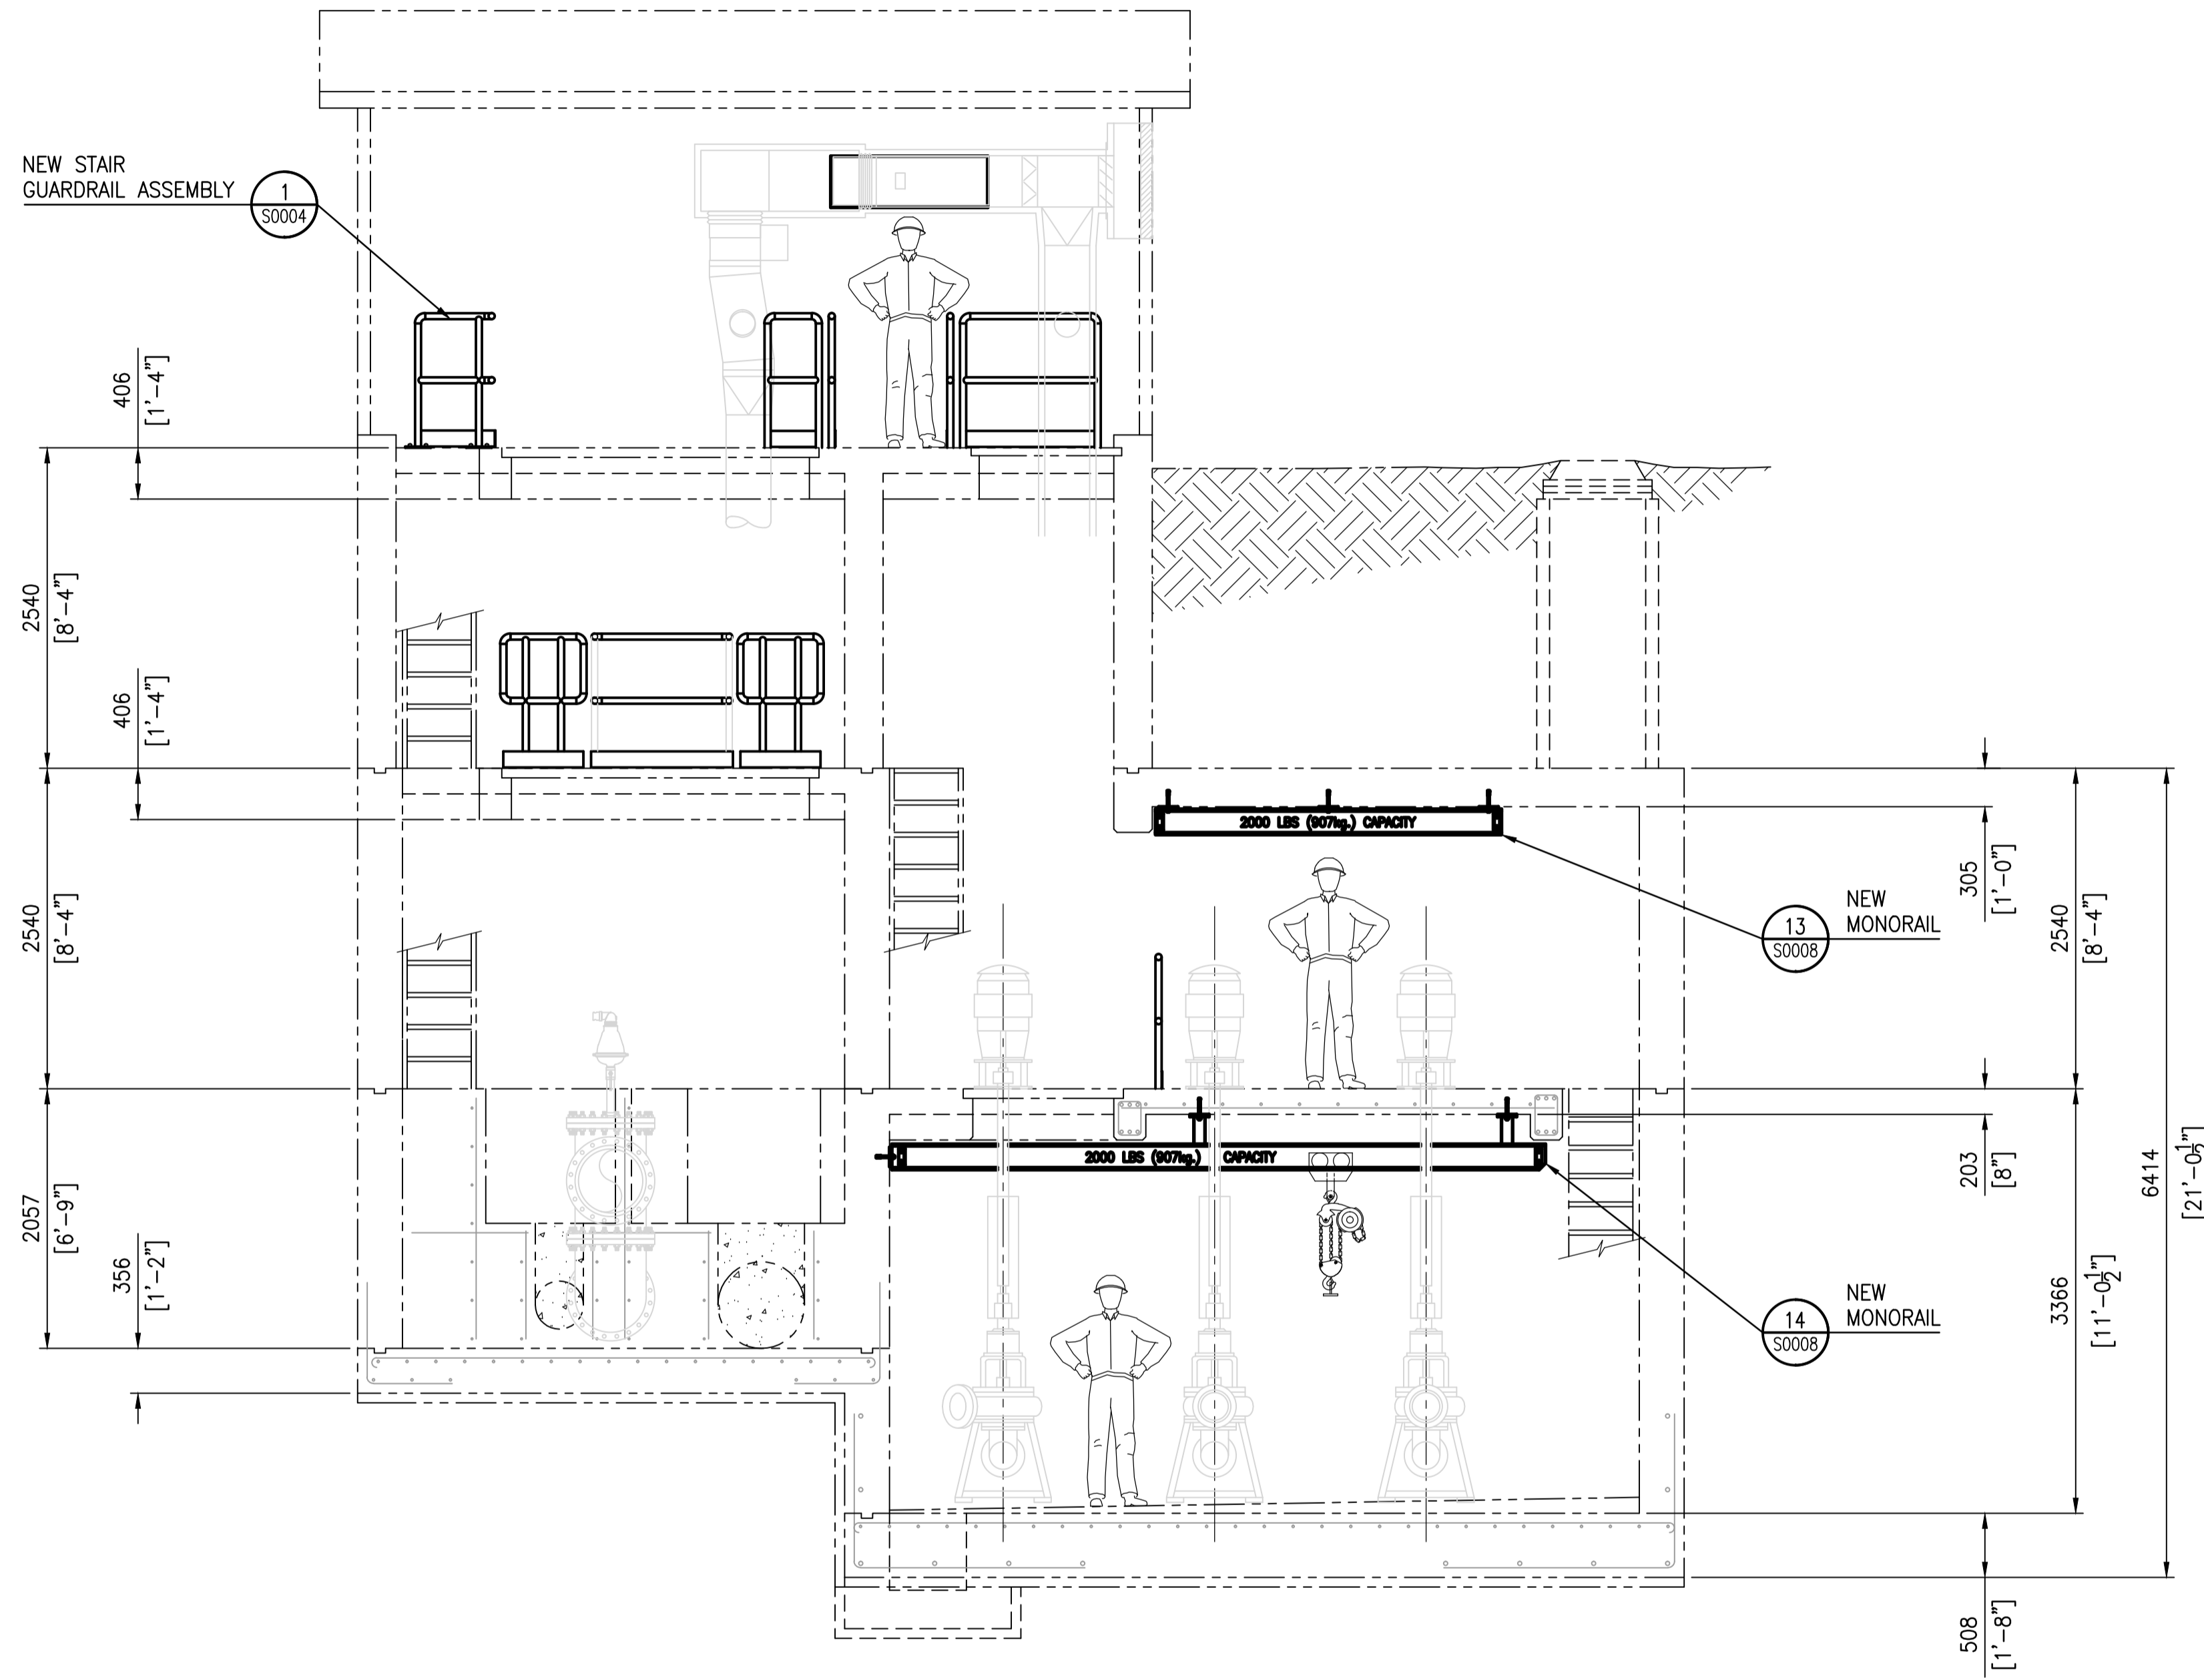


**A** ELEVATION  
 S0001 SCALE: 1 : 40

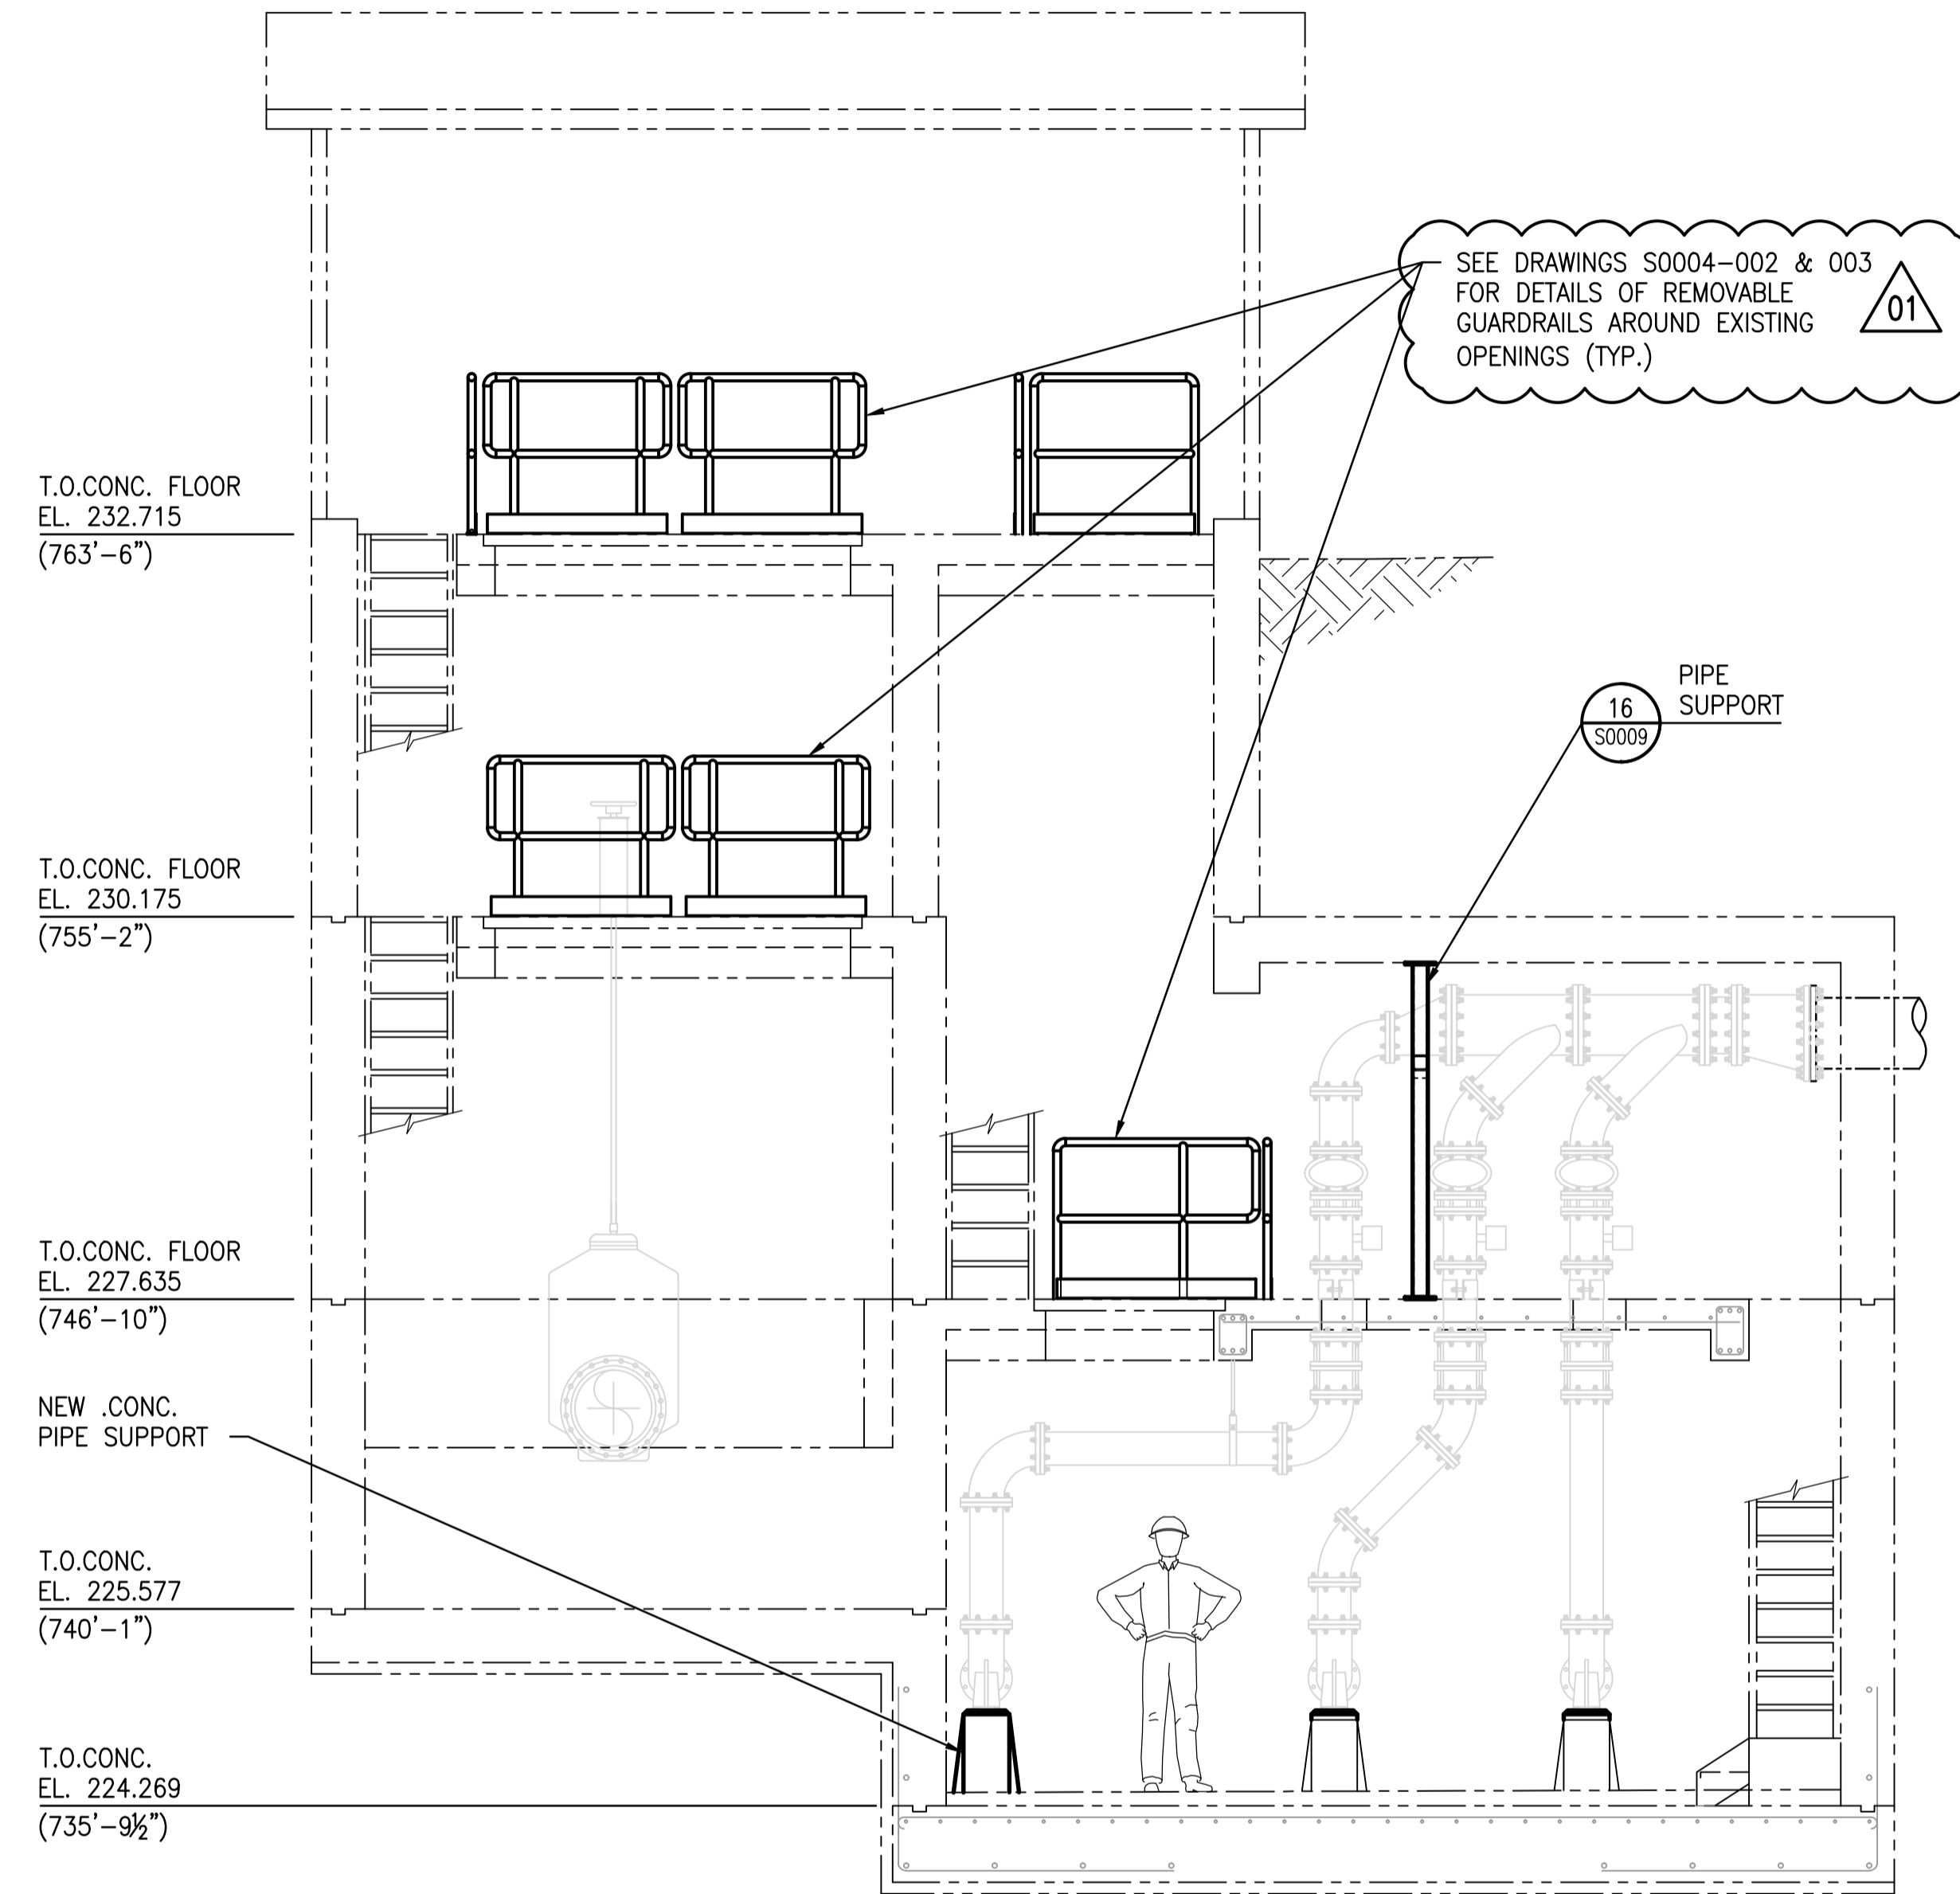

**B** ELEVATION  
 S0001 SCALE: 1 : 40



DRAWING NUMBER	REFERENCE DRAWINGS
403-B	AINSLIE COMM. & PUMPING STATION - SUPERSTRUCTURE & DETAILS
403-A	AINSLIE COMM. & PUMPING STATION - REINFORCING DETAILS
403	AINSLIE COMM. & PUMPING STATION

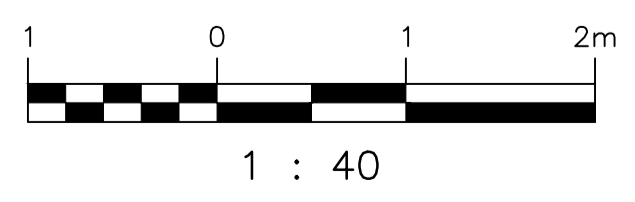

NO.	REVISIONS	DATE	DESIGN	CHECK
01	ISSUED FOR ADDENDUM - GUARDRAILS ADDED	2015/09/28	K.K.	
00	ISSUED FOR TENDER	2015/09/17	K.K.	

SNC-Lavalin Inc. 148 Nature Park Way Winnipeg, MB, Canada R3P 0X7 204-786-8080	
DESIGNED BY: K. KOTYK	CHECKED BY: D. COATES
DRAWN BY: B. DICKSON	APPROVED BY: I. PARKINSON
SCALE: 1:40	ISSUED FOR CONSTRUCTION BY:
DATE: 2015/06/22	DATE:
CONSULTANT NO.:	

ENGINEER'S SEAL  
**PRELIMINARY**  
 NOT TO BE  
 USED FOR  
 CONSTRUCTION

**THE CITY OF WINNIPEG**  
 WATER AND WASTE DEPARTMENT

OLIVE WASTEWATER LIFT STATION  
 2015 UPGRADES  
 ELEVATIONS  
 STRUCTURAL MODIFICATIONS

CITY DRAWING NUMBER	SHEET	REV.	SIZE
1-0169L-S0002	001	01	A1