

1 MAIN FLOOR CONSTRUCTION PLAN
A-102 1:100


GENERAL NOTES

1. ALL INTERIOR WALLS TO EXTEND TO U/S OF STRUCTURE UNLESS OTHERWISE NOTED.
2. PROVIDE WATER RESISTANT GYPSUM BOARD (IN LIEU OF GYPSUM BOARD INDICATED IN WALL TYPES) FULL LENGTH OF PLUMBING FIXTURE WALLS AND MIN. 1000mm WIDTH ON ADJACENT WALLS. ENSURE WALL BOARD IS TYPE X IF SPECIFIED IN WALL TYPES.
3. 19mm PLYWOOD BACKERBOARD AT WALL MOUNTED ELECTRICAL EQUIPMENT IN MECH/ELEC. ROOM 107. COORDINATE WITH ELEC.
4. REFER TO CRAWL SPACE PLAN 1/A101 FOR CLEAR OPENING DIMENSIONS THROUGH LEVEL 100 FLOOR ASSEMBLIES. COORDINATE LOCATIONS WITH LEVEL 100 FLOOR PLAN AND STRUCT.
5. COORDINATE MECHANICAL AND ELECTRICAL WITH STRUCTURE AND ADJUST FURRING AS REQUIRED IN CONJUNCTION WITH ARCHITECT.
6. FOR MOUNTING HEIGHTS OF ALL MISCELLANEOUS SURFACE MOUNTED ACCESSORIES/ EQUIPMENT, REFER TO SPEC SECTION 10 06 22.
7. INSTALL WOOD BLOCKING IN WALL BEHIND ALL SURFACE MOUNTED EQUIPMENT AND ACCESSORIES (I.E. GRAB BARS, ETC).
8. ALL DOOR FRAMES TO BE OFFSET 100mm FROM FRAME EDGE TO WALL FACE UNLESS OTHERWISE NOTED.

KEYED NOTES

1. PREFABRICATED RATED CRAWL SPACE ACCESS HATCH C/W FIXED LADDER AND TELESCOPIC SAFETY POLE. RATING TO MATCH THAT OF FLOOR ASSEMBLY. REFER TO 1/A-101 FOR SIZES AND DTL. 3/A101.
2. WATER FOUNTAIN WITH RECESSED BOTTLE FILL STATION. REFER TO INTERIOR ELEVATIONS AND MECH.
3. PROVIDE FLOOR DRAIN. REFER TO MECH.
4. SELF CHECK-IN UNITS FOR AUTOMATED BOOK SORTER - NIC. COORDINATE FINAL SIZES, HEIGHTS, AND LOCATIONS OF OPENINGS IN WALL WITH OWNER PRIOR TO CONSTRUCTION.
5. HOT WATER TANK MOUNTED AT HIGH LEVEL. REFER TO MECH.
6. DOMESTIC WATER CONNECTION C/W WATER METER COORDINATE LOCATION WITH MECH.
7. ROOF ACCESS HATCH ABOVE C/W FIXED LADDER AND TELESCOPIC SAFETY POLE.
8. AUTOMATED BOOK SORTER UNIT N.I.C.
9. FIRE ALARM ANNUNCIATOR PANEL. REFER TO ELEC.
10. ENTRY SLAB. REFER TO CIVIL, LANDSCAPE, AND STRUCT. COORDINATE WITH LANDSCAPE PLANS.
11. LIVING WALL - REFER TO SECTION 09 77 53 & WALL SECTION 1/A-305.
12. PRINTER N.I.C.
13. EXTERIOR FENCED MECH. EQUIP. ENCLOSURE ON CONC. SLAB C/W LOCKABLE GATES.
14. RECESSED FLOOR RECEPTACLES CENTRE ON COLUMN OR CURTAIN WALL GLAZING AS SHOWN. REFER TO ELEC.
15. RECESSED FLOOR RECEPTACLES. REFER TO PLAN DETAILS FOR LOCATIONS.
16. LOCATION OF RECESSED FLOOR RECEPTACLE FOR POWERED FURNITURE. REFER TO ELEC. FINAL LOCATION TO BE REVIEWED BY CONTRACT ADMINISTRATOR PRIOR TO INSTALLATION.
17. LINE OF FLOORING TRANSITION TO ALIGN WITH CENTRE LINE OF CURTAIN WALL MULLION.
18. DOOR GUARDS. REFER TO DETAIL.
19. WALL MOUNTED DISPLAY MONITOR.
20. AUTOMATIC SLIDING DOOR. REFER TO DOOR SCHEDULE AND SPECIFICATION.
21. RECEPTACLES MOUNTED IN MILLWORK. REFER TO MILLWORK DETAILS.
22. SERVER RACK - REFER TO ELEC.
23. FROST BOX - REFER TO MECH.

2	2017.03.10	ISSUED FOR ADDENDUM #1
1	2017.02.17	ISSUED FOR CONSTRUCTION
No.	DATE	REVISION / ISSUANCE

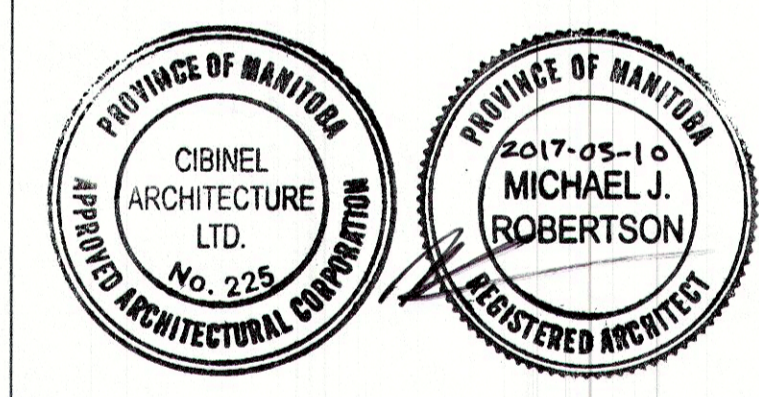

Cibinel
Architecture Ltd
560 ACADEMY ROAD, WINNIPEG, MB R3N 0E3



TRANSCONA LIBRARY
1500 PLESSIS ROAD, WINNIPEG, MB

MAIN FLOOR CONSTRUCTION PLAN & NOTES

1487 **A-102**