


**1 FURNITURE PLAN**  
A-102 1:100

**GENERAL NOTES**

1. ALL FURNITURE SHOWN IS FOR COORDINATION PURPOSES ONLY.

2	2017.03.10	ISSUED FOR ADDENDUM #1
1	2017.02.17	ISSUED FOR CONSTRUCTION
No.	DATE	REVISION / ISSUANCE

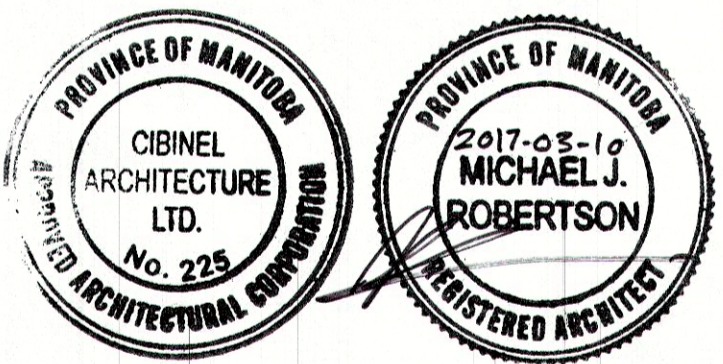

Architect

**Cibinel**  
Architecture Ltd.

420 A STRADBROOK AVE. WINNIPEG, MB R3L 0J8  
T. 204 989 8910 F. 204 989 8920

Owner



Project

**TRANSCONA LIBRARY**  
1500 PLESSIS ROAD, WINNIPEG, MB

Sheet Title

**FURNITURE /  
FINISHES PLAN**

Project No.

1487

Sheet

**A-600**