

EMERGENCY CALL SYSTEM EQUIPMENT LIST				
ITEM NO.	DESCRIPTION			
1	DOME LIGHT C/W BUILT-IN BUZZER/HORN C/W TRANSLUCENT WHITE PLASTIC COVER MOUNTED ON WHITE ABS FLAME RETARDANT PLASTIC PANEL.			
2	120VAC/12-24VDC LOW VOLTAGE TRANSFORMER			
3	PULL CORD STATION C/W WHITE ABS FLAME RETARDANT PLASTIC HOUSING C/W "EMERGENCY" IN BLACK LETTERS C/W RED "CALL PLACED" INDICATOR			
4	ONE (1) 2/C-18AWG FT6/FT4 WIRING IN CONDUIT			


### **GENERAL NOTES**

EMERGENCY CALL SYSTEM SHALL BE EQUAL TO ALPHA COMMUNICATIONS MODEL# EK117B.
 CONFIRM ALL REQUIREMENTS AND WIRING TYPES WITH SYSTEM VENDOR PRIOR TO INSTALLATION.

#### KEY NOTES #


1. LOW VOLTAGE TRANSFORMER SHALL BE MOUNTED IN ACCESSIBLE CEILING SPACE NEAR WASHROOM DOOR. CONFIRM LOCATION ON SITE.



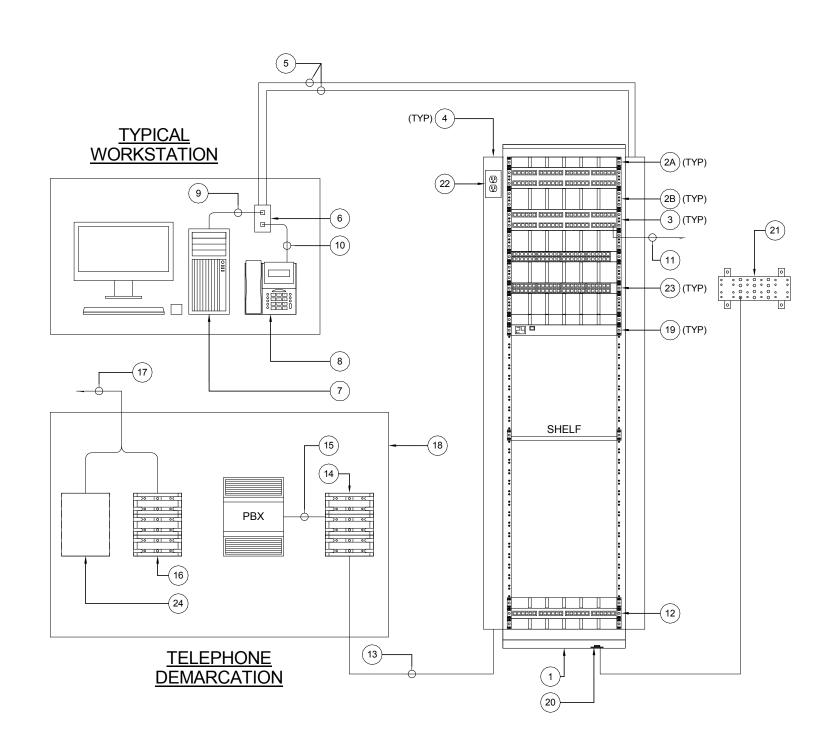

EQUIPMENT LIST				
1	45U 2135mm (84") 2-POST RELAY RACK			
(2A)	1U HORIZONTAL WIRE MANAGEMENT			
(2B)	2U HORIZONTAL WIRE MANAGEMENT			
3	2U HORIZONTAL CABLING PATCH PANEL - 48 PORT			
4	101mm (4") VERTICAL WIRE MANAGEMENT			
5	WORKSTATION HORIZONTAL CABLING			
6	COMMUNICATION OUTLET			
7	COMPUTER - (NIC)			
8	TELEPHONE - (NIC)			
9	WORK AREA CORD - REFER TO SPECIFICATIONS			
10	TELEPHONE LINE CORD - (NIC)			
(11)	PATCH CORD - REFER TO SPECIFICATIONS			
(12)	1U ANALOGUE PATCH PANEL - CAT 3, 24 PORT			
(13)	CAT3 TO BIX FIELD - 1 x 25 PAIR			
14)	PBX OUTPUT - BIX WALL MOUNTED			
15)	CROSS CONNECT TO PBX - (NIC)			
16)	TELECOMMUNICATION SUPPLIER DEMARC - (NIC)			
17)	TELECOMMUNICATION BUILDING ENTRANCE CONDUIT			
(18)	1200mm x 1200mm x 19mm (4'-0" x 4'-0" x 3/4") G1S PLYWOOD BACKBOARD. PAINT TO MATCH ROOM			
19	1U RACK MOUNTED METERED PDU C/W 5-20R RCPT			
20	GROUND LUG C/W MINIMUM #6 AWG GREEN GROUND TO TGB			
21)	TELECOMMUNICATION GROUNDING BUSS BAR (TGB). GROUND BUSS TO EIA/TIA607. 6mm (1/4") THICK BY 101mm (4") WIDE, MOUNTED ON STANDOFF INSULATORS C/W MINIMUM #3/0 AWG TO MAIN BUILDING GROUND			
22	120V, NEMA 5-20R RCPT ON DEDICATED CIRCUIT MOUNTED TO REAR OF RACK.			
23)	NETWORK SWITCH - (NIC)			
24)	TELLECOMMUNICATION SUPPLIER FIBRE DEMARC - (NIC)			



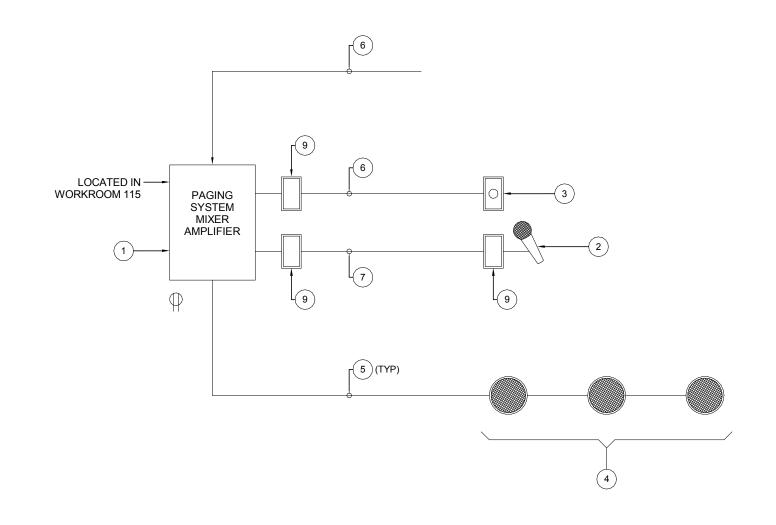

# PAGING SYSTEM RISER DIAGRAM


ITEM NO.	DESCRIPTION
1	PAGING SYSTEM MIXER/AMPLIFIER
2	DESK MOUNTED PAGING MICROPHONE
3	REMOTE VOLUME CONTROL
4	PAGING SPEAKER
5	2/C #18AWG FT6/FT4 IN CONDUIT
6	3/C #18AWG FT6/FT4 IN CONDUIT
7	3/C #22AWG-SHIELDED FT6/FT4 IN CONDUIT
8	INPUT FROM AUDIO/MUSIC EQUIPMENT (NIC)
9	WALL INPUT/OUTPUT PATCH PLATE

PAGING SYSTEM ZONE LISTING				
ZONE	LOCATION			
Z01	ALL CALL			
Z02	MULTI-PURPOSE 102			

### **GENERAL NOTES**

- ALL WIRING SHALL BE INSTALLED WITHOUT JOINTS OR SPLICES FROM DEVICE TO DEVICE, OR TO THE HEAD-END EQUIPMENT.
- FINISHES OF ALL SPEAKERS SHALL BE WHITE.
  ALL EXPOSED WIRING SHALL BE WIRE IN CONDUIT.
- PROVIDE PATCH CABLES AS REQUIRED. MINIMUM LENGTH SHALL BE 1825mm(6'-0").

INTRUSION ALARM EQUIPMENT LIST			
1	MOTION DETECTOR		
2	ALARM AUDIBLE NOTIFICATION DEVICE		
3	DOOR CONTACT		
4	ARMING STATION		

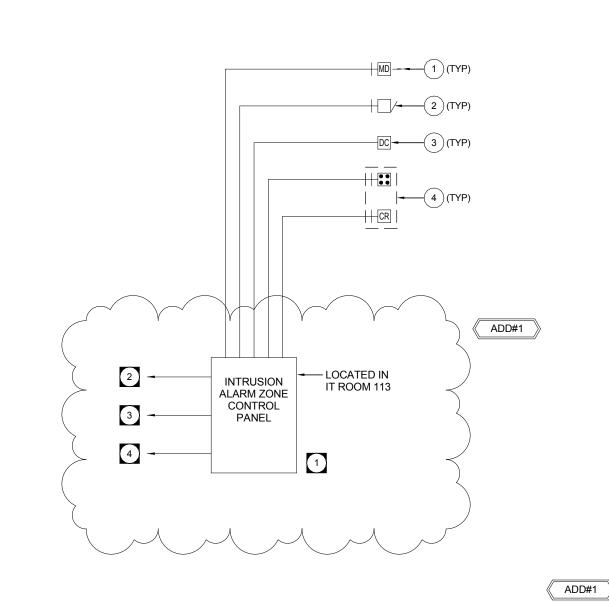

INTRUSION ALARM RISER DIAGRAM E5.2 SCALE: NTS

INTRUSION ALARM ZONE LISTING					
ZONE	LOCATION	DEVICE			
DC1	MAIN LIBRARY 101 - SW EXTERIOR DOOR	DOOR CONTACT			
DC2	VESTIBULE 100 - EXTERIOR DOOR	DOOR CONTACTS			
DC3	VESTIBULE 100 - INTERIOR DOOR	DOOR CONTACTS			
DC4	MECH/ELECT 117 - EXTERIOR DOOR	DOOR CONTACT			
WC1	WORKROOM 115 - OPERABLE WINDOWS	WINDOW CONTACT			
MD1	MAIN LIBRARY 101 - #01	MOTION DETECTOR			
MD2	MAIN LIBRARY 101 - #02	MOTION DETECTOR			
MD3	MAIN LIBRARY 101 - #03	MOTION DETECTOR			
MD4	MAIN LIBRARY 101 - #04	MOTION DETECTOR			
MD5	MULTI-PURPOSE 102	MOTION DETECTOR			
MD6	VESTIBULE 100	MOTION DETECTOR			
MD7	WORKROOM 115	MOTION DETECTOR			
MD8	STAFFROOM 116	MOTION DETECTOR			
MD9	M & E ROOM 117	MOTION DETECTOR			
HW1	SUMP PUMPS (P-3, P-4) DUPLEX CONTROLLER OUTPUT	HIGH WATER			
BF1	BOILER B-1 ALARM SENSOR BOILER CONTROL PANEL OUTPUT	FAILURE			
BF2	BOILER B-2 ALARM SENSOR BOILER CONTROL PANEL OUTPUT	FAILURE			

#### **GENERAL NOTES**

- INTRUSION ALARM SYSTEM SHALL BE BASED ON BOSCH B SERIES INTRUSION SYSTEM.
   ALL WIRING SHALL BE RUN IN CONDUIT UNLESS NOTED OTHERWISE. UTILIZE J-HOOKS IN ACCESSIBLE CEILING SPACE ONLY.
   DAISY CHAINING OF DEVICES NOT PERMITTED. ALL DEVICES SHALL BE HOME RUN TO THE HEAD END LOCATION.
   ALL WIRING SHALL BE FT6/FT4 IN CONDUIT.
   MONITORING OF INTRUSION ALARM SYSTEM SHALL BE DONE BY MUNICIPAL ACCOMMODATIONS LOCATED AT CITY HALL CENTRAL CONTROL OFFICE.

## KEY NOTES #

- 1. INTRUSION SYSTEM SHALL BE PROGRAMMED/PARTITIONED SUCH THAT M & E 117 CAN BE
- ARMED/DISARMED INDEPENDENT OF THE REMAINING BUILDING. 2. PROVIDE AN OUTPUT (DRY CONTACT) TO LIGHTING CONTROL RELAYS TO OVERRIDE-OFF LIGHTING
- WITHIN MAIN LIBRARY 101 ONLY.
- 3. PROVIDE A NETWORK OUTPUT TO THE LAN FOR CONNECTION AND MONITORING THROUGH CITY HALL CENTRAL CONTROL OFFICE.
- 4. PROVIDE A NETWORK OUTPUT TO THE LAN FOR CONNECTION AND MONITORING THROUGH CITY OF WINNIPEG BAS JOHNSON METASYS SYSTEM.

· A · R · C · H · I · T · E · C · T

epp siepman engineering inc.

O 16-03-31 Issued for Construction

THIS DRAWING IS THE EXCLUSIVE PROPERTY OF HS ARCHITECTURE AND DAVID PENNER ARCHITECT AND MAY NOT BE REPRODUCED AND/OR USED IN ANY MANNER WITHOUT THEIR EXPRESSED WRITTEN PERMISSION. THE GENERAL CONTRACTOR AND MATERIALS SUPPLIER/S SHALL CHECK ALL DIMENSIONS AND INFORMATION ON THIS DRAWING AND REPORT ANY DISCREPANCIES PRIOR TO COMMENCEMENT OF WORK. DO NOT SCALE THIS DRAWING.

CITY OF WINNIPEG - PLANNING, PROPERTY & DEVELOPMENT DEPARTMENT MUNICIPAL ACCOMMODATIONS DIVISION 3rd FLOOR - 65 GARRY ST., WPG, R3C 4K4

p 204.453.1080 ese@eppsiepman.com

Issued with Addendum #1

mechanical & electrical engineers

303-100 Osborne St. South Winnipeg, MB R3L 1Y5

1 16-04-20

David Penner, 204.475.8978 Helio Rodrigues, 204.774.0012 20 Yale Avenue, Winnipeg, MB, R3M 0L7

Windsor Park Library

ADDRESS

niscellaneous riser diagrams **E5.2**