



ACCES	ACCESS CONTROL EQUIPMENT LIST	
1	ACCESS CONTROL PANEL / DOOR CONTROLLER - 2 DOORS	
2	DOOR CONTROLLER - UP TO 2 DOORS	
3	PROXIMITY READER ON NON-SECURE SIDE	
4	DOOR CONTACT	
5	ELECTRIC STRIKE - BY DOOR HARDWARE SUPPLIER	
6	MAGNETIC LOCK - BY DOOR HARDWARE SUPPLIER	
7	REQUEST TO EXIT DETECTOR ON SECURE SIDE	

GENERAL NOTES

- ALL WIRING SHALL BE RUN IN CONDUIT UNLESS NOTED OTHERWISE. UTILIZE J-HOOKS IN ACCESSIBLE CEILING SPACE ONLY.
 DAISY CHAINING OF DEVICES NOT PERMITTED. ALL DEVICES SHALL BE HOME RUN TO THE HEAD END LOCATION.
- ALL WIRING SHALL BE FT6/FT4 IN CONDUIT.
- WHERE DOORS INCLUDE AUTOMATIC DOOR OPERATORS, IT IS THE ELECTRICAL SUB-CONTRACTORS RESPONSIBILITY TO COORDINATE THE INSTALLATION WITH THE GENERAL CONTRACTOR TO ENSURE DOORS ARE SEQUENCED PROPERLY WITH THE ACCESS CONTROL SYSTEM FOR PROPER FUNCTIONALITY. WIRE AND CONNECT ALL ASSOCIATED CONTROLS AS REQUIRED TO ACHIEVE THE PROPER SEQUENCING.

KEY NOTES

- 1. PROVIDE A NETWORK OUTPUT TO THE LAN FOR CONNECTION AND MONITORING THROUGH CITY OF WINNIPEG BAS JOHNSON METASYS SYSTEM.
- 2. PROVIDE AN OUTPUT TO THE INTRUSION ALARM SYSTEM FOR AC POWER FAILURE.
- 3. PROVIDE AN OUTPUT TO THE INTRUSION ALARM SYSTEM FOR PANEL TAMPER. PANEL TAMPER SHALL ALSO OUTPUT TO THE NETWORK CONTROLLER FOR BAS SYSTEM INTEGRATION.
- 4. PROVIDE A DEDICATED 120V/15A CIRCUIT FOR ACCESS CONTROL SYSTEM POWER SUPPLY. REFER TO DRAWINGS FOR CIRCUITING.

epp siepman engineering inc. mechanical & electrical engineers


303-100 Osborne St. South Winnipeg, MB R3L 1Y5 p 204.453.1080 ese@eppsiepman.com

1 16-04-20 Issued with Addendum #1 revision

THIS DRAWING IS THE EXCLUSIVE PROPERTY OF HS ARCHITECTURE AND DAVID PENNER ARCHITECT AND MAY NOT BE REPRODUCED AND/OR USED IN ANY MANNER WITHOUT THEIR EXPRESSED WRITTEN PERMISSION. THE GENERAL CONTRACTOR AND MATERIALS SUPPLIER/S SHALL CHECK ALL DIMENSIONS AND INFORMATION ON THIS DRAWING AND REPORT ANY DISCREPANCIES PRIOR TO COMMENCEMENT OF WORK. DO NOT SCALE THIS DRAWING.



CITY OF WINNIPEG - PLANNING, PROPERTY & DEVELOPMENT DEPARTMENT MUNICIPAL ACCOMMODATIONS DIVISION 3rd FLOOR - 65 GARRY ST., WPG, R3C 4K4

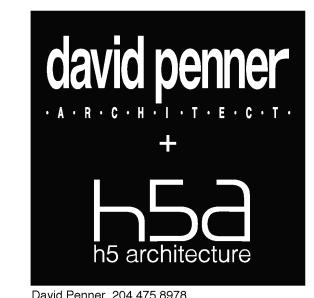

David Penner, 204.475.8978 Helio Rodrigues, 204.774.0012 120 Yale Avenue, Winnipeg, MB, R3M 0L7

Windsor Park Library ADDRESS

access control riser diagram **E5.4**