




plan detail
1 1/2"=1'-0"

3 plan detail 1/2"=1'-0"

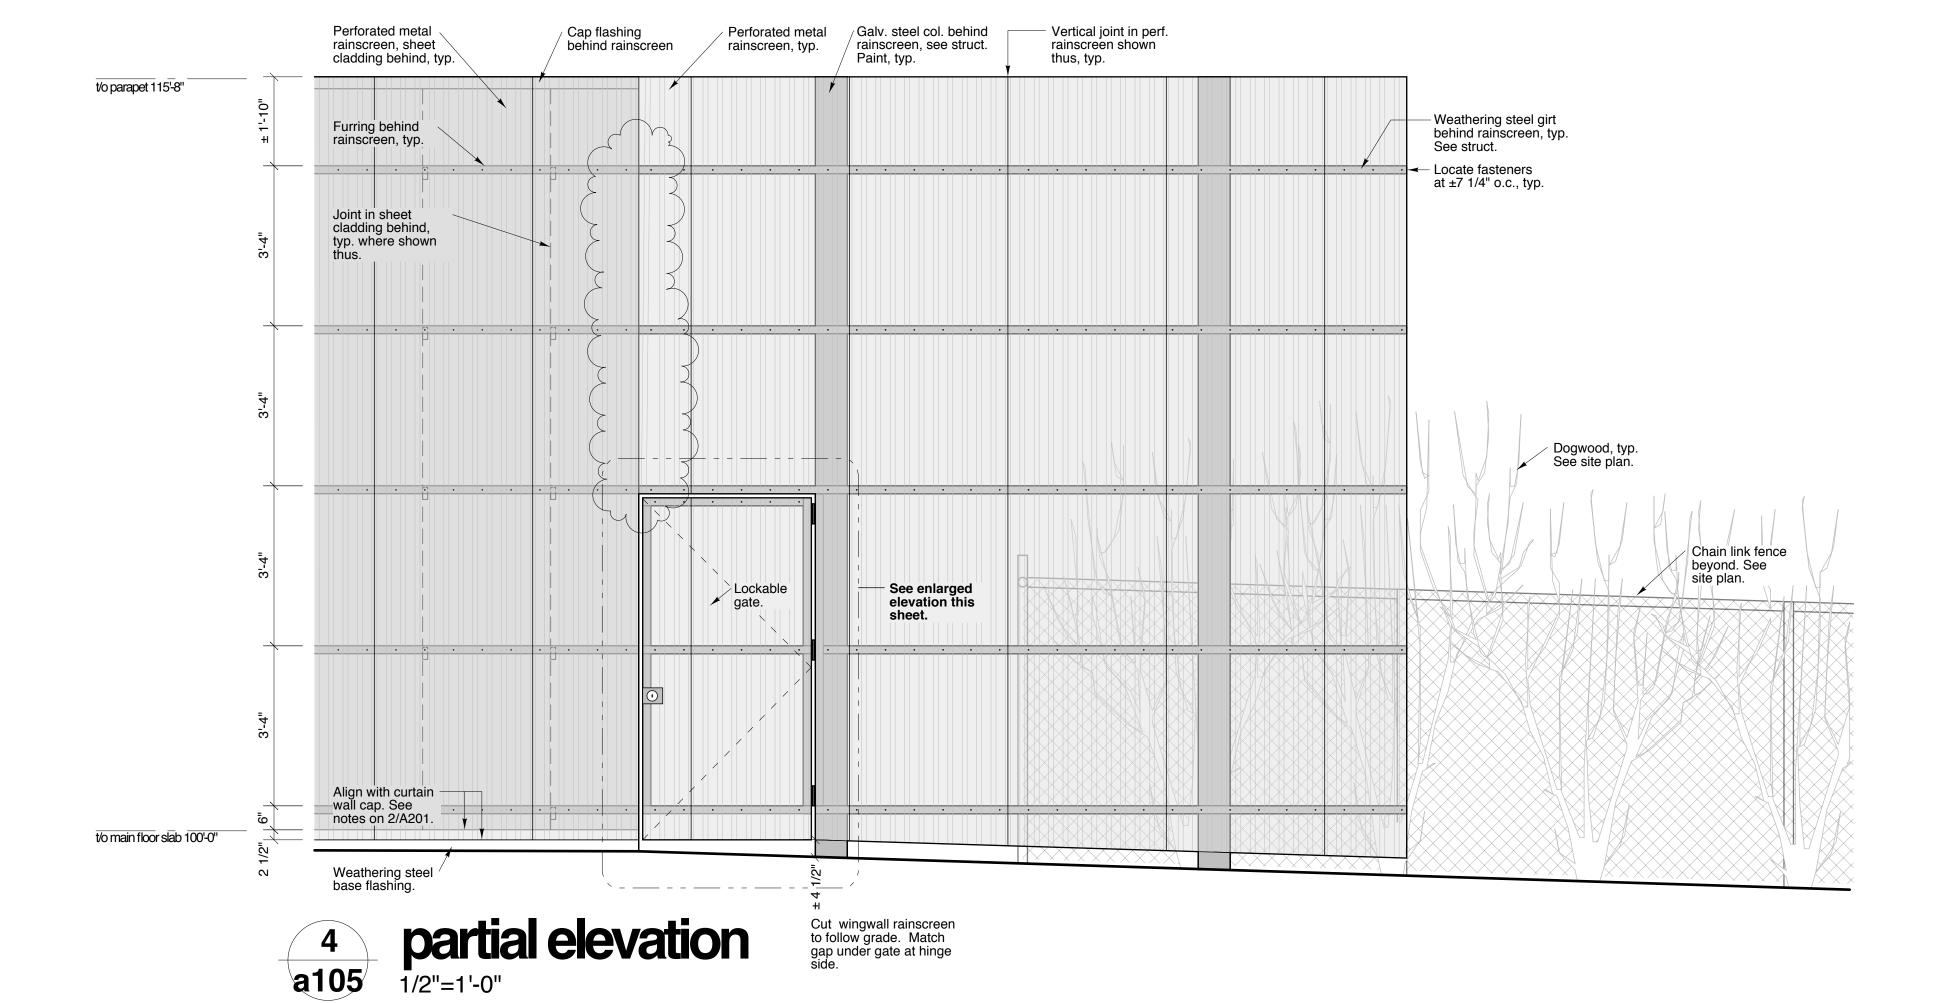

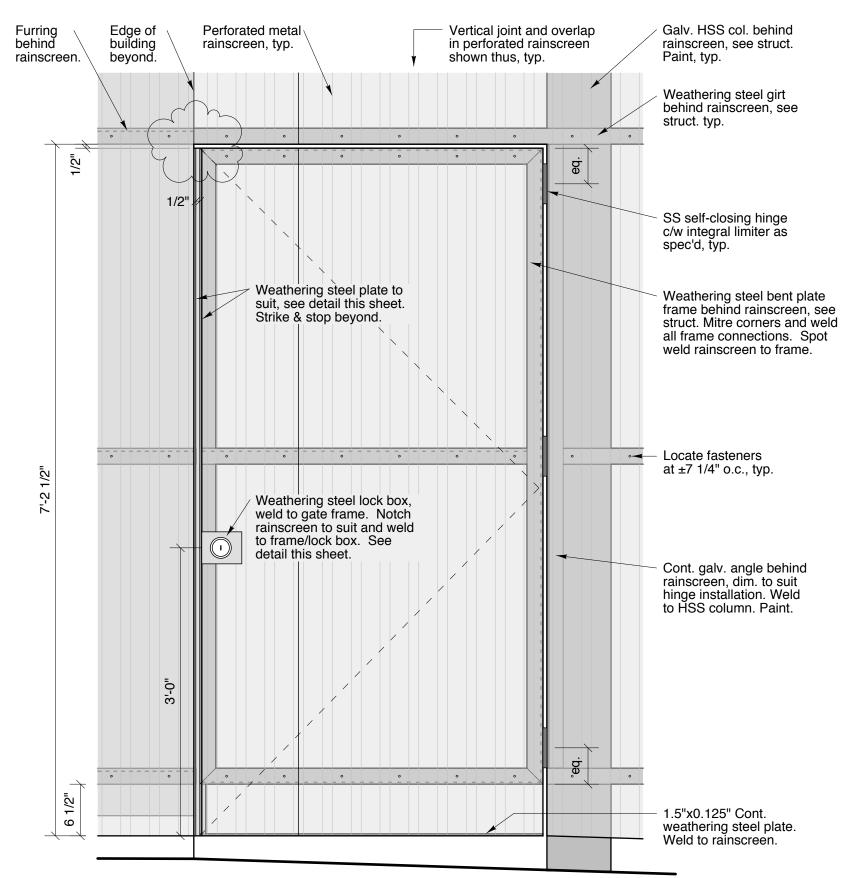



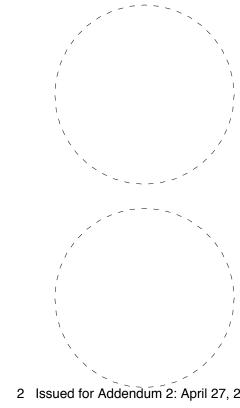


2 Issued for Addendum 2: April 27, 2016 1 Issued for Addendum 1: April 20, 2016 0 Issued for Construction: March 28, 2016 NOTES:

THIS DRAWING IS THE EXCLUSIVE PROPERTY OF H5 ARCHITECTURE AND DAVID PENNER ARCHITECT AND MAY NOT BE REPRODUCED AND/OR USED IN ANY MANNER WITHOUT THEIR EXPRESSED WRITTEN PERMISSION. THE GENERAL CONTRACTOR AND MATERIALS SUPPLIER/S SHALL CHECK ALL DIMENSIONS AND INFORMATION ON THIS DRAWING AND REPORT ANY DISCREPANCIES PRIOR TO COMMENCEMENT OF WORK. DO NOT SCALE THIS



CITY OF WINNIPEG - PLANNING, PROPERTY & DEVELOPMENT DEPARTMENT MUNICIPAL ACCOMMODATIONS DIVISION 3rd FLOOR - 65 GARRY ST., WPG, R3C 4K4

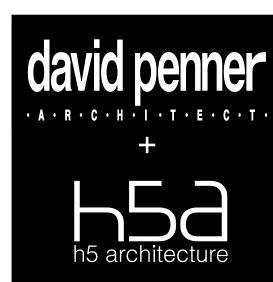

David Penner, 204.475.8978 Helio Rodrigues, 204.774.0012 120 Yale Avenue, Winnipeg, MB, R3M 0L7 **PROJECT** 

Windsor Park Library

**ADDRESS** 1201 Archibald Street

DATE

March 28, 2016 SCALE

enlarged wingwall plan and details **a.105**