



A SECTION
SCALE: 1:150

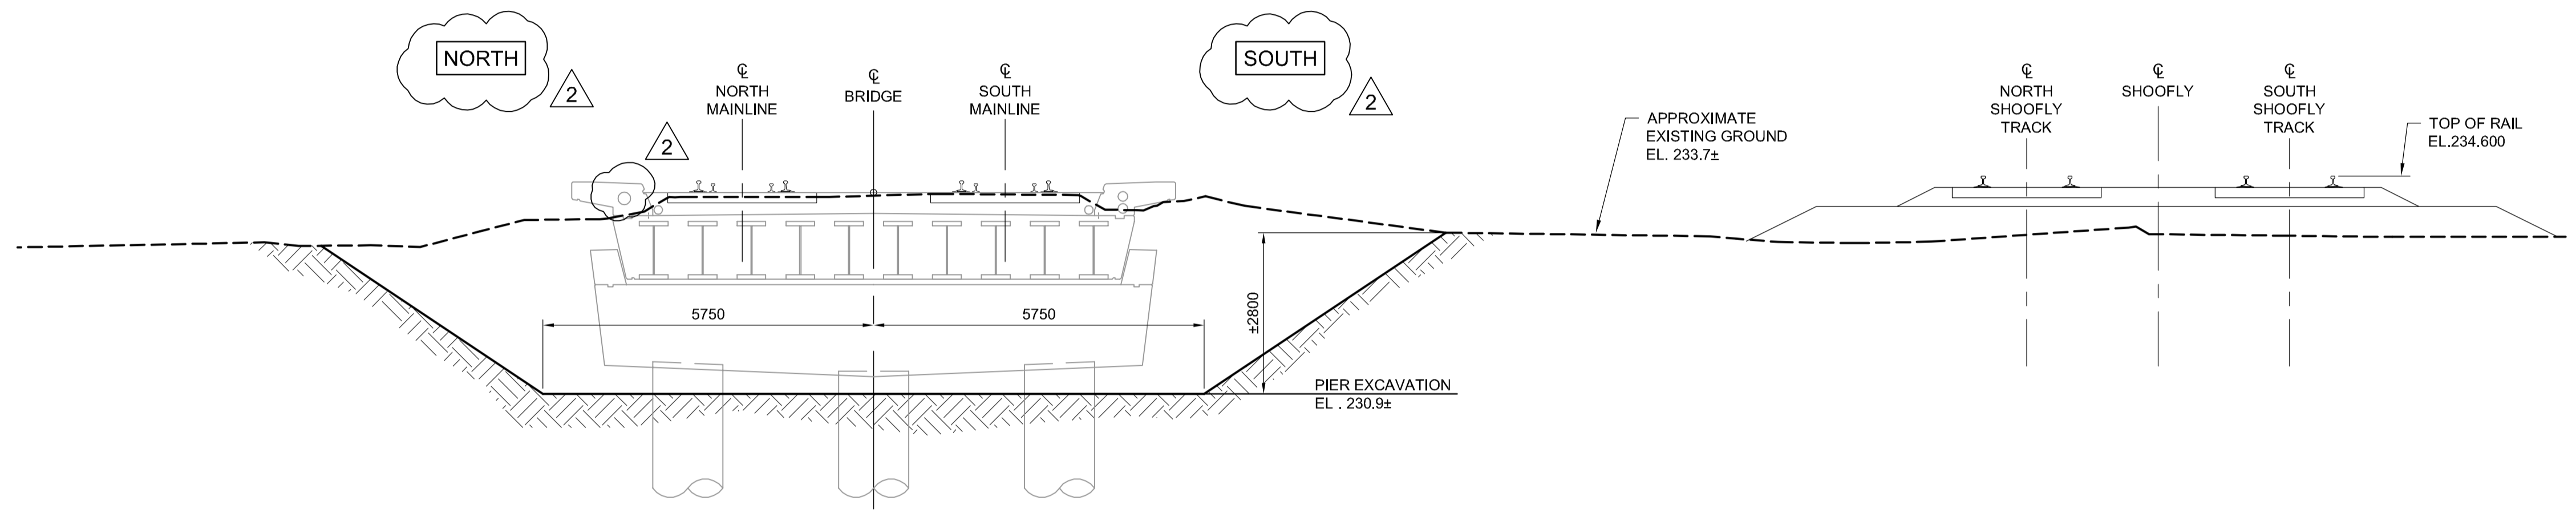

B SECTION
SCALE: 1:75

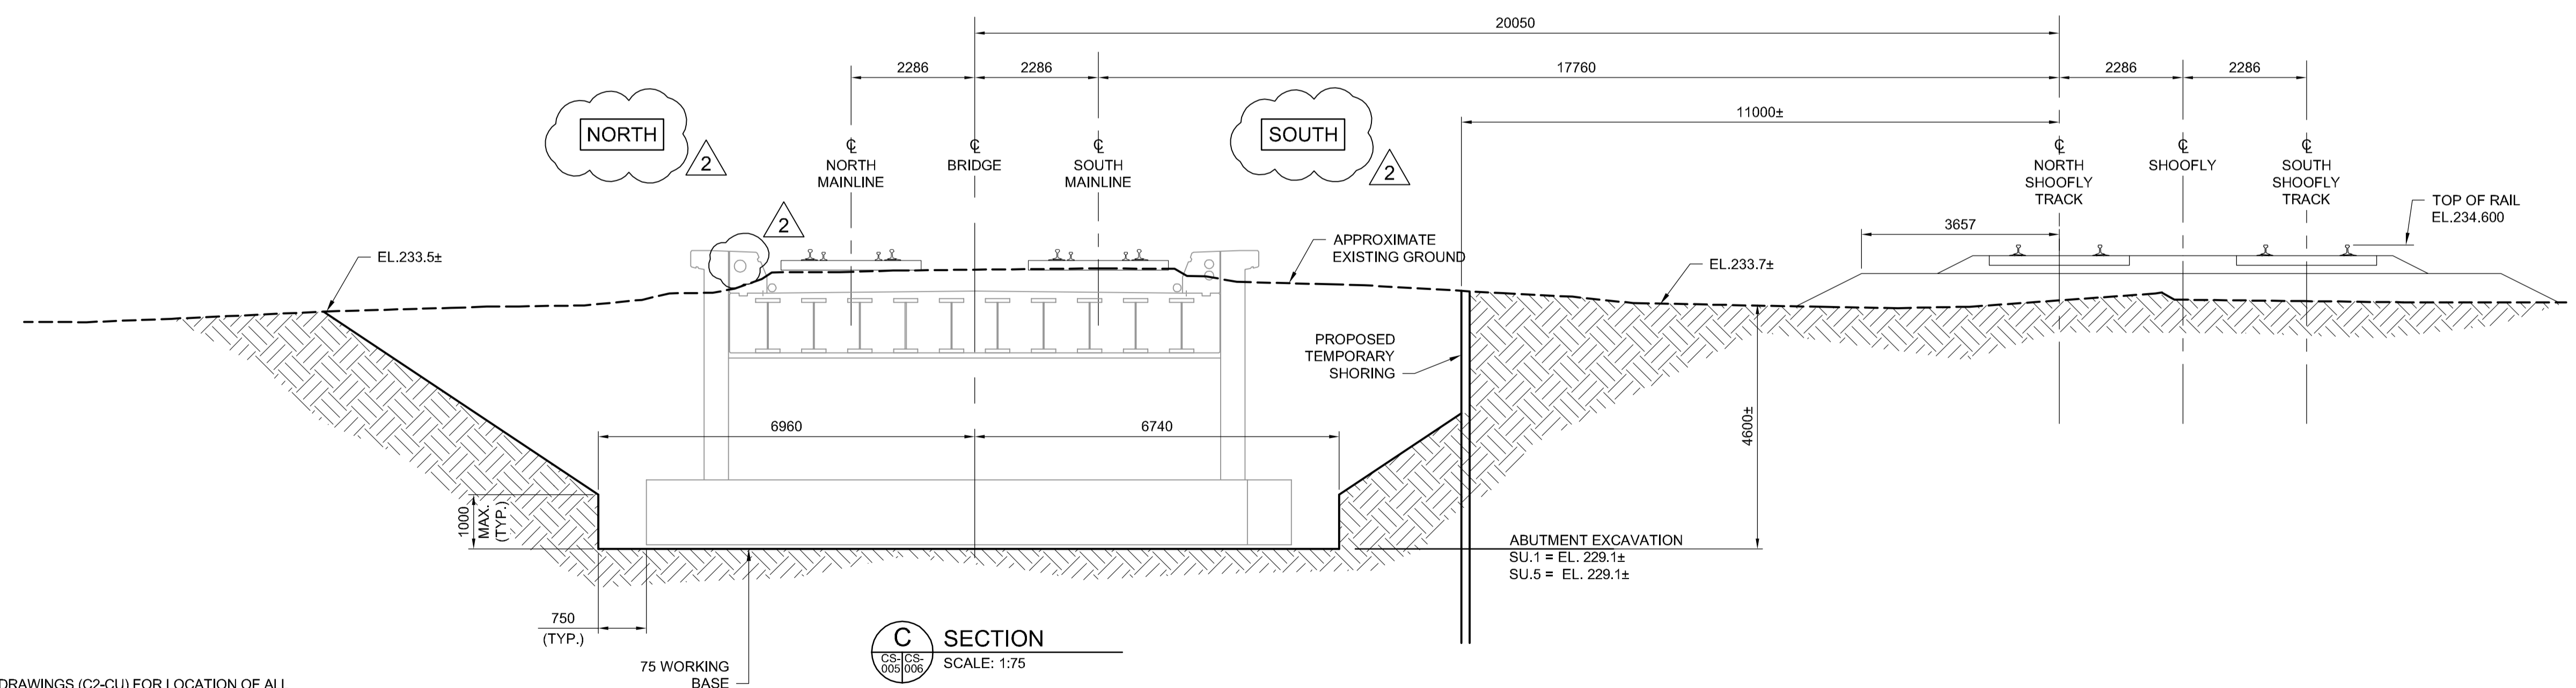

C SECTION
SCALE: 1:75

NOTES:
1. PRIOR TO EXCAVATION REFER TO UTILITY DRAWINGS (C2-CU) FOR LOCATION OF ALL EXISTING UTILITIES.

NOTICE:
THE EXISTENCE, LOCATION AND ELEVATION OF UTILITIES AND/OR CONCEALED STRUCTURES AT THE PROJECT SITE ARE BASED ON THE BEST INFORMATION AVAILABLE AND ARE NOT GUARANTEED BY DILLON CONSULTING LIMITED. THE CONTRACTOR IS RESPONSIBLE FOR DETERMINING THE EXISTENCE, LOCATION AND ELEVATION OF ALL SUCH UTILITIES AND/OR CONCEALED STRUCTURES AND IS RESPONSIBLE FOR NOTIFYING THE APPROPRIATE COMPANY, DEPARTMENT OR PERSON(S) OF ITS INTENTION TO CARRY OUT HIS OPERATIONS.



DESIGNED BY	RE	CHECKED BY	SSR
DRAWN BY	CGC	APPROVED BY	DBW
HOR. SCALE	AS SHOWN	RELEASED FOR CONSTRUCTION	
VERTICAL	AS SHOWN		
NO.	REVISIONS	DATE	BY
2	ADDENDUM #5	17/03/01	RE
1	ADDENDUM #1	17/01/25	RE
0	ISSUED FOR TENDER	17/01/09	RE



ENGINEER'S SEAL
PROVINCE OF MANITOBA
R.B. ERIC
Member 22665
REGISTERED PROFESSIONAL ENGINEER
CONSULTANT PROJECT NUMBER
16-3353

THE CITY OF WINNIPEG
PUBLIC WORKS DEPARTMENT
Waverley Street Underpass at CN Mile 3.89 Rivers Sub
Contract 2: Underpass Structure, Railworks,
Roadworks, Land Drainage Sewer, Pumping Station
and Landscaping Works
CITY DRAWING NUMBER
U-239-2016-C2-CS-006
SHEET 006 OF 085
CONSULTANT DRAWING NUMBER
C2-CS-006

G:\CAD\163353\Technical\Workspaces\Engineering\Drawings and Figures\Structures\Contract\163353-C2-CON-CS-EXCAVATION DETAILS.dwg