A1 SIZE – 594mm x 841mm

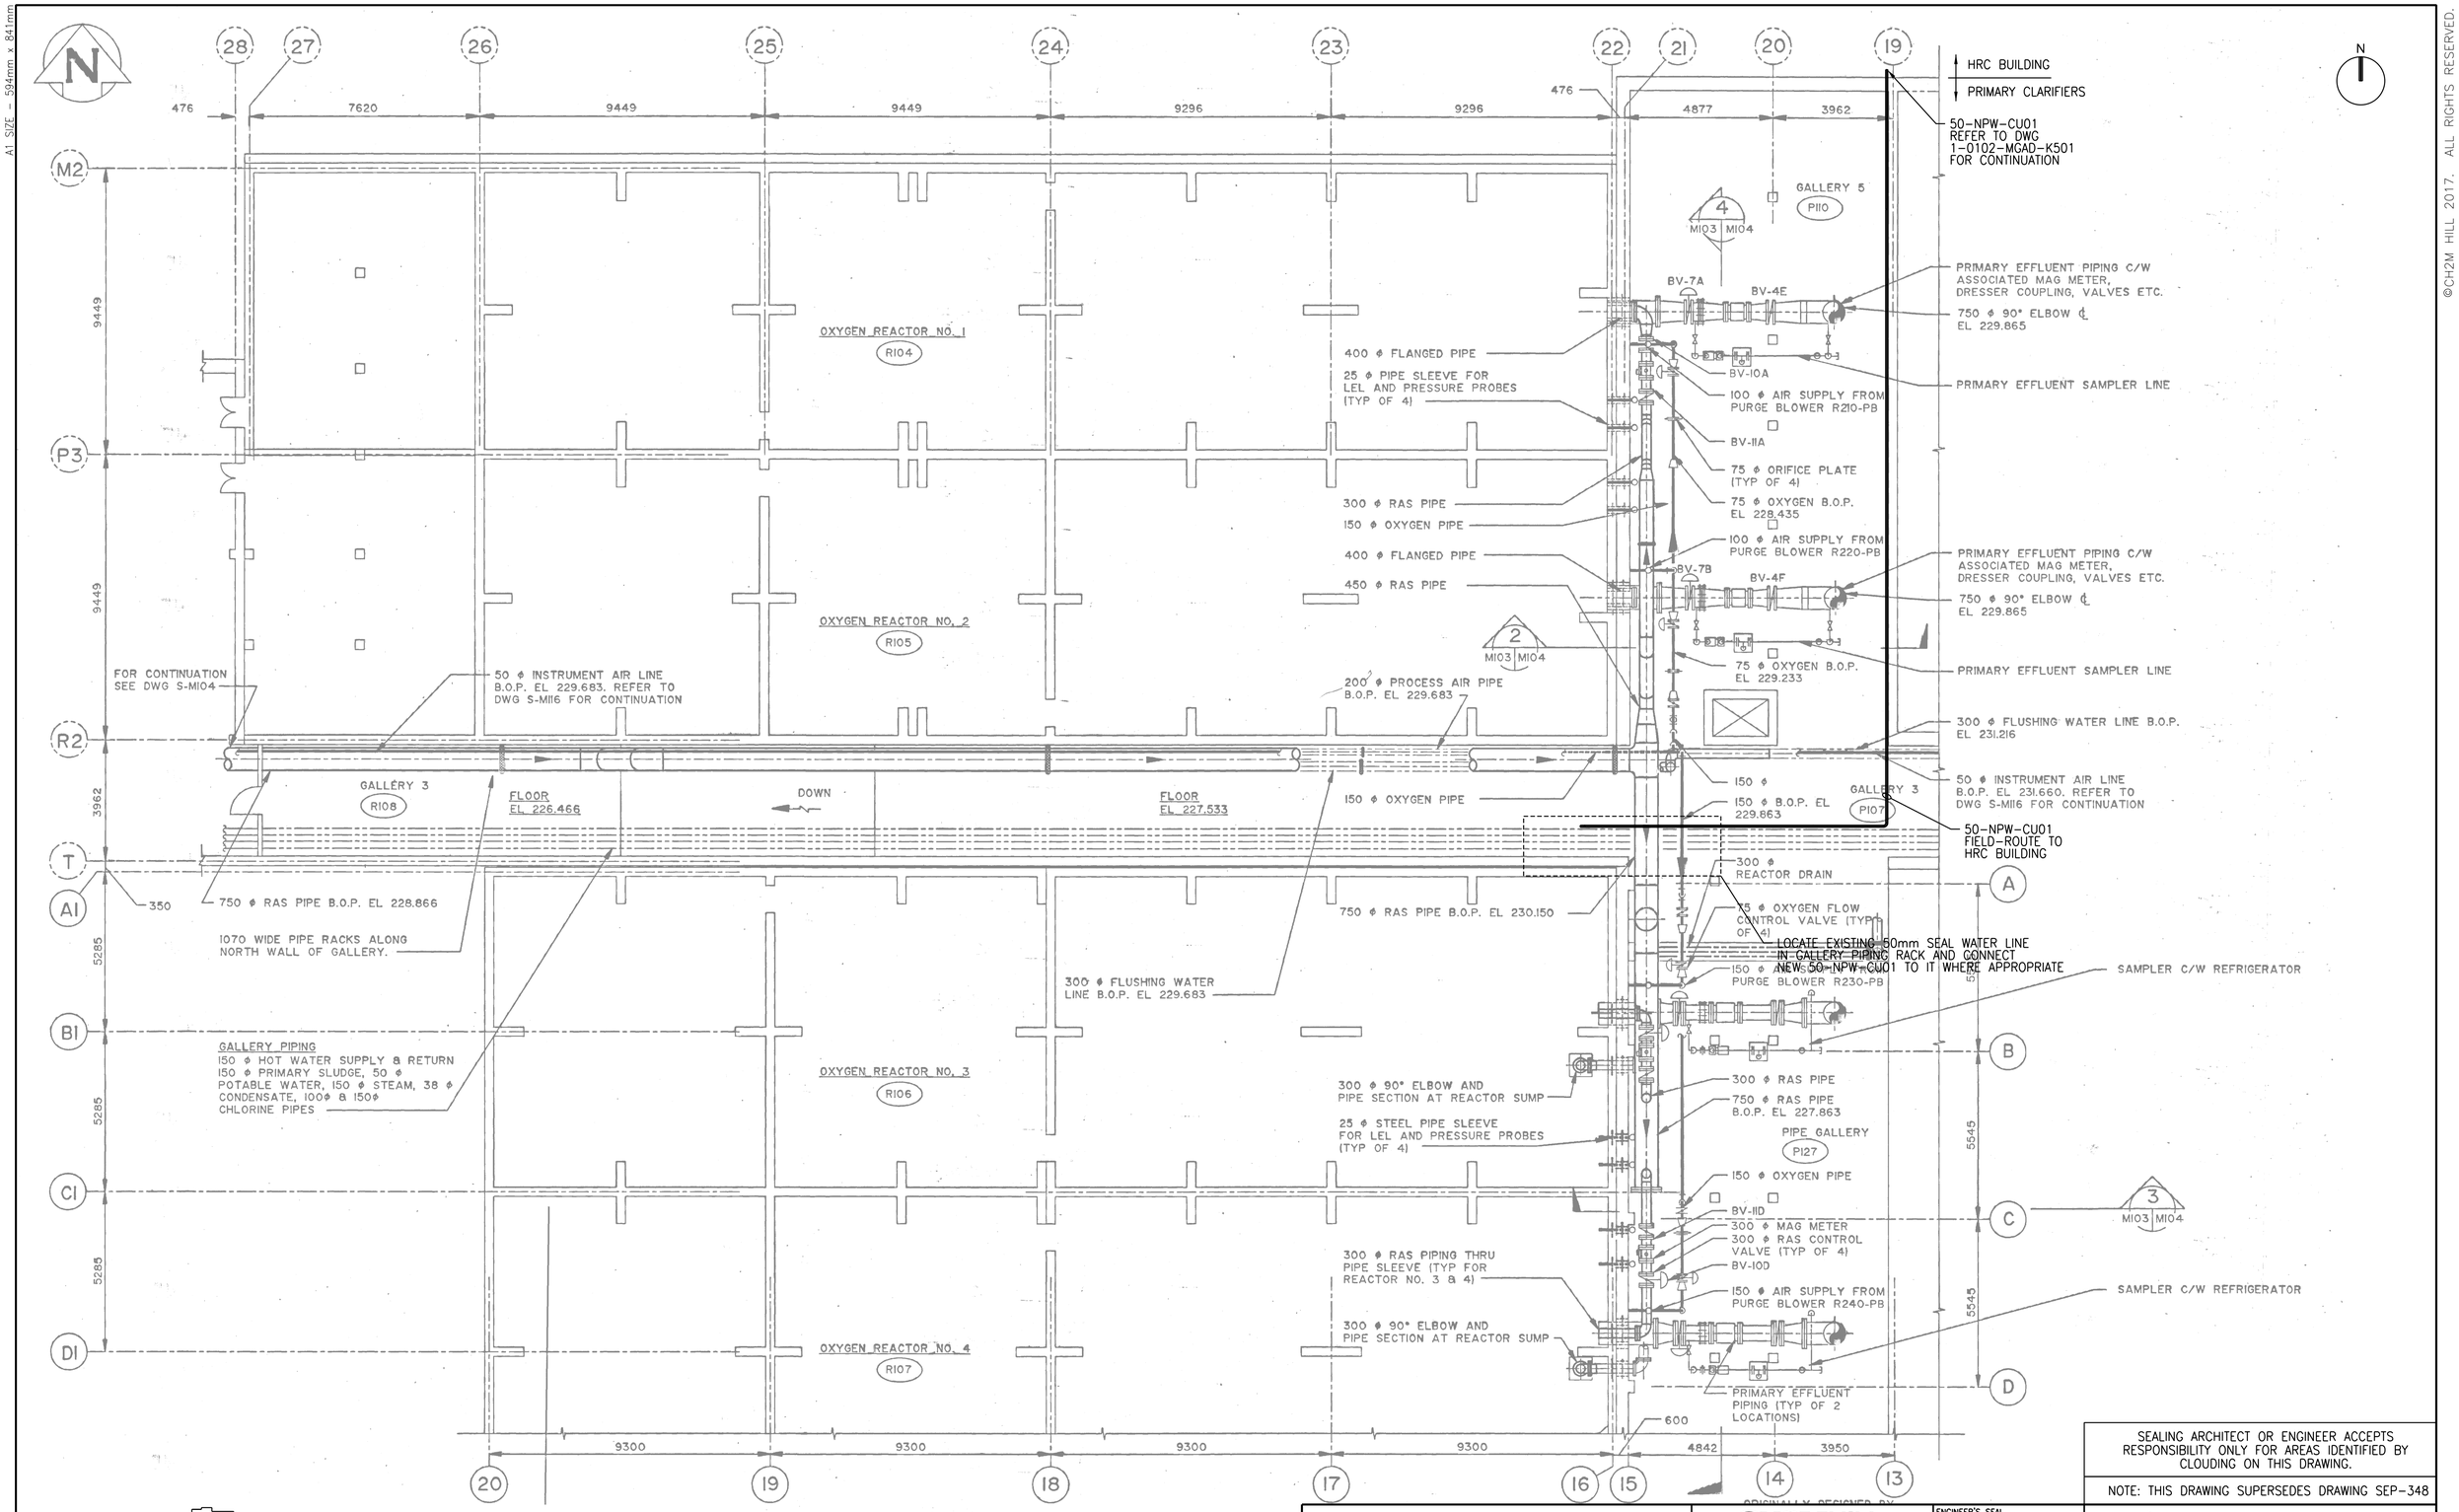

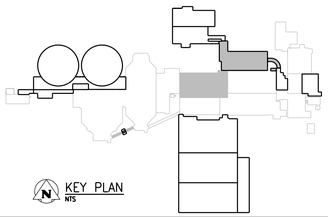

1 PLAN AT ELEVATION 227.533

NOTE:

1. BACKGROUND INFORMATION TAKEN FROM EXISTING DRAWING SEP-348. (D0)

APEGM
Certificate of Authorization
CH2M HILL Canada Ltd.
No. 1441

NO.	REVISIONS	DATE	DESIGN	CHECK
00	ISSUED FOR CONSTRUCTION – 976-2016	2017/04/05	P.K.	J.C.

CH2MHILL. KGS GROUP SNC·LAVALIN

DESIGNED BY: T. TRAN
CHECKED BY: D. CUDDINGTON
DRAWN BY: R. ARCHER
APPROVED BY: H.T. FRIEHAMMER
SCALE: NTS
ISSUED FOR CONSTRUCTION BY: J. SHUMKA
DATE: 2017/04/05
DATE: 2017/04/05
CONSULTANT NO.: 474248

ENGINEER'S SEAL
PROVINCE OF MANITOBA
T.T. TRAN
Member 40578
REGISTERED PROFESSIONAL ENGINEER
April 5th/17.

SEALING ARCHITECT OR ENGINEER ACCEPTS RESPONSIBILITY ONLY FOR AREAS IDENTIFIED BY CLOUDING ON THIS DRAWING.

NOTE: THIS DRAWING SUPERSEDES DRAWING SEP-348

Winnipeg
THE CITY OF WINNIPEG
WATER AND WASTE DEPARTMENT

SOUTH END WATER POLLUTION CONTROL CENTRE
SEWPCC UPGRADING/EXPANSION PROJECT
MECHANICAL
HIGH RATE CLARIFICATION BUILDING
PLUMBING – NPW CONNECTION PLAN

DRAWING NUMBER: 1-0102-MGAD-K505
SHEET:
REV.: 00
SIZE: A1

PLOT DATE: 2017\03\31
FILE NAME:

©CH2M HILL 2017. ALL RIGHTS RESERVED.