



B SIZE - 279mm x 432mm

LAST SAVE: 2017/06/21 - 11:23am  
 PATH: C:\pw\_workdir\ch2mhill\_wbg\k031761\d0356208\1-0102-AILD-G907.dwg

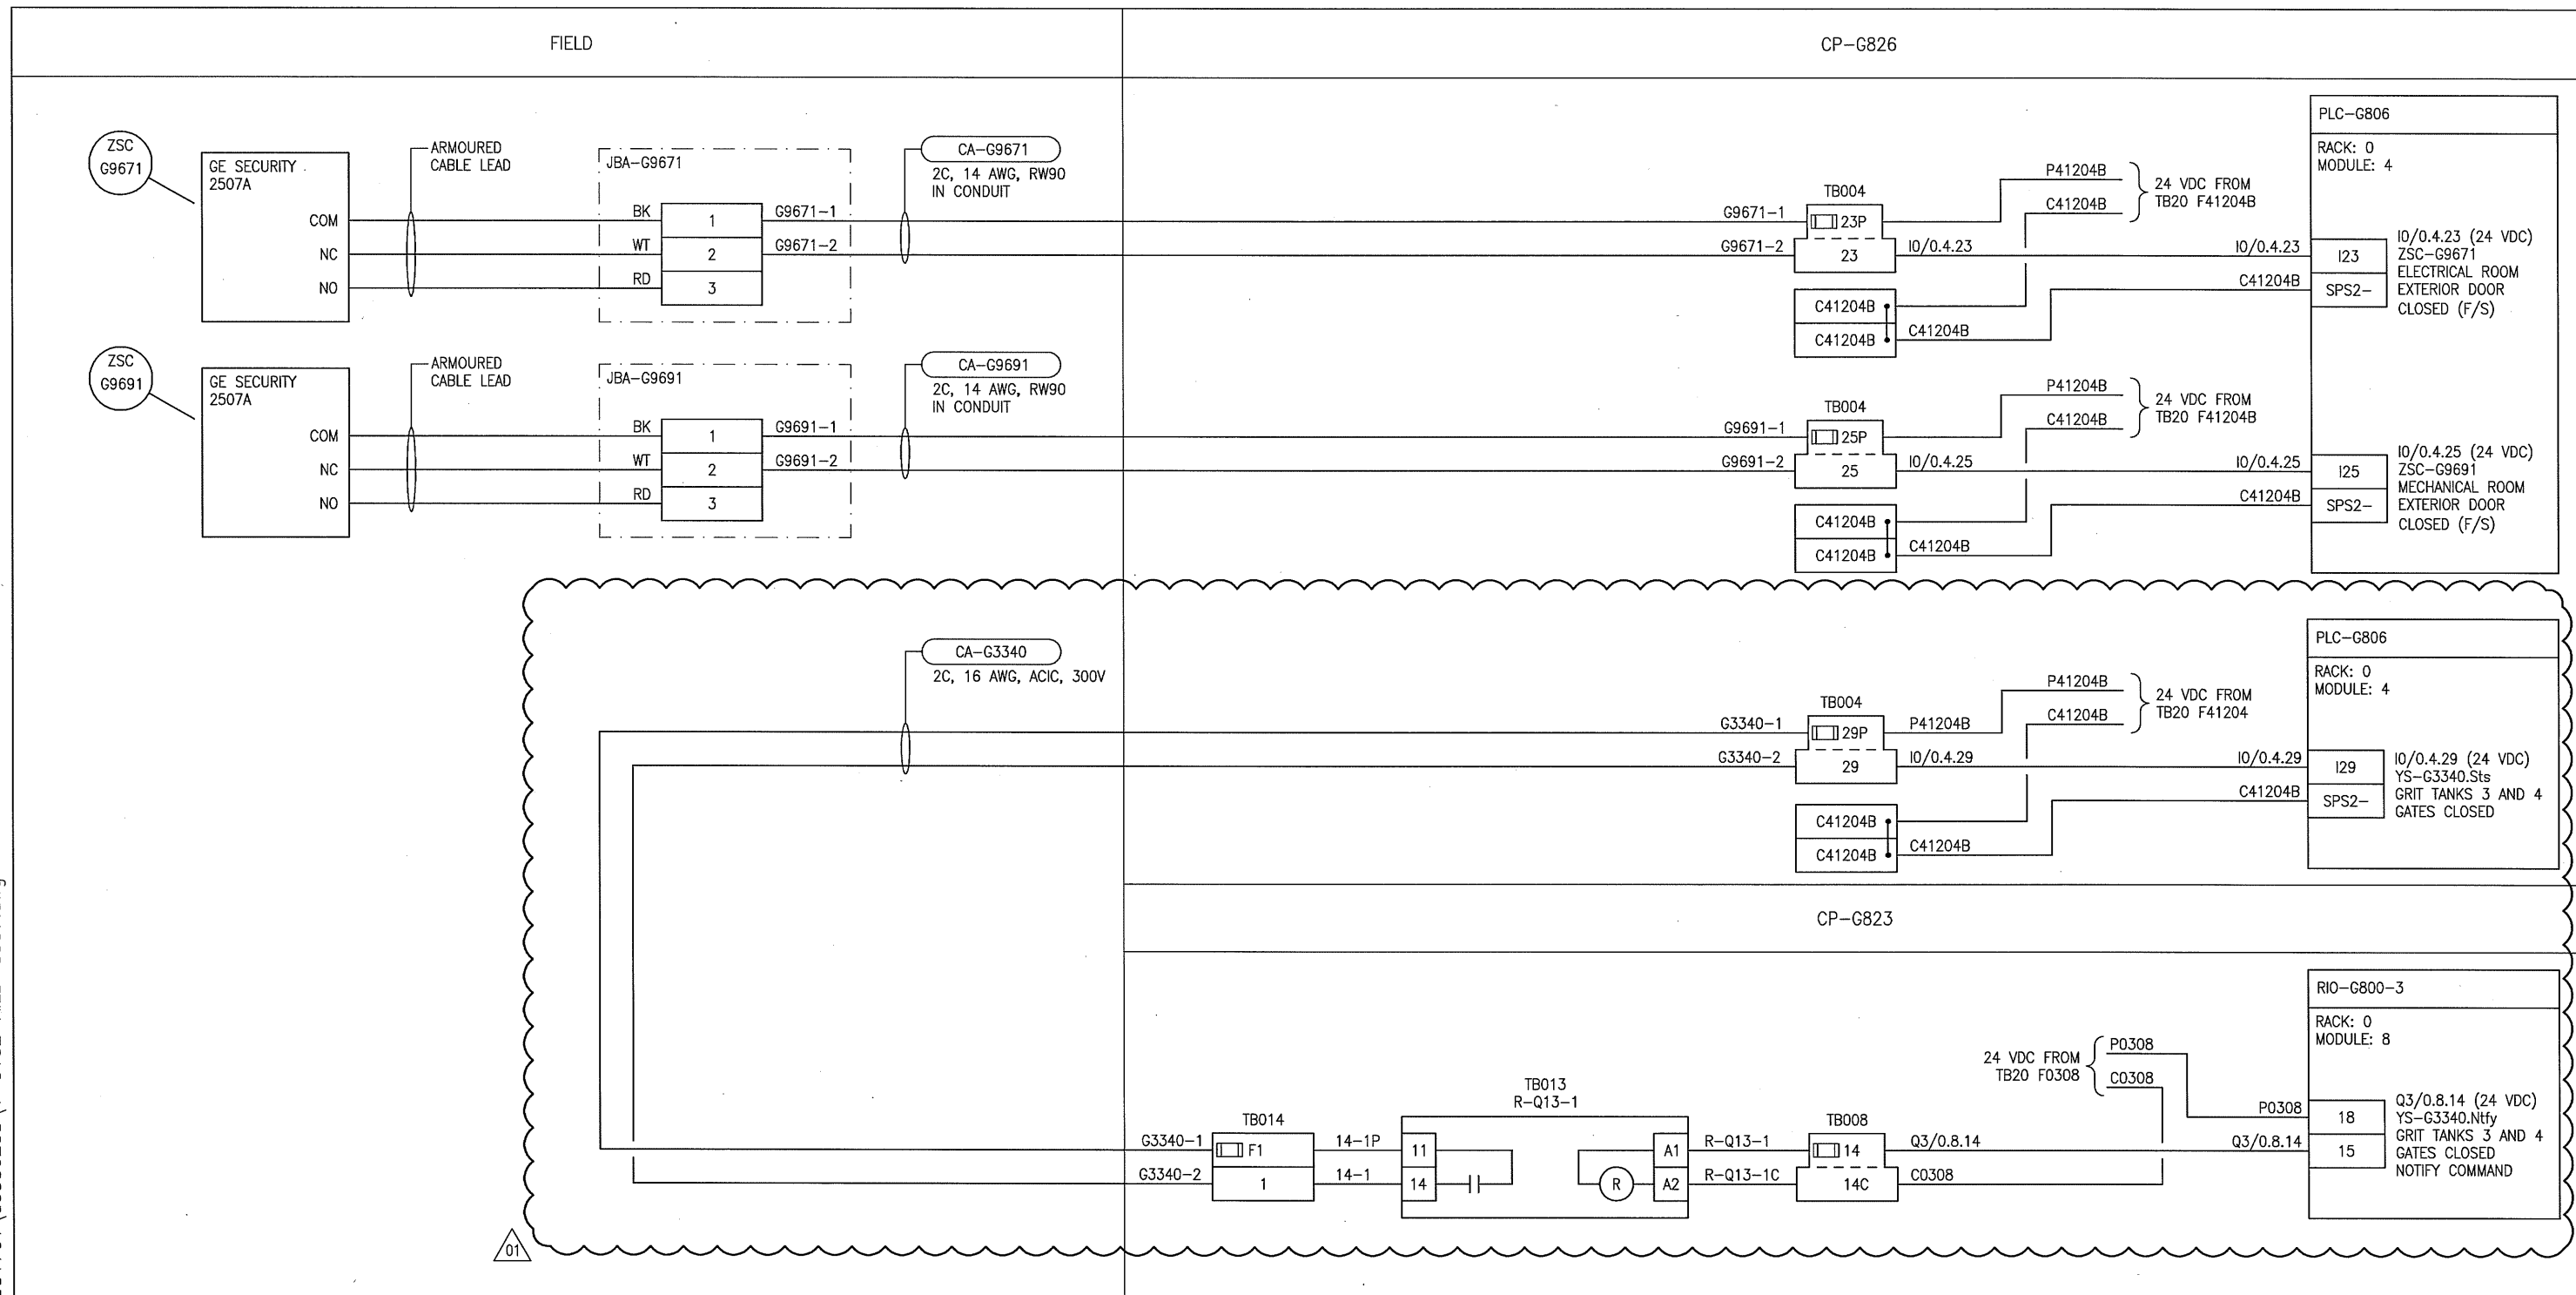

**SNC-LAVALIN** **CH2MHILL** **KGS GROUP CONSULTING ENGINEERS**

DESIGNED BY: S. BOGHOSIAN	CHECKED BY: T. CHURCH
DRAWN BY: M.J. PERSSON	APPROVED BY: E. RYCZKOWSKI
SCALE: NTS	DATE: 2016/10/19
ISSUED FOR CONSTRUCTION	
BY: J. SHUMKA	DATE: 2017/04/05
CONSULTANT NO.: 474248	

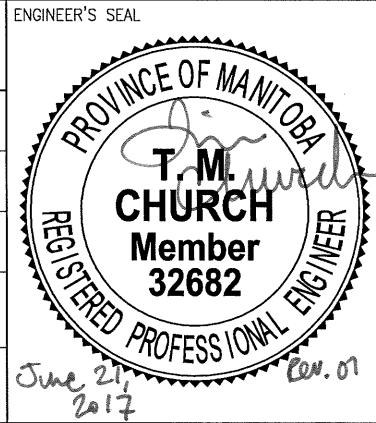

**THE CITY OF WINNIPEG**  
 WATER AND WASTE DEPARTMENT

SOUTH END WATER POLLUTION CONTROL CENTRE  
 SEWPPC UPGRADING/EXPANSION PROJECT

**AUTOMATION - LOOP DIAGRAM**

ZSC-G9671, ZSC-G9691 DOOR SWITCHES AND YS-G3340  
 GRIT TANKS 3 AND 4 GATES CLOSED NOTIFY COMMAND

CITY DRAWING NUMBER	SHEET	REV.	SIZE
1-0102-AILD-G907	001	01	B