

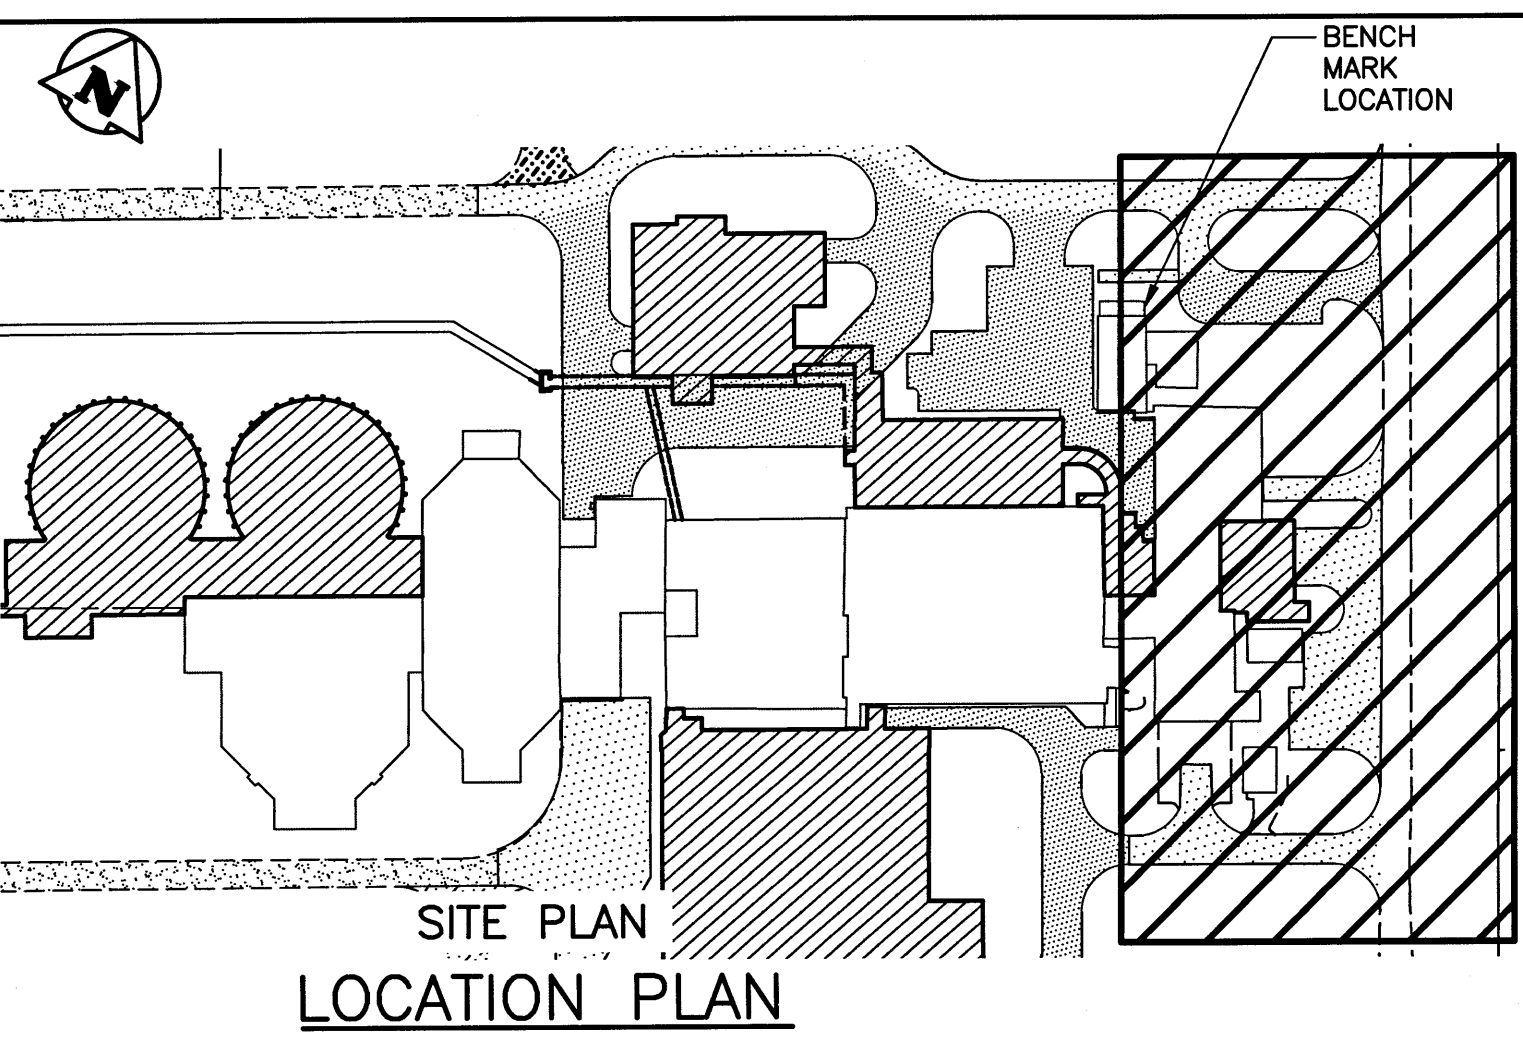


A1 SIZE - 594mm x 841mm

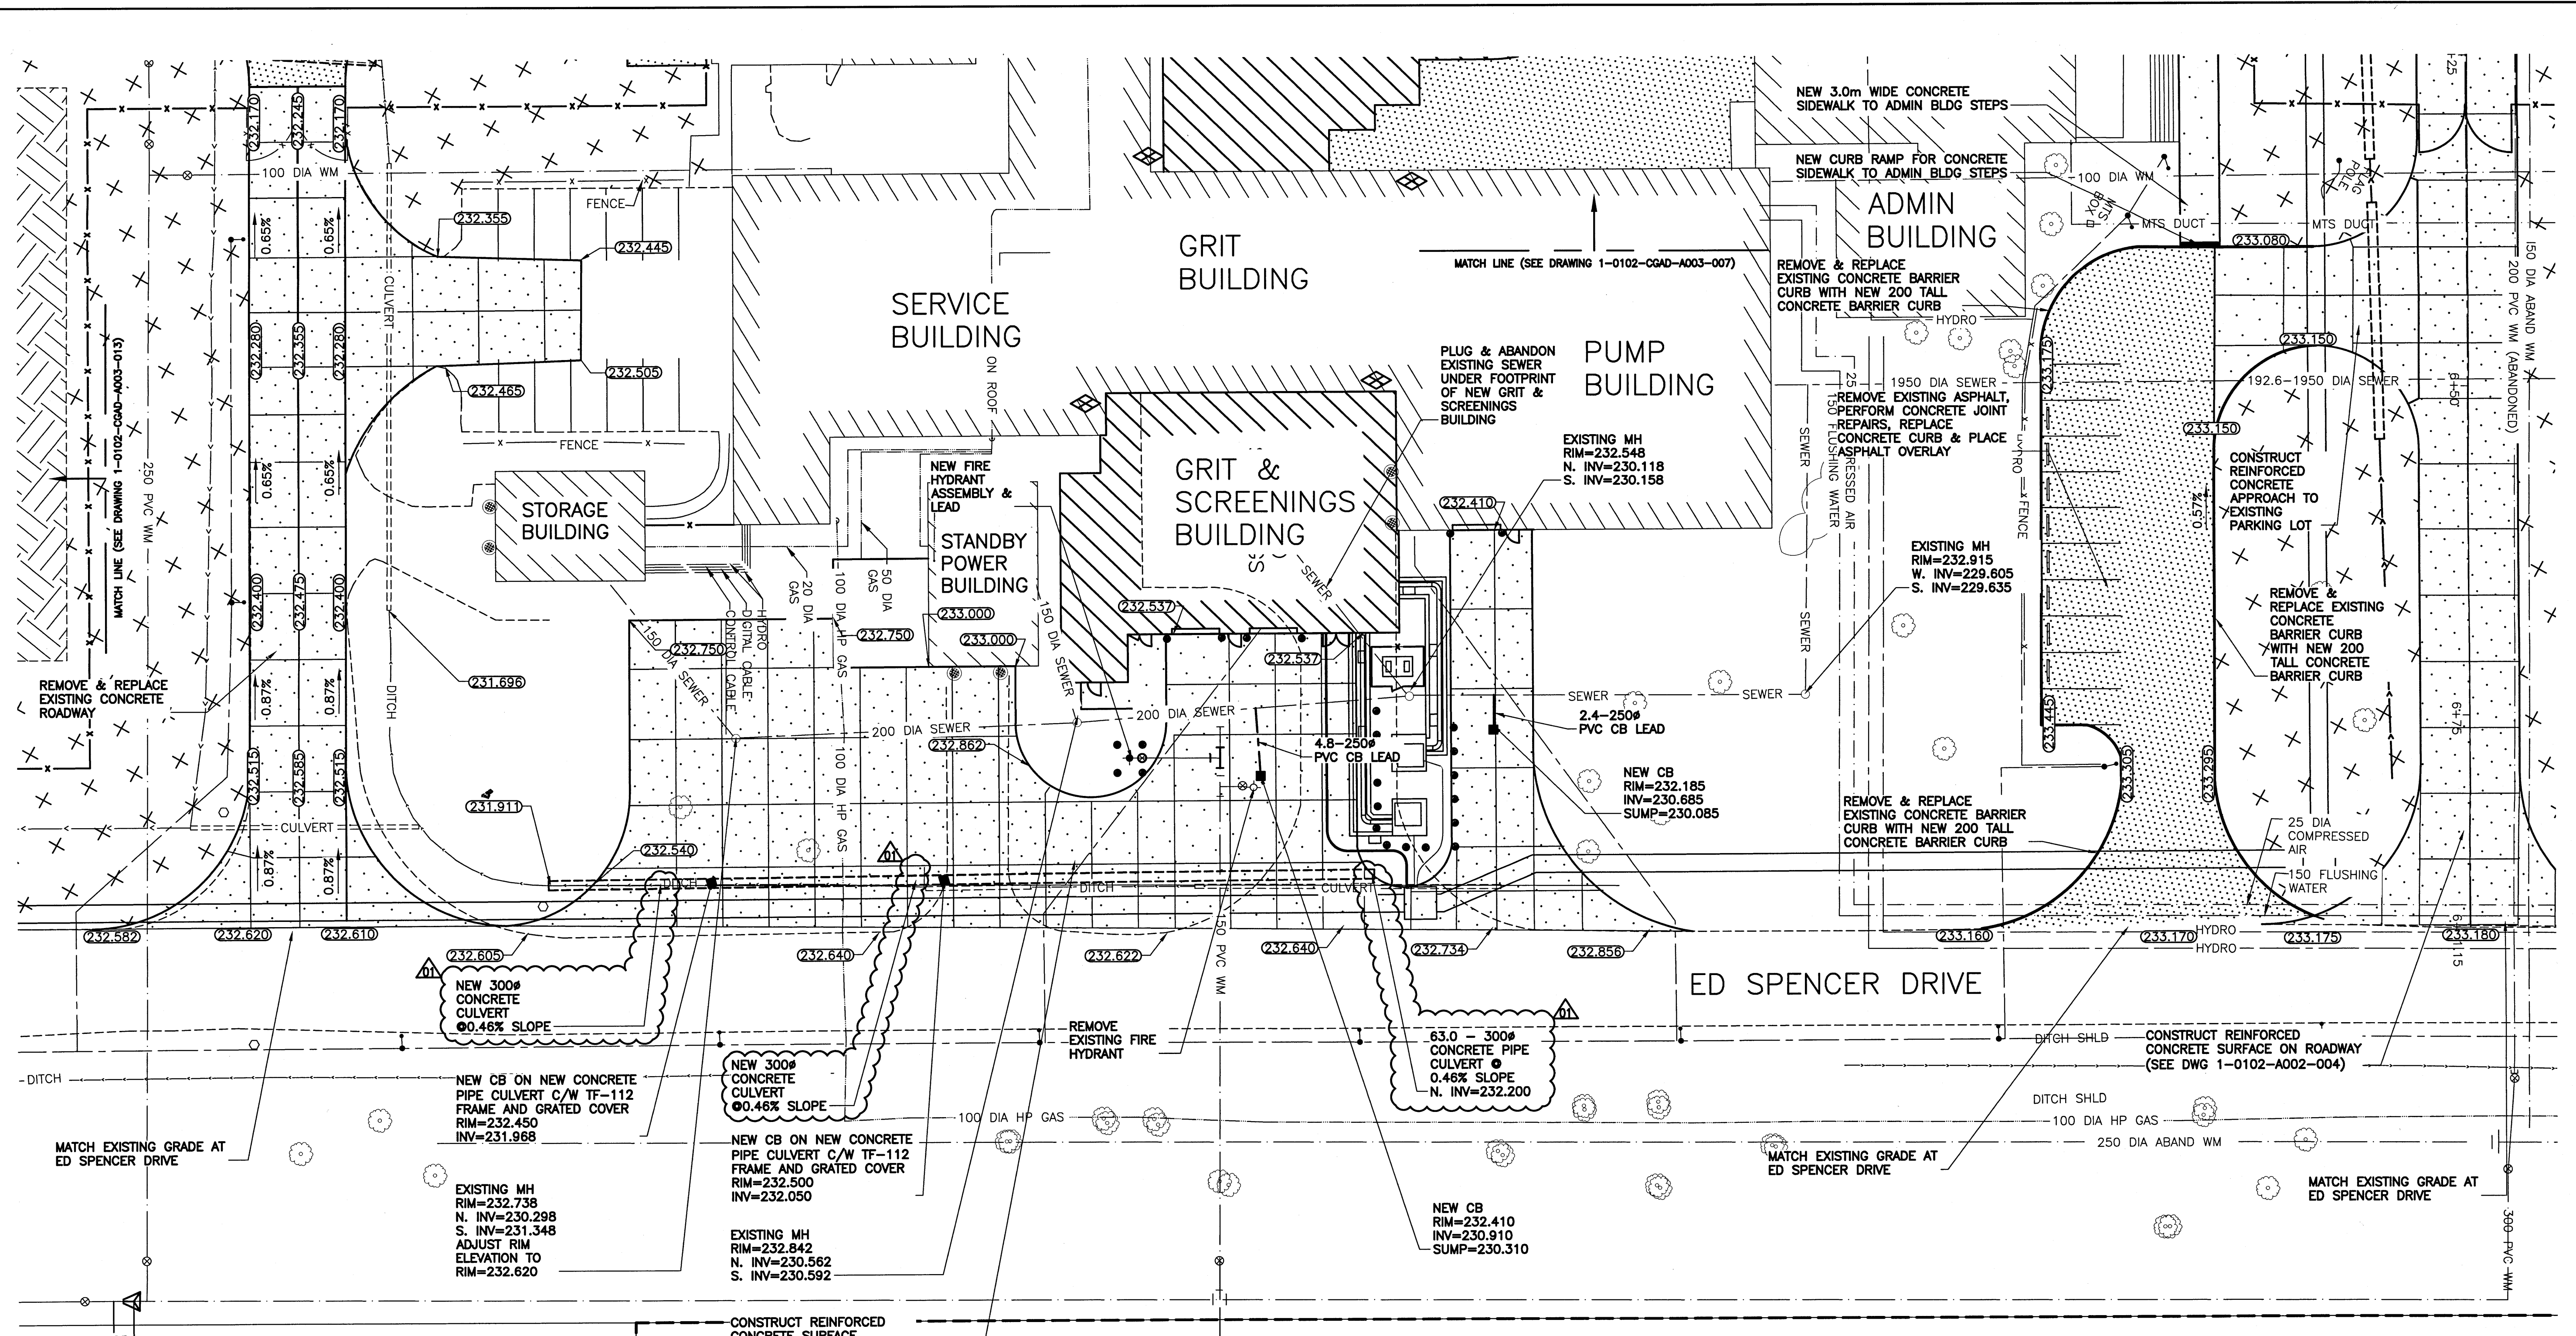


LEGEND				LEGEND			
ITEM	EXISTING	NEW	ABANDONED	ITEM	EXISTING	NEW	ABANDONED
CONSTRUCTION ACCESS ROAD/ GRAVEL LAYDOWN AREA TO BE COVERED IN TOPSOIL & SOD				REVISION CLOUD			
DITCHES AND OTHER LANDSCAPE AREAS TO BE FINISHED WITH TOPSOIL & SOD							
NEW GRAVEL SURFACE ROADWAY/PARKING AREA							
NEW CONCRETE SURFACE PAVEMENT							
NEW ASPHALT SURFACE PAVEMENT							
WM VALVE	⊗	⊕	⊖	GAS	—	—	—
WM HYDRANT	⊙	⊕	⊖	DITCH	—	—	—
SEWER MH	⊙	⊕	⊖	FENCE	—	—	—
SEWER CB	⊙	⊕	⊖	SIGN	—	—	—
MTS	⊙	⊕	⊖	BOLLARD	—	—	—
MTS MH	⊙	⊕	⊖	TREE	—	—	—
HYDRO LS	—	—	—	BUSH	—	—	—
HYDRO POLE	—	—	—	ELEVATION CULVERT	233.240	233.450	—

PLAN VIEW

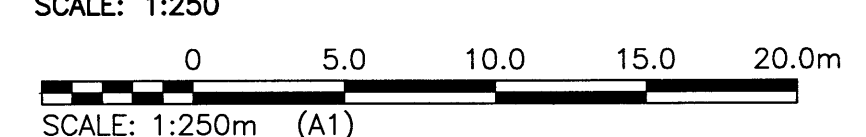

- NOTES:**
- ALL WORK SHALL BE PERFORMED IN ACCORDANCE WITH THE LATEST REVISION OF THE CITY OF WINNIPEG STANDARD CONSTRUCTION SPECIFICATIONS.
 - CONTRACTOR SHALL OBTAIN LOCATES FOR ALL UNDERGROUND UTILITIES PRIOR TO CONSTRUCTION.

ITEMS SHOWN AS EXISTING ARE BASED ON AVAILABLE DOCUMENTATION AND MAY NOT ACTUALLY BE REPRESENTATIVE OF THE EXISTING INFRASTRUCTURE. THE DESIGN ENGINEER IS ONLY RESPONSIBLE FOR INFRASTRUCTURE THAT IS SHOWN AS A NEW INSTALLATION. THE CONTRACTOR IS RESPONSIBLE FOR CONFIRMING THE STATE OF THE EXISTING INFRASTRUCTURE THAT MAY HAVE AN IMPACT ON THE INSTALLATION OF NEW EQUIPMENT.

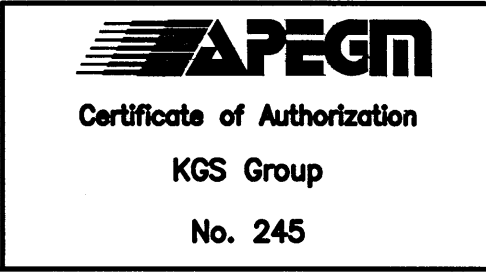

B.M. ELEV.	BRASS PLATE LOCATED IN GRADE BEAM OF ADMINISTRATION BUILDING	234.059	
NO.	REVISIONS	DATE	DESIGN CHECK
01	ISSUED FOR ADDENDUM 5 - 976-2016	2017/07/13	EMS
00	ISSUED FOR CONSTRUCTION - 976-2016	2017/04/05	EMS BJM

CH2MHILL

DESIGNED BY: EMS
DRAWN BY: DMW
SCALE: AS NOTED

CHECKED BY: BJM
APPROVED BY: BJM
RELEASED FOR CONSTRUCTION BY: J. SHUMKA
DATE: 15/12/15
DATE: 2017/04/05

CONSULTANT NO.: 13-0338-002

DATE: 13-0338-002

THE CITY OF WINNIPEG
WATER AND WASTE DEPARTMENT

SOUTH END WATER POLLUTION CONTROL CENTRE
SEMPCC UPGRADE/EXPANSION PROJECT
CIVIL
SURFACE GRADING PLAN
EAST

CITY DRAWING NUMBER: 1-0102-CGAD-A003-008
SHEET: 01
REV: 01
SIZE: A1

LAST SAVE: 2017/07/13 - 12:03pm
PATH: P:\Projects\2013\13-0338-002\Dwg\Wm\Contract 4.1-0102-CGAD-A003-008.dwg