


DECIMALIZED NUMBERS INDICATE METRES

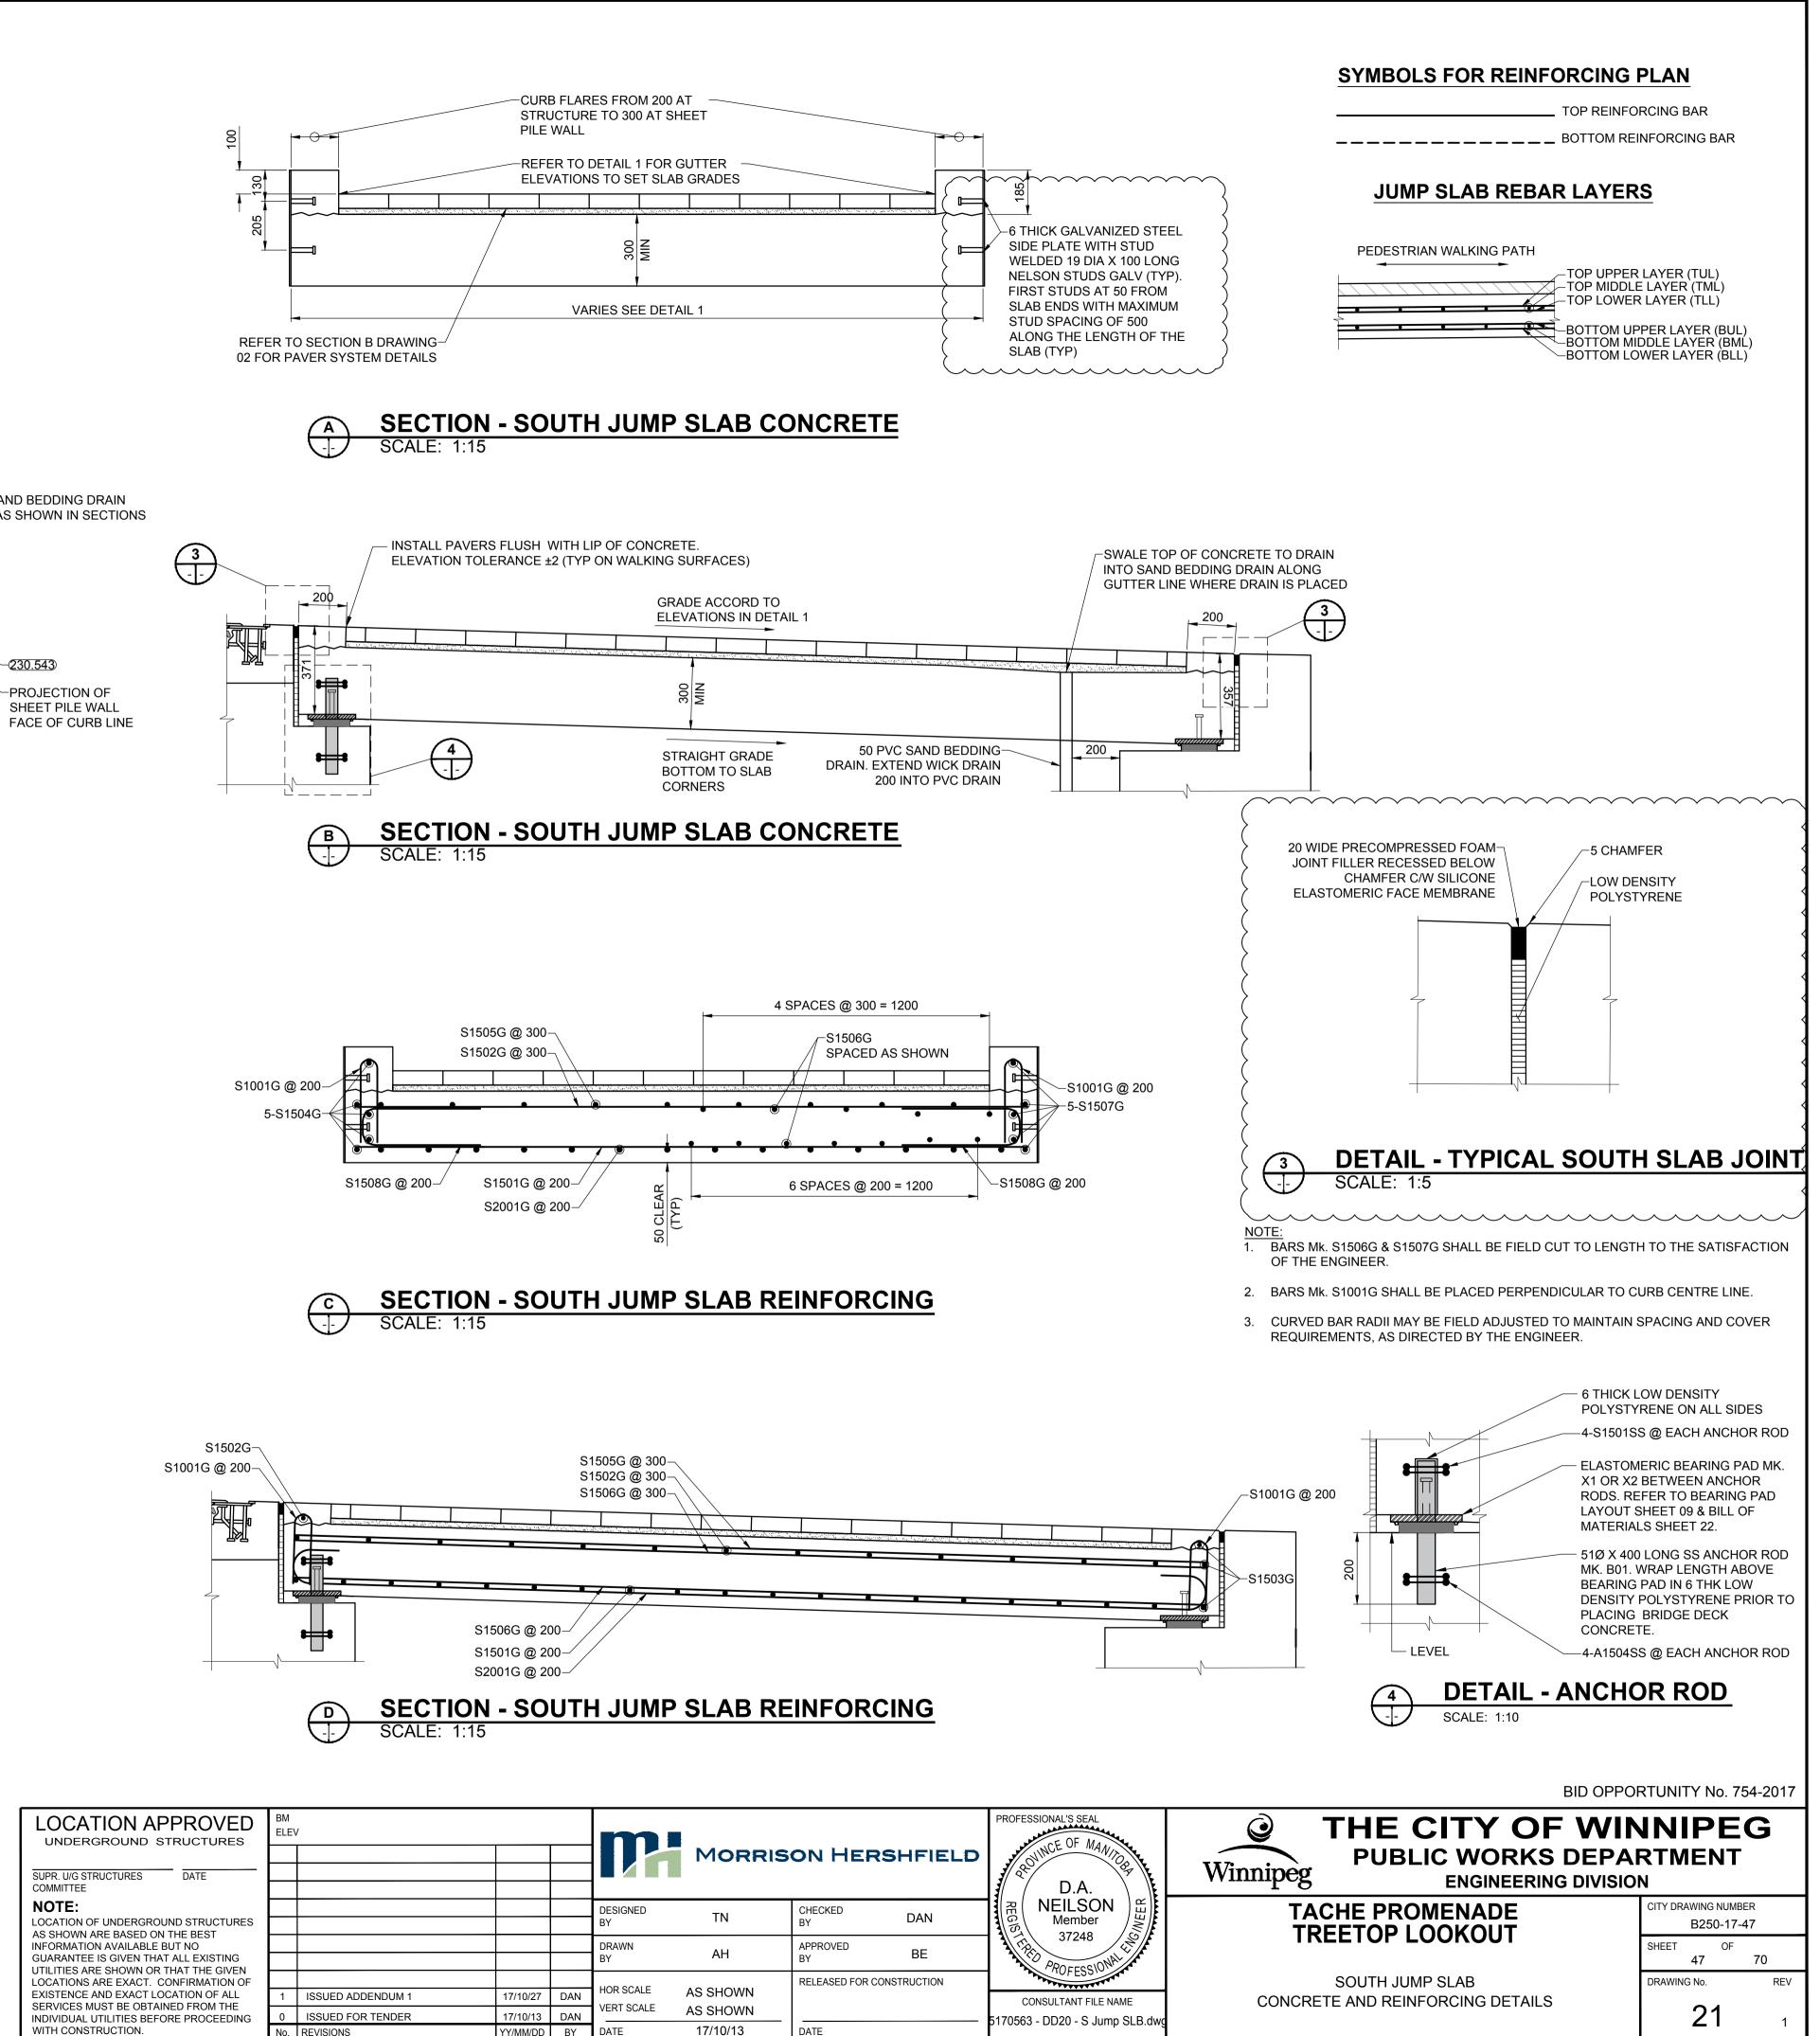

LOCATION APPROVED UNDERGROUND STRUCTURES		BM ELEV							PROFESSIONAL'S SEAL	
	PR. U/G STRUCTURES DATE						D.A.			
	DTE: CATION OF UNDERGROUND STRUCTURES SHOWN ARE BASED ON THE BEST ORMATION AVAILABLE BUT NO ARANTEE IS GIVEN THAT ALL EXISTING LITIES ARE SHOWN OR THAT THE GIVEN CATIONS ARE EXACT. CONFIRMATION OF STENCE AND EXACT LOCATION OF ALL RVICES MUST BE OBTAINED FROM THE IVIDUAL UTILITIES BEFORE PROCEEDING FH CONSTRUCTION.					DESIGNED BY	TN	CHECKED BY	DAN	CONSULTANT FILE N 5170563 - DD20 - S Jun
INFOR GUARA						DRAWN BY	АН	APPROVED BY	BE	
LOCAT EXISTE SERVIO		1	ISSUED ADDENDUM 1	17/10/27	DAN	HOR SCALE VERT SCALE	AS SHOWN AS SHOWN	RELEASED FOR CON	STRUCTION	
		0 No.	ISSUED FOR TENDER REVISIONS	17/10/13 YY/MM/DD	DAN BY	DATE	17/10/13	DATE		

-230.543

-PROJECTION OF

SHEET PILE WALL