
Template Version: SrC120180115 - Consulting Services RFP

APPENDIX E – PLAN OF TOPOGRAPHIC SURVEY – PORTAGE AND MAIN CONCOURSE SW CORNER, GROUND LEVEL JOB NO. 20140189

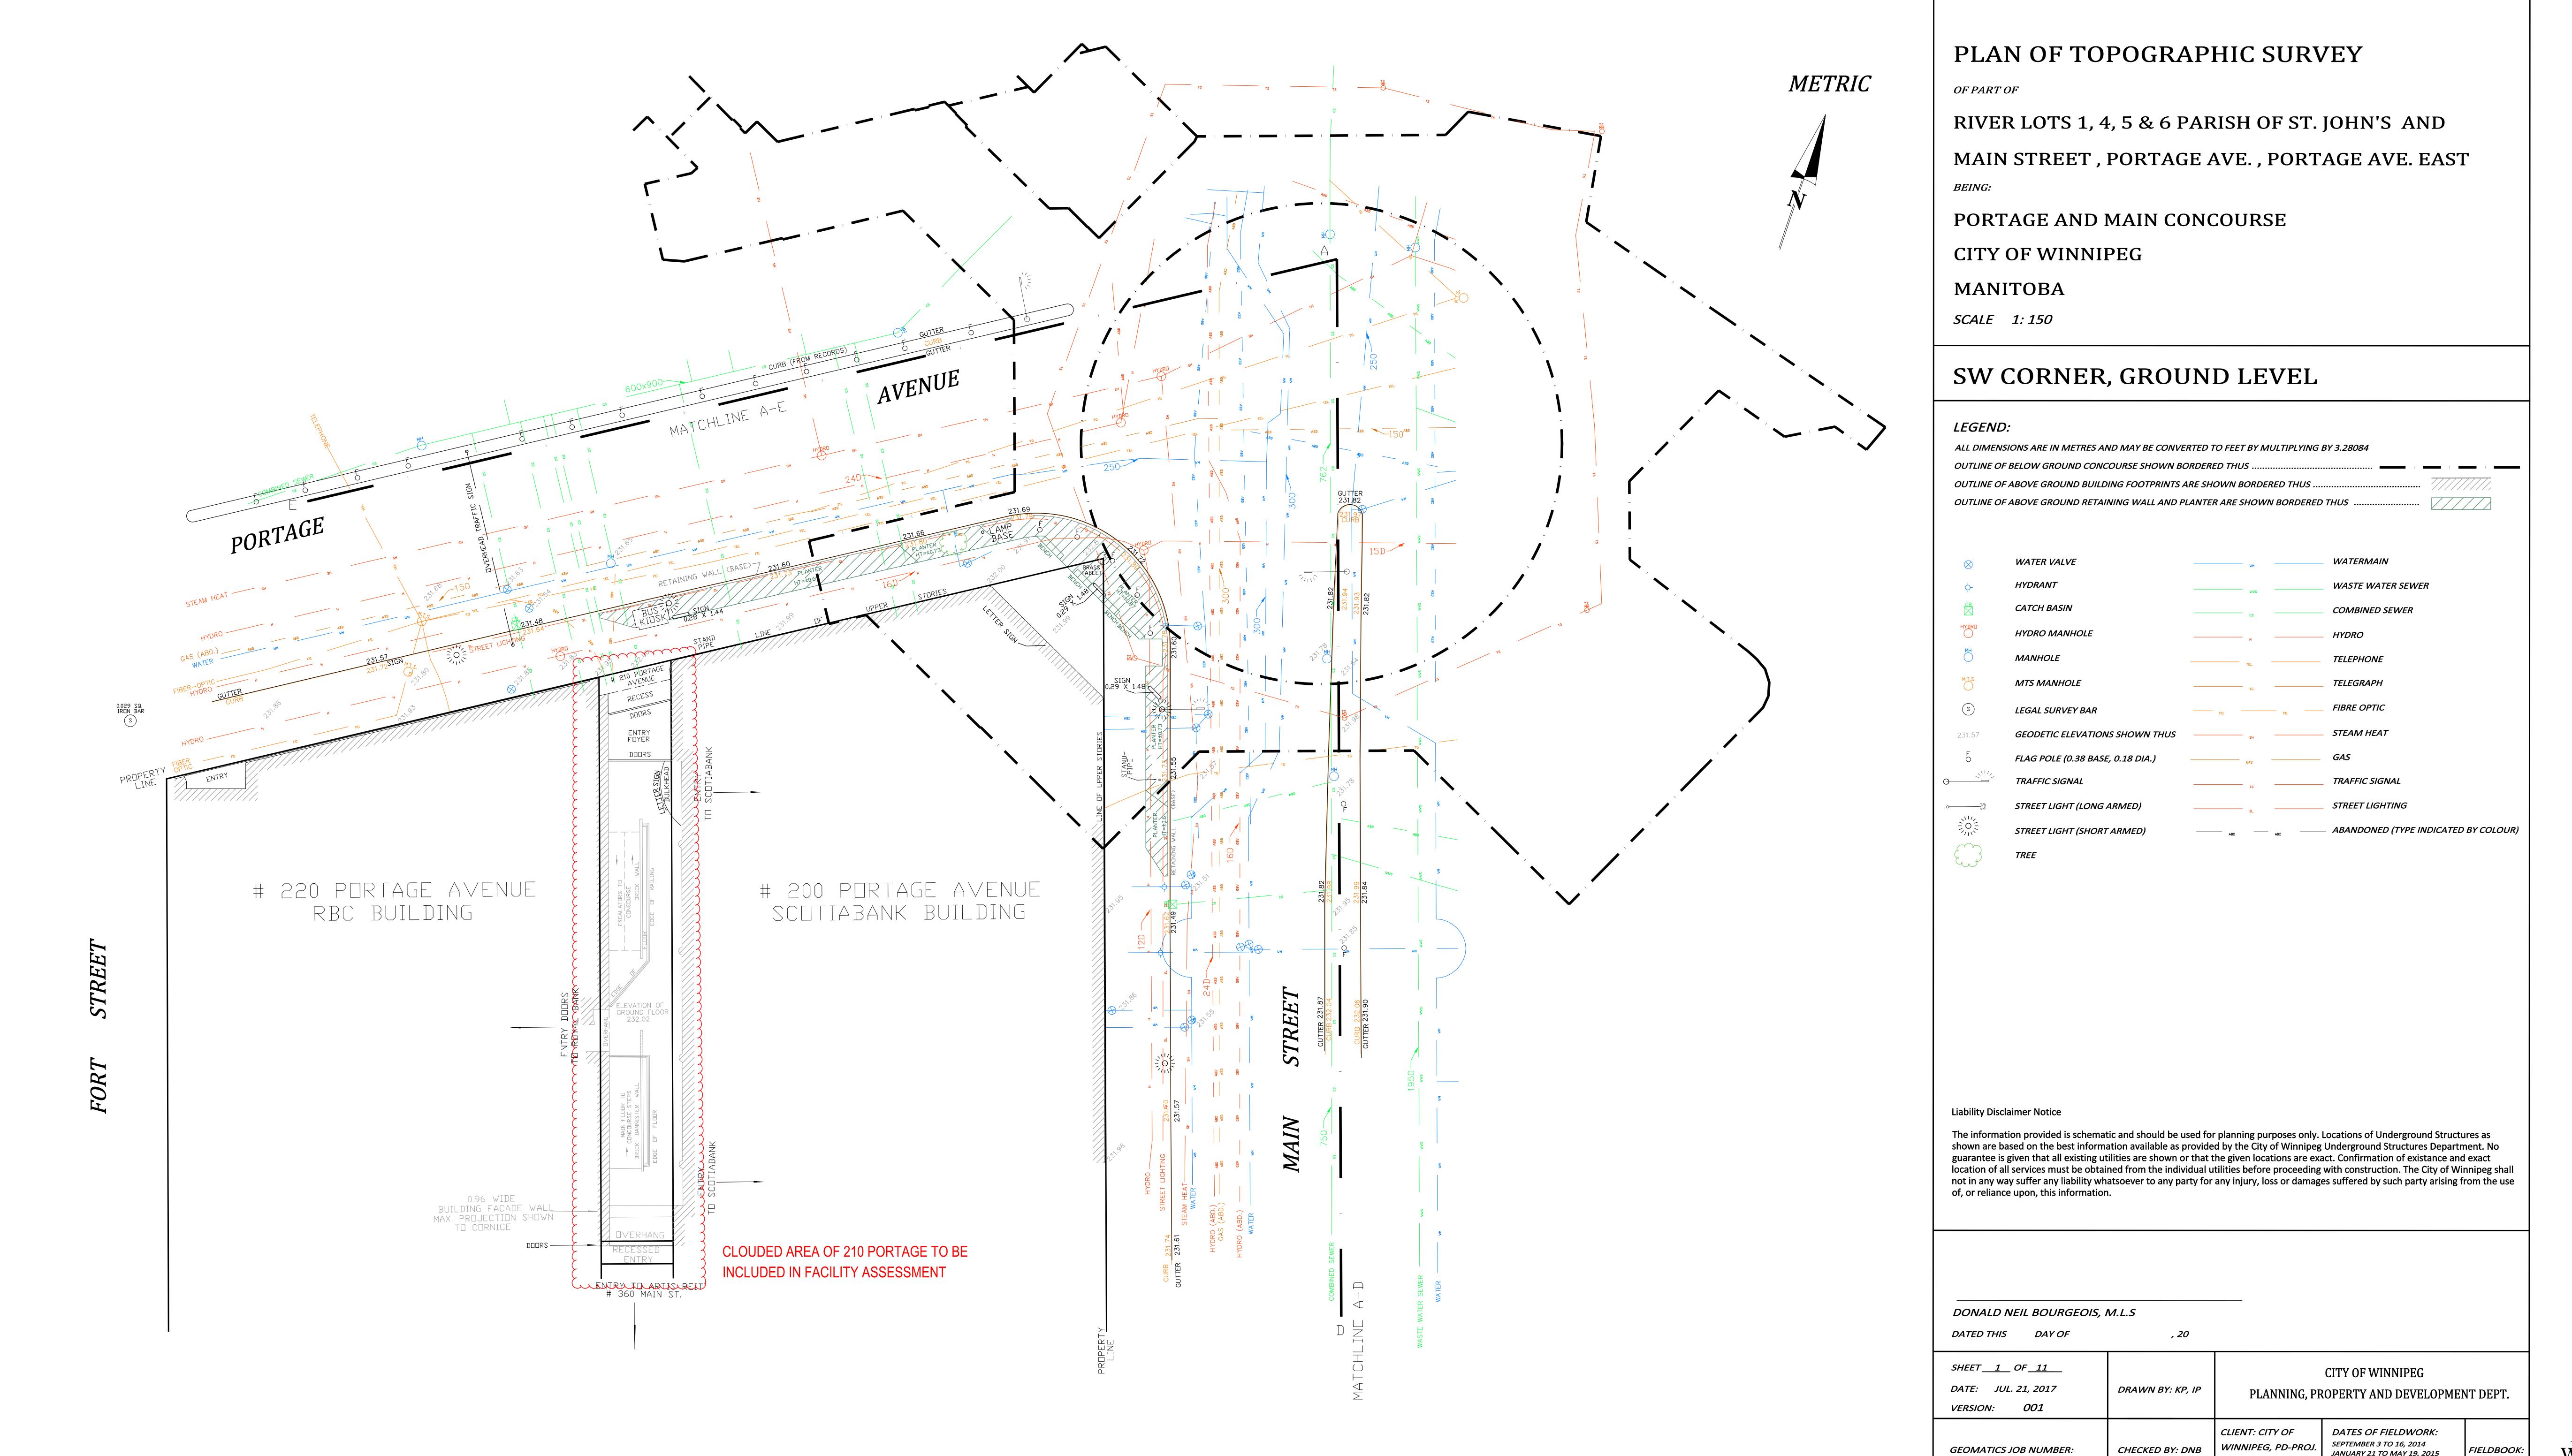



JANUARY 21 TO MAY 19, 2015

SERVICES, B. NOVAK | SEPTEMBER 19 TO 29, 2016

20140189