


NOTE: CHAINAGES SHOWN ARE ALONG  
 CL OF VICTORIA AVENUE EAST

VICTORIA AVENUE EAST



CAUTION: GAS, SL  
 (TYP. FOR ALL)

CAUTION: MTS, WM

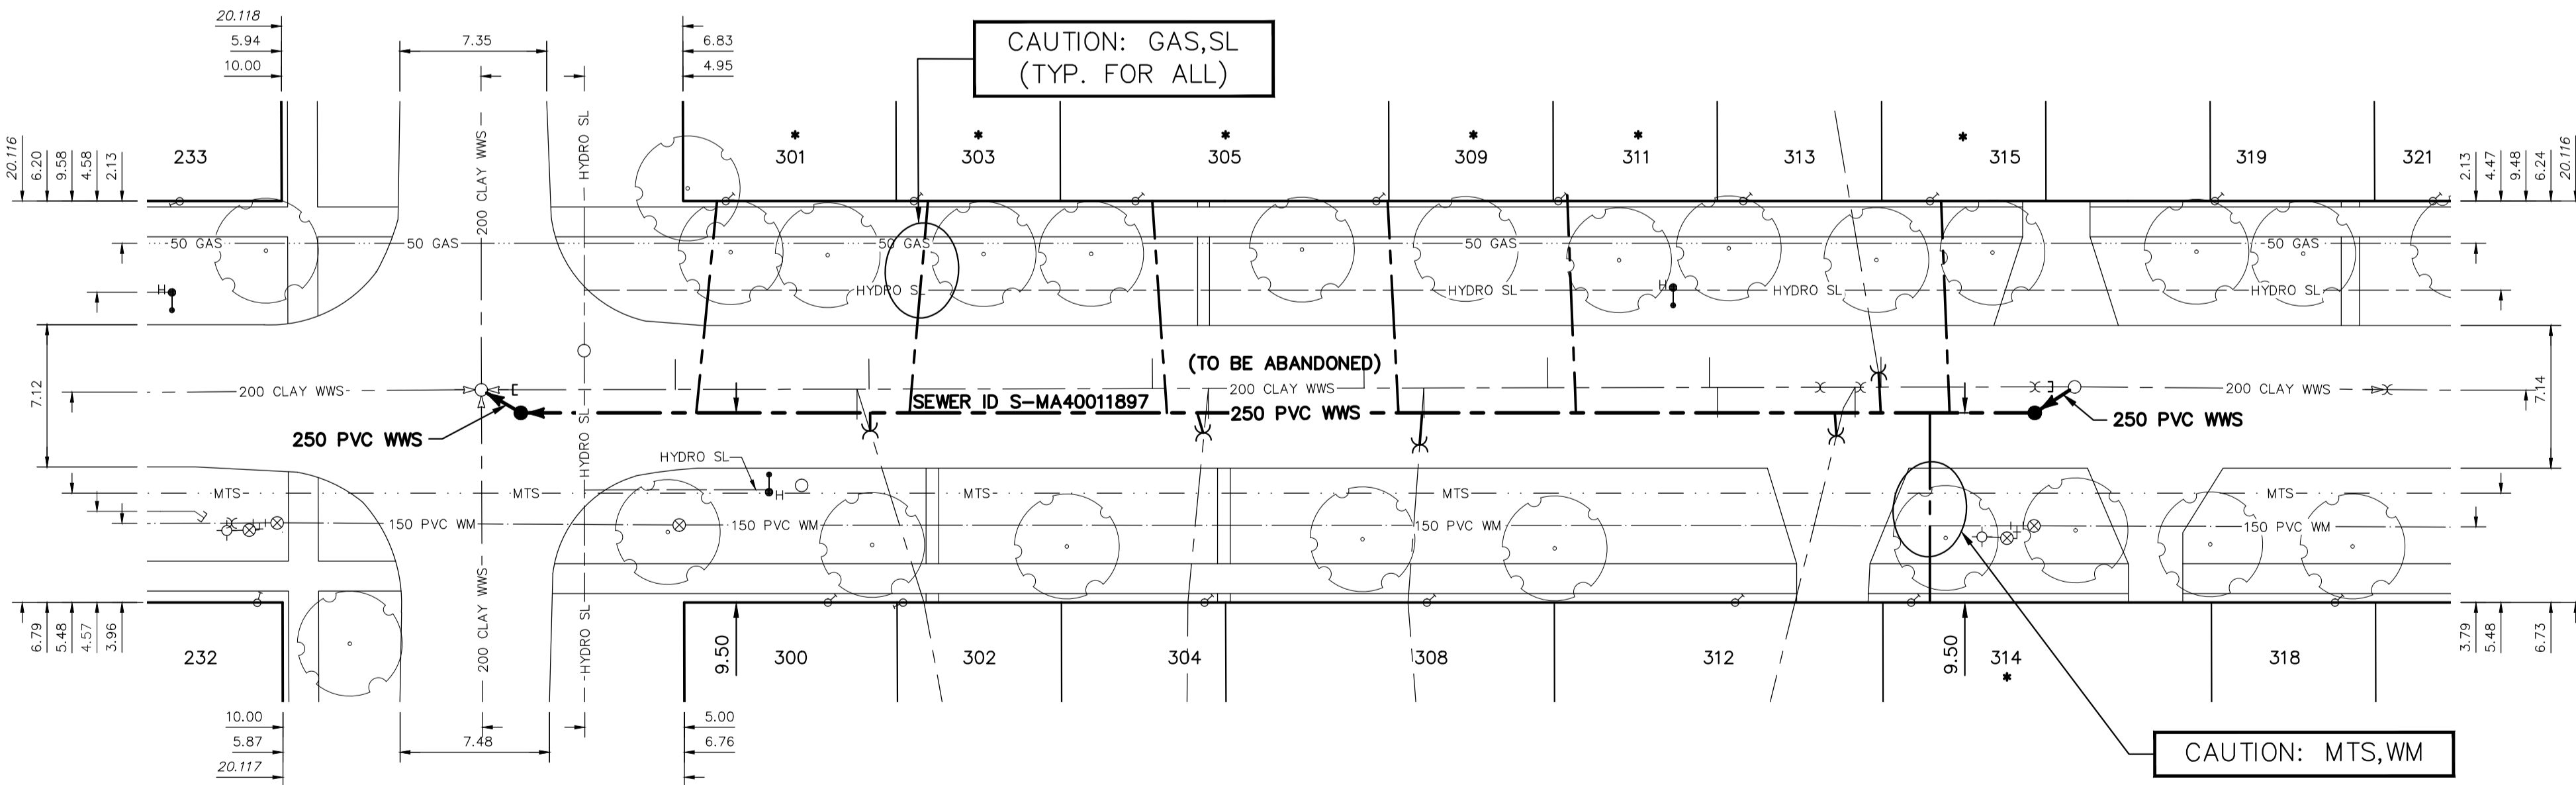

SEWER SERVICE INFORMATION


ADDRESS	SIZE (mm)	R DIST	REMARKS
* 315 VICTORIA AVE E RESIDENTIAL	-	-	RENEW TO R W/150 PVC
* 314 VICTORIA AVE E RESIDENTIAL	-	-	RENEW TO R W/150 PVC
313 VICTORIA AVE E RESIDENTIAL	150 PVC	8.19 E OF WL	RECONNECT TO EXIST 150 PVC
312 VICTORIA AVE E RESIDENTIAL	150 PVC	15.70 E OF WL	RECONNECT TO EXIST 150 PVC
* 311 VICTORIA AVE E RESIDENTIAL	-	-	RENEW TO R W/150 PVC
* 309 VICTORIA AVE E RESIDENTIAL	-	-	RENEW TO R W/150 PVC
308 VICTORIA AVE E RESIDENTIAL	150 PVC	9.93 E OF WL	RECONNECT TO EXIST 150 PVC
* 305 VICTORIA AVE E RESIDENTIAL	-	-	RENEW TO R W/150 PVC
304 VICTORIA AVE E RESIDENTIAL	150 PVC	7.36 E OF WL	RECONNECT TO EXIST 150 PVC
* 303 VICTORIA AVE E RESIDENTIAL	-	-	RENEW TO R W/150 PVC
302 VICTORIA AVE E RESIDENTIAL	150 PVC	2.01 W OF WL	RECONNECT TO EXIST 150 PVC
* 301 VICTORIA AVE E RESIDENTIAL	-	-	RENEW TO R W/150 PVC
* 300 VICTORIA AVE E RESIDENTIAL	-	-	RENEW TO R W/150 PVC
			VERIFY SERVICE LOCATION

\* SERVICES TO BE RENEWED TO R. ALL OTHERS TO BE RECONNECTED

SEWER JUNCTION INFORMATION FROM SEWER VIDEO INSPECTION  
 SEWER ID S-MA40011897

DISTANCE FROM MH ID S-MH40010743	DIAMETER	CLOCK
9.2	150	3
11.0	150	10
17.9	150	10
18.3	150	3
26.4	150	3
32.6	150	11
35.6	150	2
43.4	150	10
46.2	150	2
60.4	150	2
61.0	150	10
70.1	150	2

FOR INDEX SEE 12039

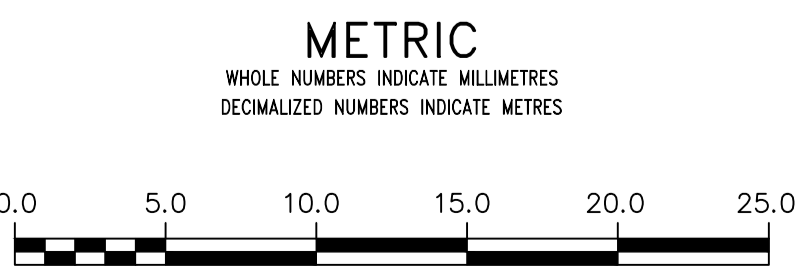

**WARNING**  
 IF POWER EQUIPMENT OR EXPLOSIVES ARE TO BE USED FOR EXCAVATION ON THIS PROJECT THE CONTRACTOR MUST:  
 1) NOTIFY THE GAS COMPANY OF THE PROPOSED LOCATION OF EXCAVATION.  
 2) TAKE PRECAUTION TO AVOID DAMAGE TO GAS COMPANY INSTALLATIONS.  
 SEE PROVINCIAL REGULATION 210/72 FOR DETAILS

**LOCATION APPROVED UNDERGROUND STRUCTURES**  
 SUPV. U/G STRUCTURES COMMITTEE DATE  
 NOTE:  
 LOCATION OF UNDERGROUND STRUCTURES AS SHOWN ARE BASED ON THE BEST INFORMATION AVAILABLE BUT NO GUARANTEE IS GIVEN THAT ALL EXISTING UTILITIES ARE SHOWN OR THAT THE GIVEN LOCATIONS ARE EXACT. CONFIRMATION OF EXISTENCE AND EXACT LOCATION OF ALL UTILITIES MUST BE OBTAINED FROM THE INDIVIDUAL UTILITIES BEFORE PROCEEDING WITH CONSTRUCTION.

NO.	REVISIONS	DATE	BY
1	PIPE UPGRADED TO 250	19/02/01	RS

DESIGNED BY	TGS	CHECKED BY	SC
DRAWN BY	AJ	APPROVED BY	KZ
SCALE:	HORIZONTAL 1:250 VERTICAL 1:50		
DATE	2019 02 05	RELEASED FOR CONSTRUCTION	K.ZUREK
DATE	2019 02 05	DATE	2019/02/05

ENGINEER'S SEAL  
 ORIGINAL SIGNED BY  
 S.R.J. COURNOYER  
 19/02/01  
 CONSULTANT DRAWING NUMBER

**THE CITY OF WINNIPEG**  
 WATER AND WASTE DEPARTMENT  
 ENGINEERING DIVISION

2018 SEWER MAIN RENEWALS  
 CONTRACT 9

**VICTORIA AVENUE EAST**  
 1ST MH W OF ROANOKE STREET TO  
 MH AT WABASHA STREET

SHEET 20 OF 24  
 CITY DRAWING NUMBER 12057