


INSTRUMENT LOOP DIAGRAM

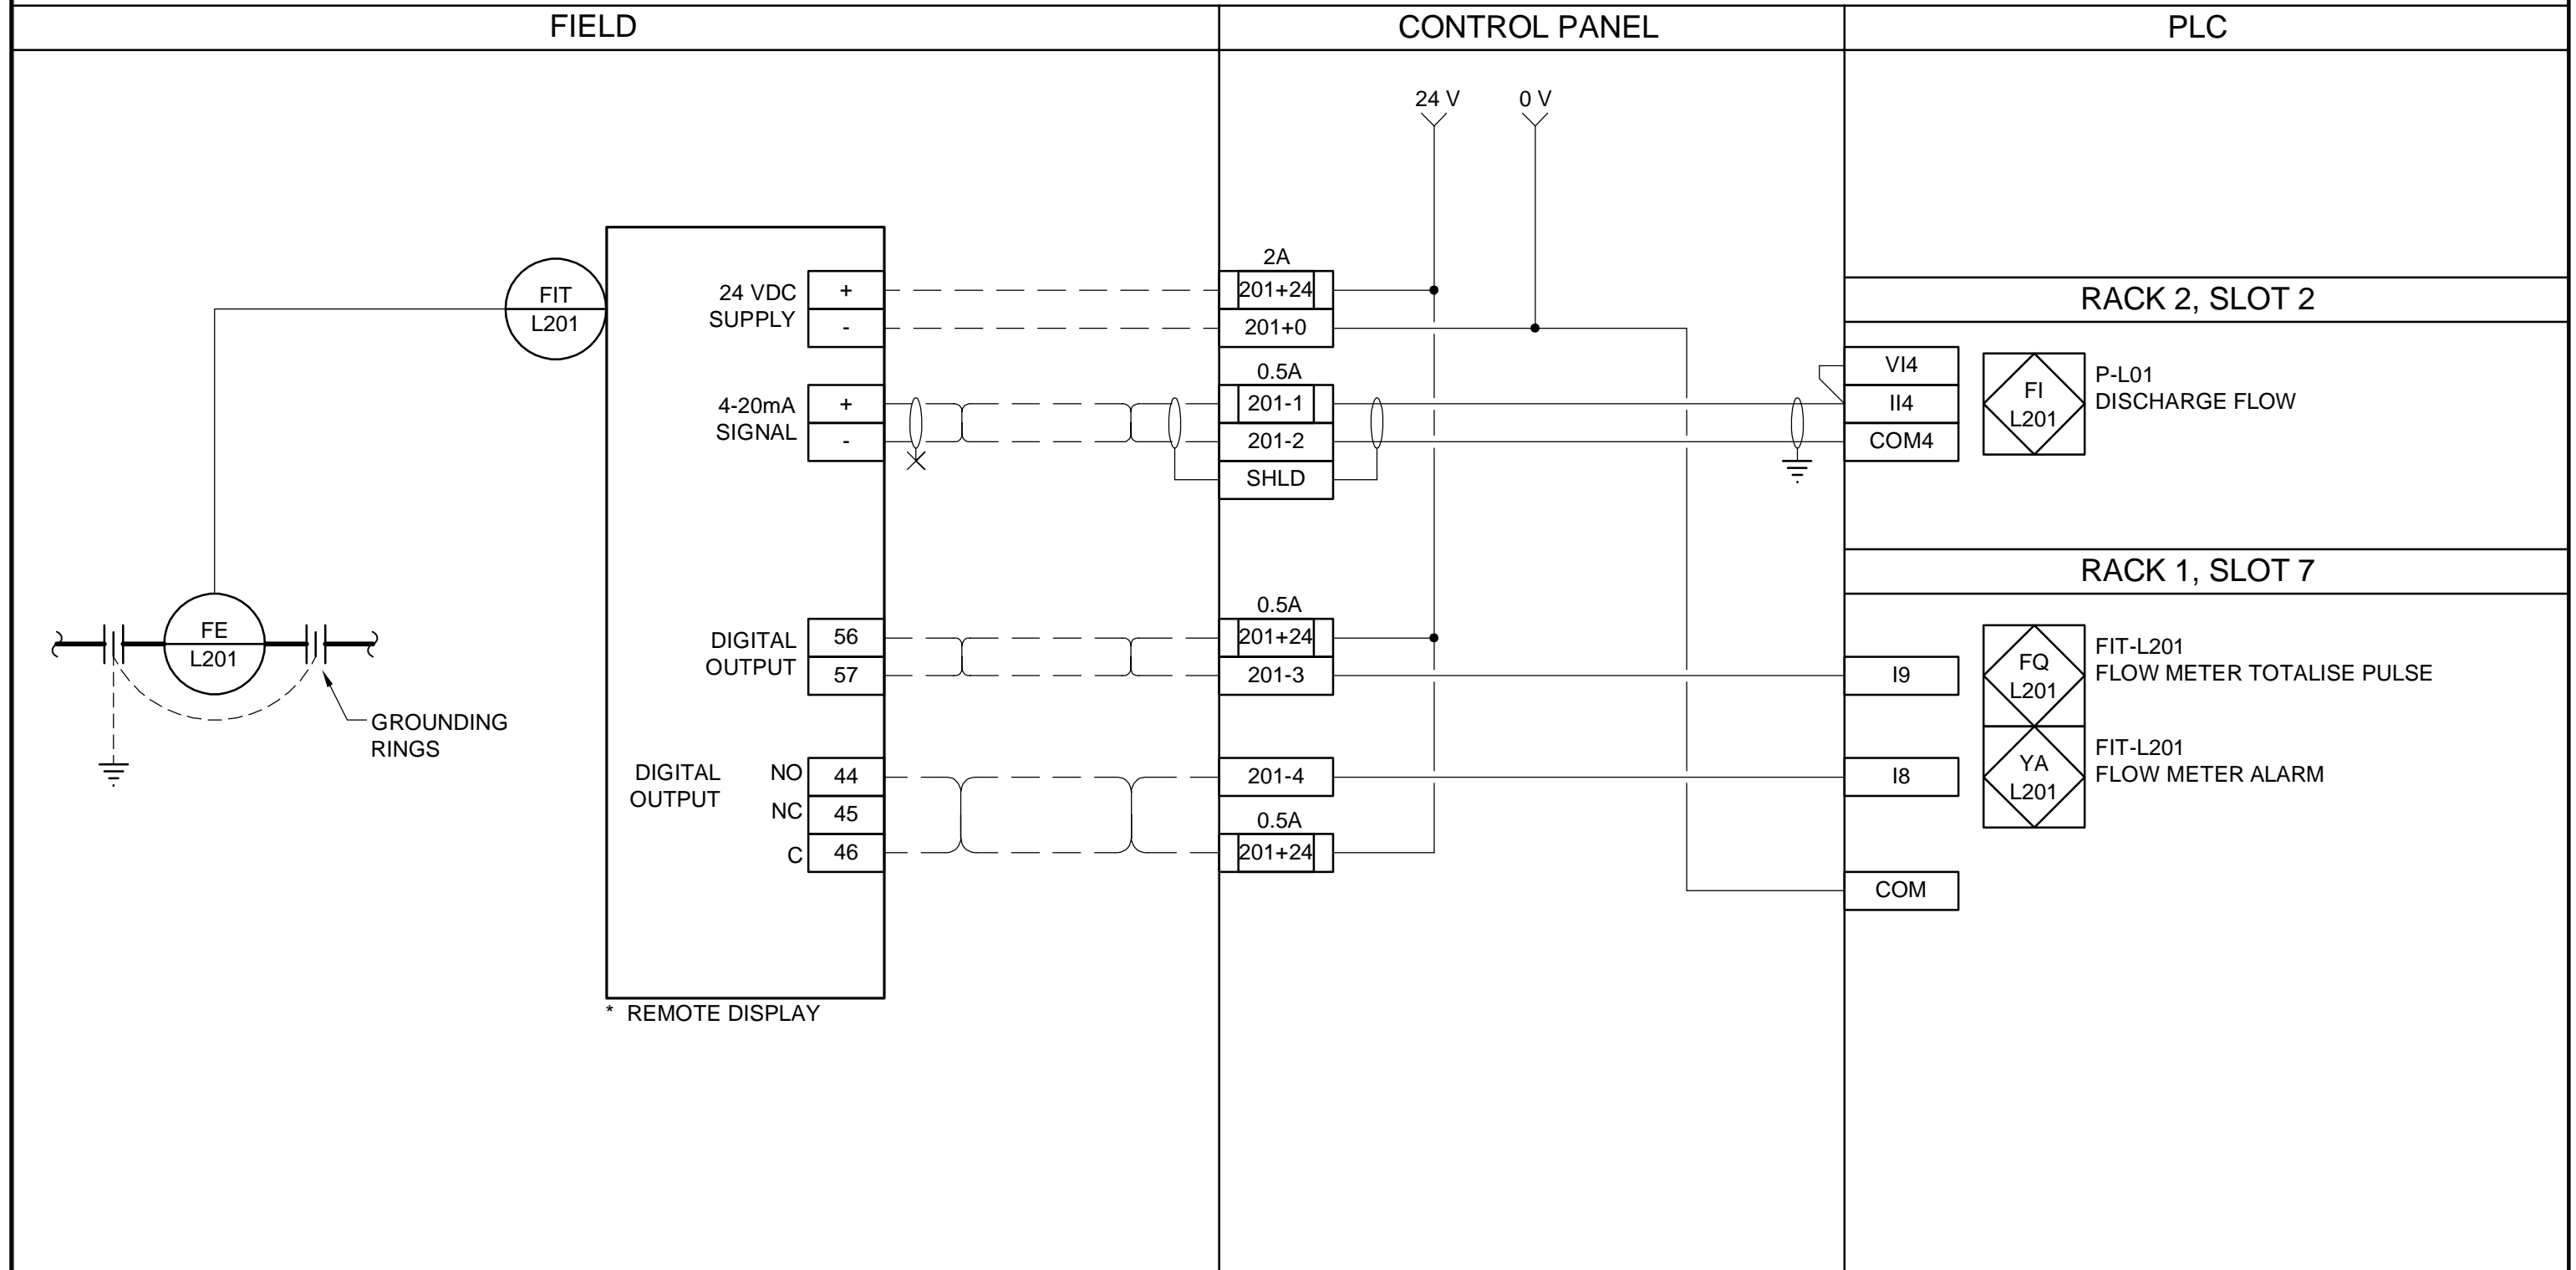

<p>PRELIMINARY ONLY NOT FOR CONSTRUCTION</p> <p>Certificate of Authorization Dillon Consulting Limited (MB) No. 1789 Date: _____</p>	B.M. ELEV. _____ CONSTRUCTION COMPLETION DATE: YYYY MM DD _____	 DESIGNED BY: CAL CHECKED BY: BLM DRAWN BY: SCK APPROVED BY: BLM SCALE: HORIZONTAL: NTS RELEASED FOR CONSTRUCTION VERTICAL: _____ DATE: 2019 09 30 DATE: _____	ENGINEER'S SEAL _____ CONSULTANT PROJECT NUMBER 199259	 THE CITY OF WINNIPEG WATER AND WASTE DEPARTMENT ENGINEERING DIVISION JESSIE WASTEWATER PUMPING STATION UPGRADES FLOW METER FAULT AND FLOW FE/FIT-L201 (TYPICAL)	SHEET 06 of 10 CONSULTANT DRAWING NUMBER L-06 CITY DRAWING NUMBER 1-0149L-E0014-001
	0 ISSUED FOR ADDENDUM 3 2019-09-30 B.L.M.		NO. _____ REVISIONS _____ DATE _____ BY _____		PLOT DATE: 2019 09 30 BID OPPORTUNITY: _____ CONTRACT NUMBER: X