


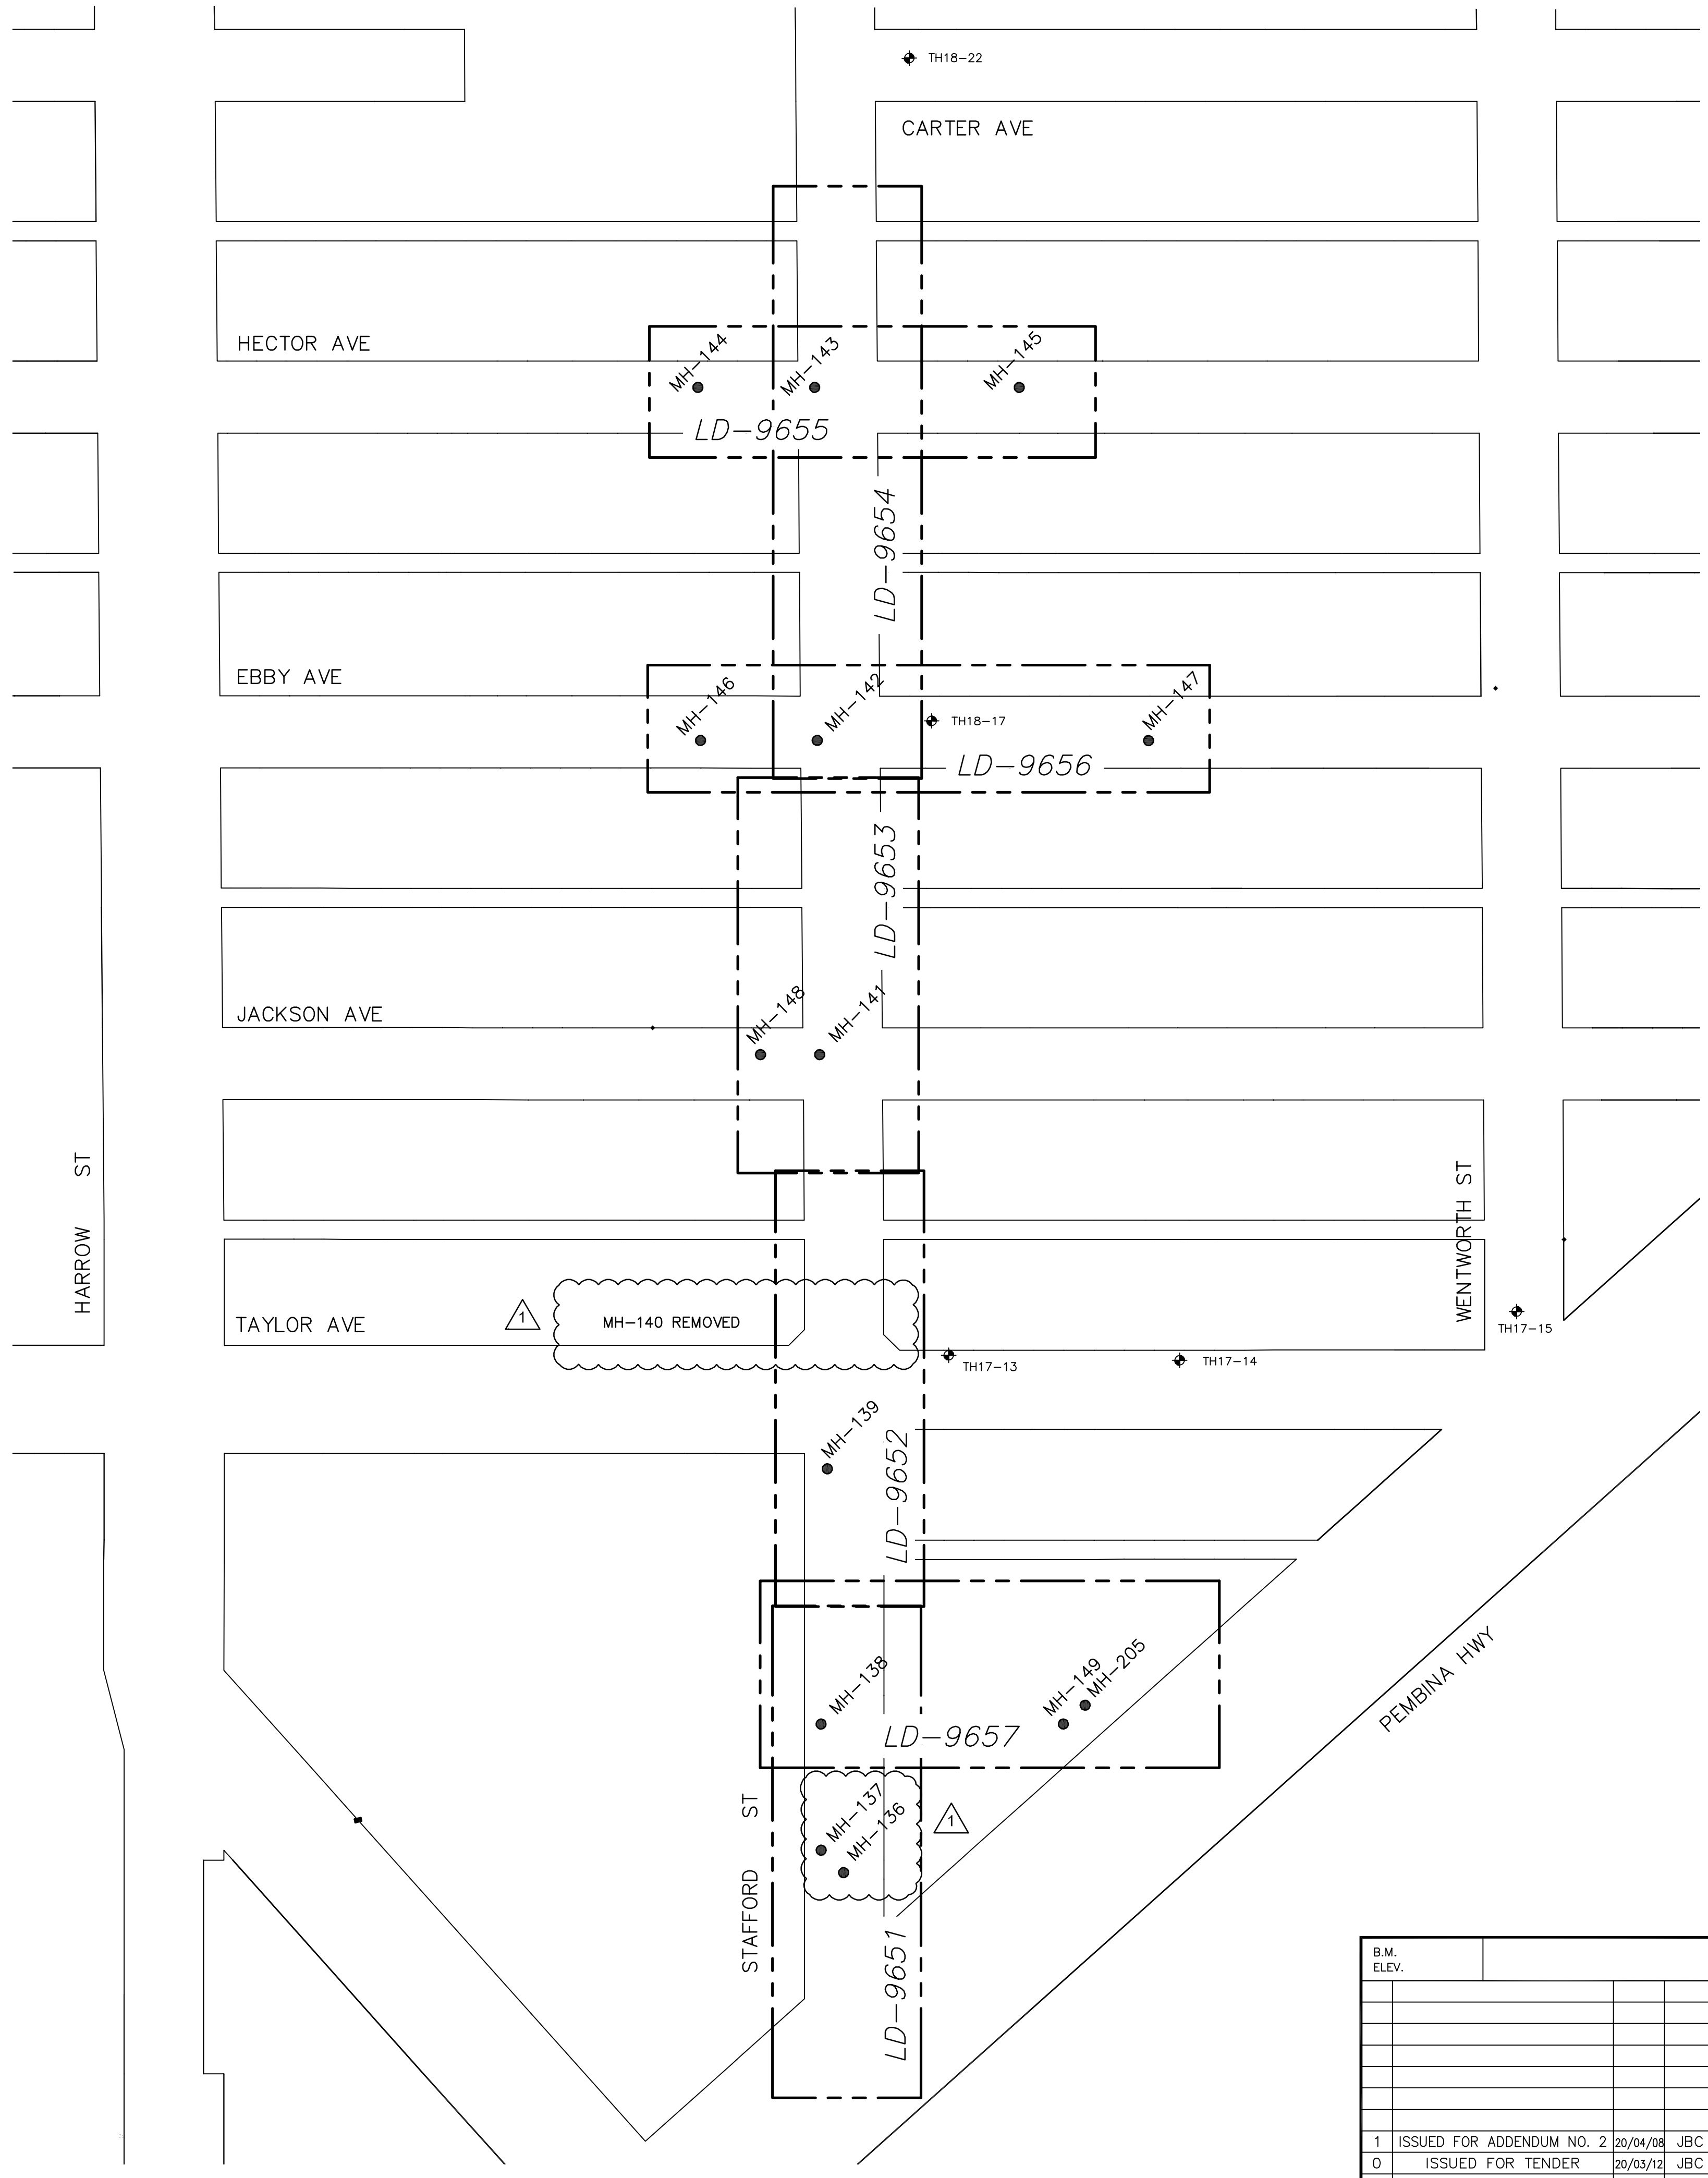

MANHOLE SCHEDULE		
REFERENCE	NORTHING	EASTING
MH-136	5524373.085	632793.721
MH-137	5524375.333	632786.002
MH-138	5524403.385	632770.604
MH-139	5524460.911	632740.850
MH-141	5524552.087	632688.622
MH-142	5524621.673	632649.766
MH-143	5524699.865	632606.122
MH-144	5524685.632	632580.163
MH-145	5524724.818	632651.631
MH-146	5524607.429	632623.809
MH-147	5524662.048	632723.466
MH-148	5524544.877	632675.469
MH-149	5524432.949	632824.480
MH-205	5524439.774	632827.031



TESTHOLE SCHEDULE		
TH NO.	NORTHING	EASTING
TH17-13	5524501.00	632754.00
TH17-14	5524528.00	632806.00
TH17-15	5524580.00	632875.00
TH18-17	5524639.95	632672.84
TH18-18	5524945.19	632704.72
TH18-19	5525047.51	632890.53
TH18-21	5524807.61	632945.65
TH18-22	5524784.62	632587.01
TH18-23	5525034.10	633041.99
TH18-24	5525256.85	633128.65



THE CITY OF WINNIPEG
 WATER AND WASTE DEPARTMENT

PROJECT TITLE
COCKBURN AND CALROSSIE COMBINED SEWER RELIEF WORKS - CONTRACT 10A

SHEET 3 OF 11
 COMPUTER FILE NAME: D-1001.dwg
 CITY DRAWING NUMBER: LD-9650

KEY PLAN AND MANHOLE SCHEDULE

B.M. ELEV.					
DESIGNED BY: SDG		CHECKED BY: MD		ENGINEER'S SEAL	
DRAWN BY: JBC		APPROVED BY: RBO (KGS GROUP)		ORIGINAL SIGNED BY S.D. GODON ON 2020/03/13	
HOR. SCALE: NTS		RELEASED FOR CONSTRUCTION: KZ		CONSULTANT DRAWING NO. D-1001	
VERTICAL:		DATE: MARCH 13, 2020			
NO.	REVISIONS	DATE	BY	DATE	
1	ISSUED FOR ADDENDUM NO. 2	20/04/08	JBC		
0	ISSUED FOR TENDER	20/03/12	JBC		

File name: C:\pw_workdir\ch2mhill_wbg\jortez\10446359\