

NEW CEILING TILE AREA OUTSIDE OF ROOM TO MATCH EXISTING

NEW CEILING TILE EXISTING TO MATCH

REFLECTED CEILING PLAN

REPLACE ALL DAMAGED OR DIRTY CEILING TILES

REPLACE ALL LIGHT FIXTURES AS SPECIFIED BELOW

NEW CEILING TILES AND GRID TO MATCH EXISTING

RELOCATE LIGHT SWITCHES AS PER THE PLAN

ALL NEW LIGHT FIXTURES AS NOTED BELOW. NEW LIGHT FIXTURE ONLY IN AREAS AS NOTED ON RCP.

SEPARATE PRICE TO REPLACE ALL EXISTING LIGHT FIXTURES WITH NEW AS SPECIFIED BELOW

PH: 483.490.4010 / <https://www.assets.lighting.philips.com/us/content/philips/lighting/795911540f47647626200848200814124>

2x4 pgs. 290554849040UNDM


[https://img35.philips.com/us/content/philipsconsulmer/pepformn0a05/united2020states/00120181214\\_001](https://img35.philips.com/us/content/philipsconsulmer/pepformn0a05/united2020states/00120181214_001)

UPD. EN. US. ELUXGRID\_LED\_2x4.PDF

NEW CEILING TILE - EXISTING TO MATCH

NEW CEILING TILE - EXISTING TO MATCH

NEW CEILING TILE - EXISTING TO MATCH

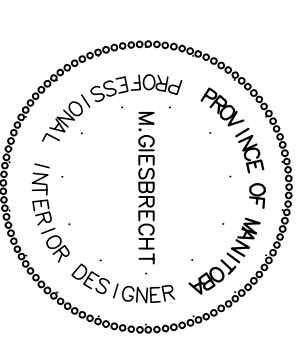

NO.	DATE	DESCRIPTION	BY
R1	APRIL26,2021	AS NOTED ON DRAWING	MG
1	DEC 2020	REDUCTION FOR BUDGET	MG

DRAWN BY  
PRINTING DATE

DRAWINGS & SPECIFICATIONS, AS INSTRUMENTS OF SERVICES ARE SHOWN ON THE PROJECT, ARE THE PROPERTY OF SYNERGY INTERIOR DESIGN INC., THE REPRODUCTION OF ANY PART OF THESE DRAWINGS WITHOUT THE PERMISSION OF SYNERGY INTERIOR DESIGN INC. IS PROHIBITED.

ALL PRINTS TO BE RETURNED.

THE CONTRACTOR IS TO VERIFY DIMENSIONS & DATA NOTED HEREIN WITH CONDITIONS THE SITE & IS HELD RESPONSIBLE FOR REPORTING ANY DISCREPANCY TO THE DESIGNER FOR ADJUSTMENT.

1.D.

**SYNERGY INTERIOR DESIGN INC**

13 Roseworne, Avenue WINNIPEG, MB Canada R2M 0

204.233.9159  
 molina@synergyinteriors.com  
 www.synergyinteriors.com

DATE MARCH 2020 SCALE 1/4" = 1'-0" REVISIONS

DRAWN BY M.G. CHECKED BY M.G.

**MUNROE BRANCH LIBRARY**  
**489 LONDON STREET, WINNIPEG**

REFLECTED CEILING PLAN & LEGEND

AUTOCAD NUMBER DWG. ID-6R1

REFLECTED CEILING PLAN