NOTES

1. Dimensons are in metres unless otherwise noted.
2. Layout to be performed by Contractor using CAD file provided by Contract Administrator.
3. Layout origins to be top of footing of shelter coloumn (TBM1) and nut on bridge railing (TBM2)

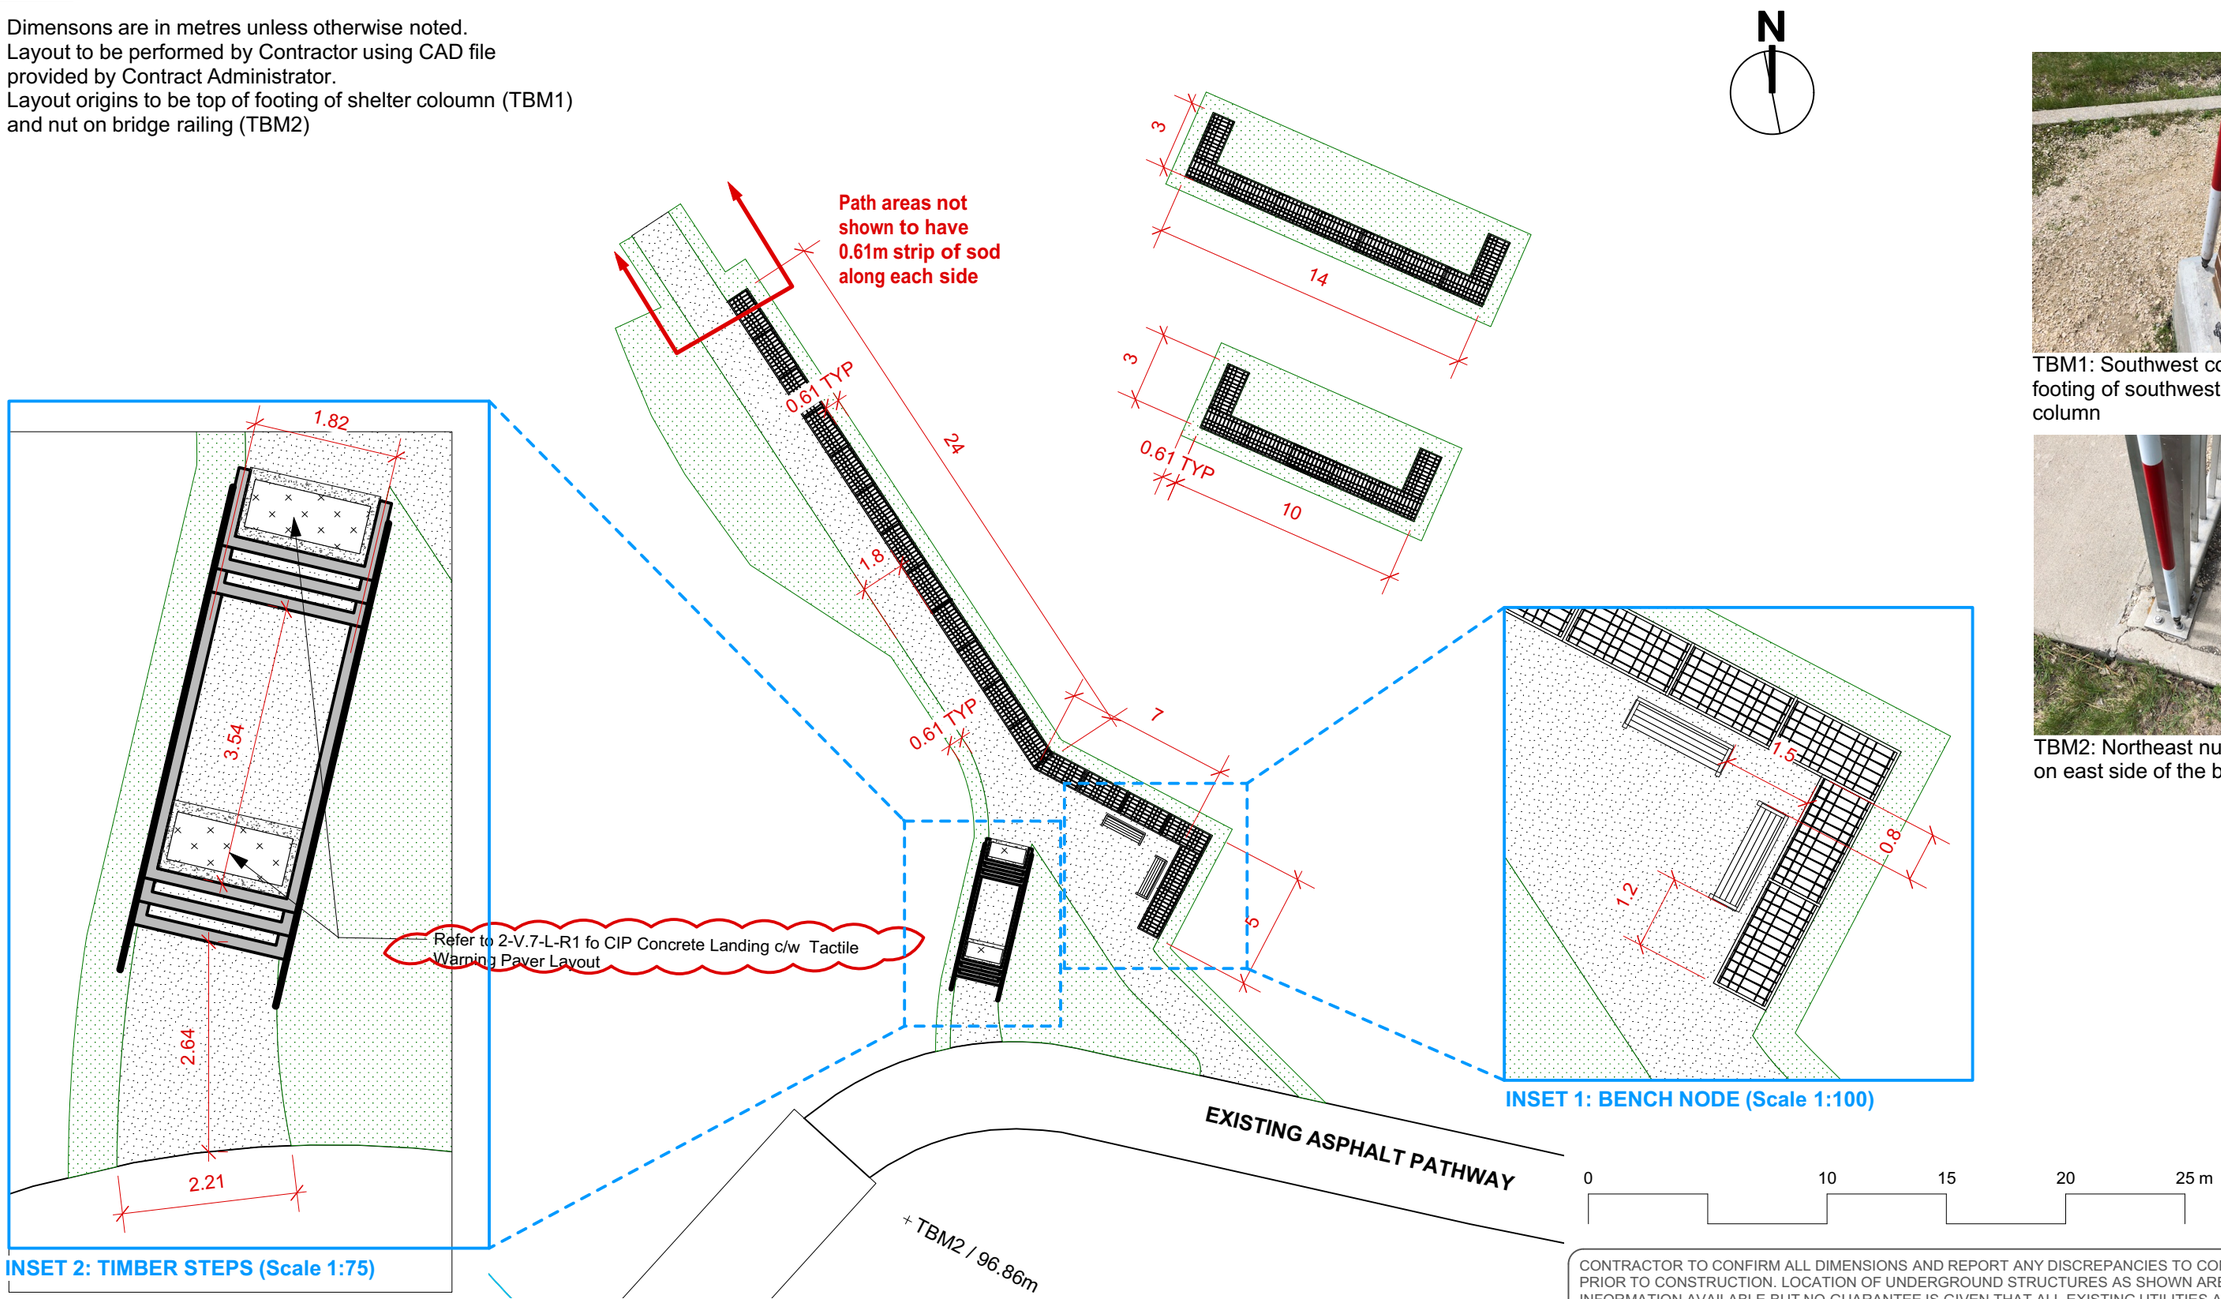


INSET 1: BENCH NODE (Scale 1:100)

INSET 2: TIMBER STEPS (Scale 1:75)

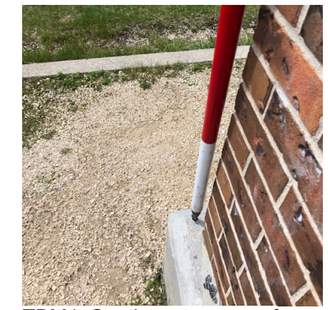

TBM1: Southwest corner of footing of southwest shelter column

TBM2: Northeast nut of railing on east side of the bridge

CONTRACTOR TO CONFIRM ALL DIMENSIONS AND REPORT ANY DISCREPANCIES TO CONTRACT ADMINISTRATOR PRIOR TO CONSTRUCTION. LOCATION OF UNDERGROUND STRUCTURES AS SHOWN ARE BASED ON THE BEST INFORMATION AVAILABLE BUT NO GUARANTEE IS GIVEN THAT ALL EXISTING UTILITIES ARE SHOWN OR THAT THE GIVEN LOCATIONS ARE EXACT. CONFIRMATION OF EXISTENCE AND EXACT LOCATION OF ALL SERVICES MUST BE OBTAINED FROM THE INDIVIDUAL UTILITIES BEFORE PROCEEDING WITH CONSTRUCTION.


Winnipeg

THE CITY OF WINNIPEG
Planning, Property and Development Department
Planning and Land Use Division
Unit 15 - 30 Fort Street, Winnipeg, MB, (R3C 4X5)


| | | | |
|---|---|---|---|
| DESIGNED BY | IM | CHECKED BY | |
| DRAWN BY | IM | APPROVED BY | |
| HORIZ. SCALE | 1:250 | | |
| VERT. SCALE | | | |
| DATE | July 2020 | | |

MANAGER, PARK AND OPEN SPACES — DATE

MANAGER, PLANNING AND LAND USE DIVISION — DATE

DRAWING TITLE

**VAN WALLEGHEM PARK**

**PATHWAY IMPROVEMENTS**

Layout Plan

SITE ADDRESS 37 Lindenwood Drive West

DRAWING NO.

**V.7-K-R1**

ADDENDUM 1

BID OPPORTUNITY NO.

476 -2020