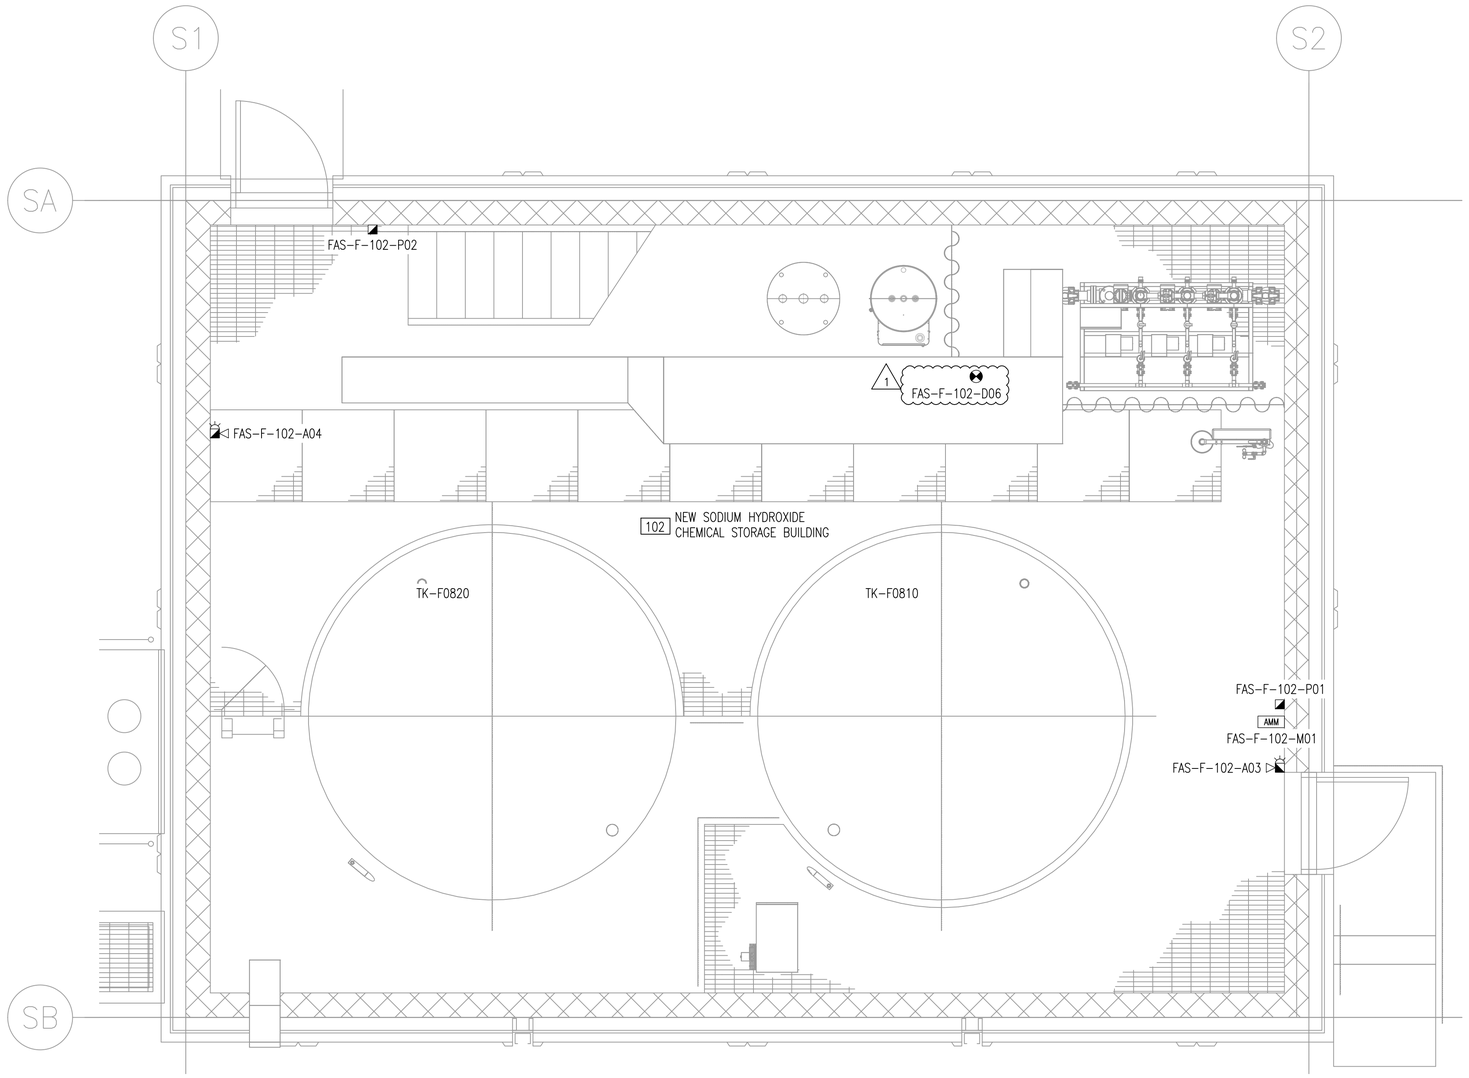

A
–
PLAN – MAIN FLOOR

600 0 600 1200 1800 2400

SCALE: 1:30mm

NO.	DRAWING NUMBER	REFERENCE DRAWING TITLE

REFERENCE DRAWINGS

ENGINEERS GEOSCIENTISTS MANITOBA
Certificate of Authorization
KGS Group
No. 245

B.M.
ELEV.

CONSTRUCTION COMPLETION DATE: YYYY MM DD

NO.	REVISIONS	DATE	BY
1	RE-ISSUED FOR CONSTRUCTION	2022 07 05	JAB
0	ISSUED FOR CONSTRUCTION	2022 05 18	JAB

KGS GROUP

DESIGNED BY	DG	CHECKED BY	JAB
DRAWN BY	RG	APPROVED BY	JAB
SCALE:	AS SHOWN	RELEASED FOR CONSTRUCTION	
DATE	2022 02 28	DATE	

PLOT DATE: 2022 07 12

ENGINEER'S SEAL
PROVINCE OF MANITOBA
BOUCHARD
Member
20560
2022-07-14
REGISTERED PROFESSIONAL ENGINEER

CONSULTANT DRAWING NUMBER
21-0107-015_E2.231

BID OPPORTUNITY: 197-2022
CONTRACT NUMBER:

Winnipeg

THE CITY OF WINNIPEG

WATER AND WASTE DEPARTMENT
ENGINEERING DIVISION

NORTH END SEWAGE TREATMENT PLANT (NEWPCC)
INTERIM PHOSPHOROUS REMOVAL
ELECTRICAL

BUILDING 102
MAIN FLOOR – FIRE ALARM LAYOUT

CITY DRAWING NUMBER: 1-0101-EFAS-F203-001

SHEET 1 OF 1

FILE PATH: \\192.168.0.226\r-data\Projects\2021\21-0107-015\Dwg\Elec\ADDENDUM\
FILE NAME: 1-0101-EFAS-F203-001.dwg