

PLAN VIEW  
SCALE: 1:25

DETAILS OF PIPING IN MONTCALM PUMPING STATION


NOTE: FOR DETAILS OF EXISTING PIPING IN THE MONTCALM PUMPING STATION SEE INFORMATION DRAWINGS - 1091, 262, 261, 229A

FOR CONTINUATION OF FORCEMAIN SEE DRWG 05356

METRIC  
WHOLE NUMBERS INDICATE MILLIMETRES  
DECIMALIZED NUMBERS INDICATE METRES

WARNING

- IF POWER EQUIPMENT OR EXPLOSIVES ARE TO BE USED FOR EXCAVATION ON THIS PROJECT THE CONTRACTOR
- 1) NOTIFY THE GAS COMPANY OF THE PROPOSED LOCATION OF EXCAVATION.
  - 2) TAKE PRECAUTION TO AVOID DAMAGE TO GAS COMPANY INSTALLATIONS.
- SEE PROVINCIAL REGULATION 210/72 FOR DETAILS

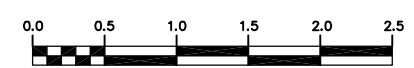

B.M. ELEV.		FIELD BOOK #		<b>CITY OF WINNIPEG</b> <b>WATER AND WASTE</b> <b>ENGINEERING DIVISION</b>		ENGINEER'S SEAL		<b>THE CITY OF WINNIPEG</b> WATER AND WASTE DEPARTMENT	
POSTED TO LBIS						ORIGINAL SIGNED BY K.R. ZUREK 04/01/23			
DESIGNED BY	JE	CHECKED BY	JE	DRAWN BY		APPROVED BY		SHEET 3 OF 4	
				WKT		KZ		CITY DRAWING NUMBER	
HOR. SCALE 1:25		RELEASED FOR CONSTRUCTION		TENDER No. 16-2004		FILENAME: 05358.dwg		05358	
VERTICAL		DATE 2004.01.15		PLOT DATE: 2004 01 23					
1.) CHANGED SOUTH PIPE ALIGNMENT 04.01.23 WKT									
NO. REVISIONS		DATE BY							