


FOR TEMPLATE SEE DWG. TE-554

NOTE
AWWA C-301 TYPE B SPECIAL
USE KALICRETE TYPE 5 CEMENT

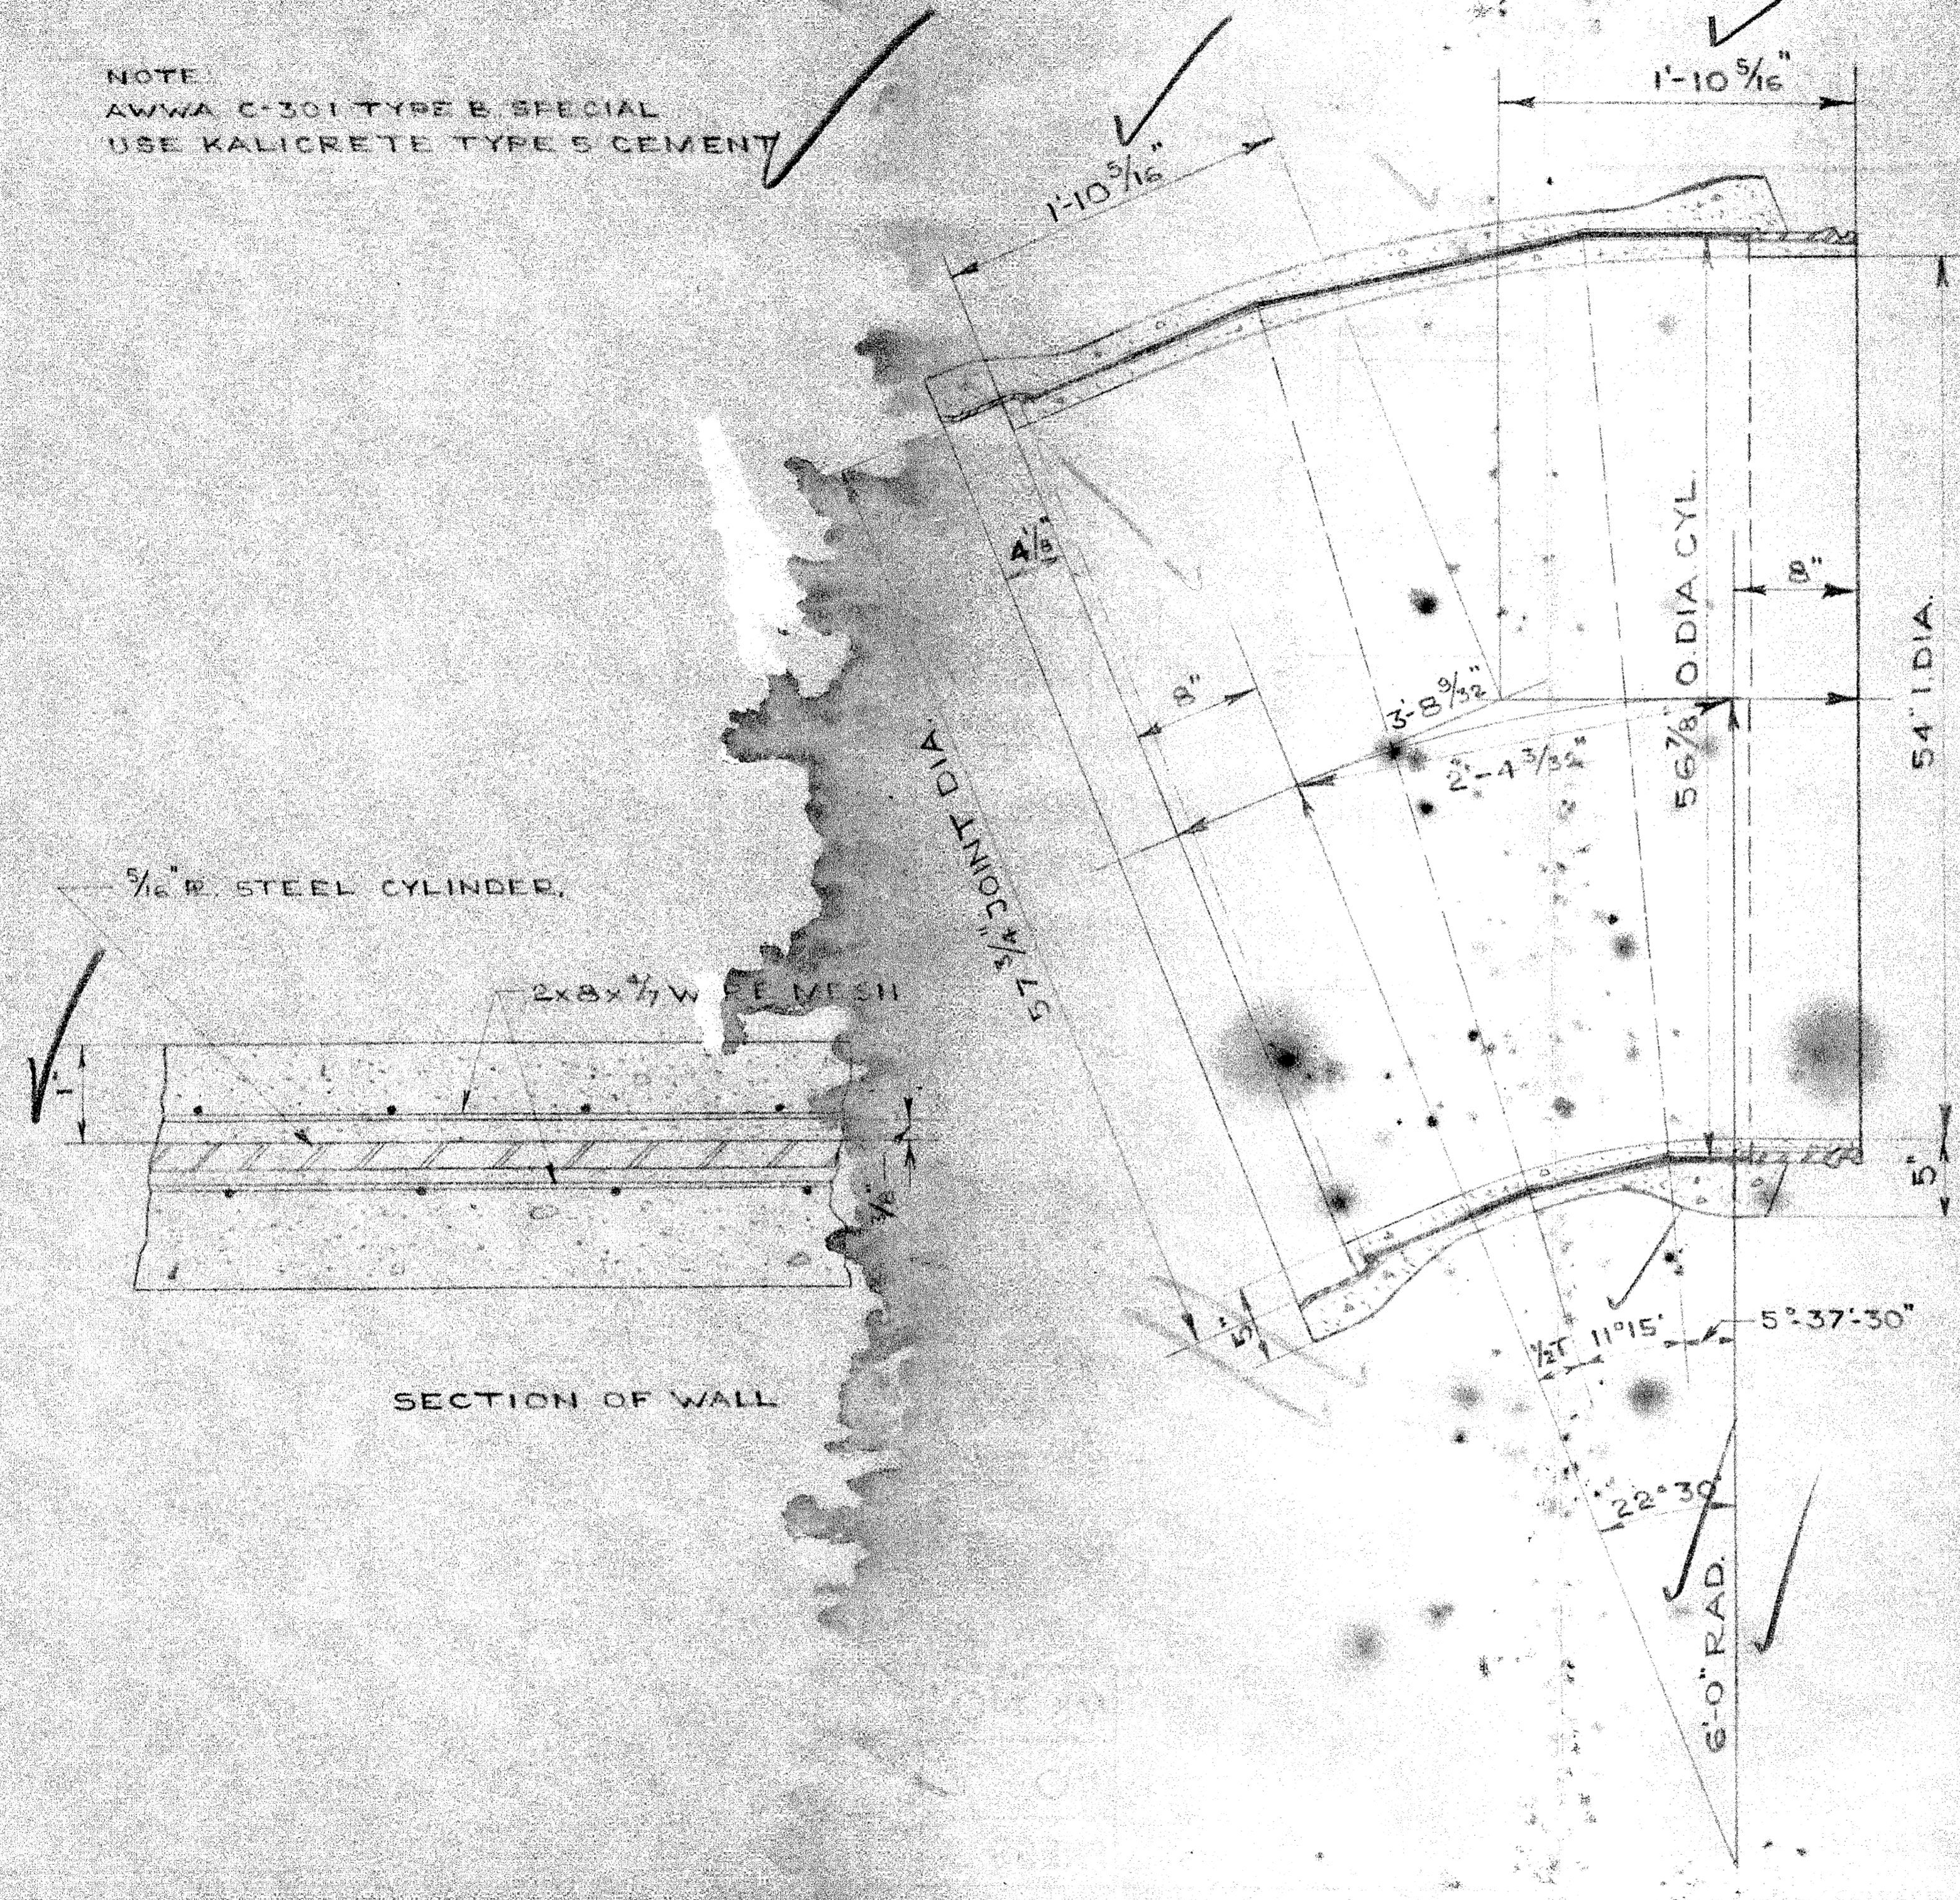

APPROVED FOR CONSTRUCTION
M.S. Butler Date JAN 29 1963
 Approval of this drawing covers only the general design and arrangement of material or equipment and does not in any way relieve the Contractor of any liability or responsibility for the satisfactory operation of this installation.

PRESSURE PIPE DIVISION
 CANADA IRON FOUNDRIES LTD.
 54" DIA. 22°30' ELBOW.
 B. & S. ENDS
 METRO WINNIPEG, CONTR 187

NYE-25-A	SCALE: 1"=1'-0"	DWN BY PR	DWG NO REV
MR NO. NYE-25-A	DATE 22-1-63	CKD BY EW	F-3283
PRESS 100F51	J.O. 925	APP BY K	File

MICROFILMED MAR 31 1980

F-992

LOCATION APPROVED UNDERGROUND STRUCTURES SUPR. U/G STRUCTURES COMMITTEE DATE NOTE: LOCATION OF UNDERGROUND STRUCTURES AS SHOWN ARE BASED ON THE BEST INFORMATION AVAILABLE. BUT NO GUARANTEE IS GIVEN THAT ALL EXISTING UTILITIES ARE SHOWN OR THAT THE GIVEN LOCATIONS ARE EXACT. CONFIRMATION OF EXISTENCE AND EXACT LOCATION OF ALL SERVICES MUST BE OBTAINED FROM THE INDIVIDUAL UTILITIES BEFORE PROCEEDING WITH CONSTRUCTION.	BM - : ELEV - :	 www.umagroup.com 2004 UMA ENGINEERING LTD. ALL RIGHTS RESERVED.	PROFESSIONAL'S SEAL	 THE CITY OF WINNIPEG BRANCH II AQUEDUCT INTERCONNECTOR - VALVE CHAMBER	SHEET OF
	NO. REVISIONS YYMMDD BY		DESIGNED BY: MGM CHECKED BY: DRAWN BY: WJd APPROVED BY: HOR. SCALE: 1:500 VERT. SCALE: 1:50 RELEASED FOR CONSTRUCTION DATE		CONSULTANT DRAWING NO. D265-182-00