


APPROX 30360 SQ FT

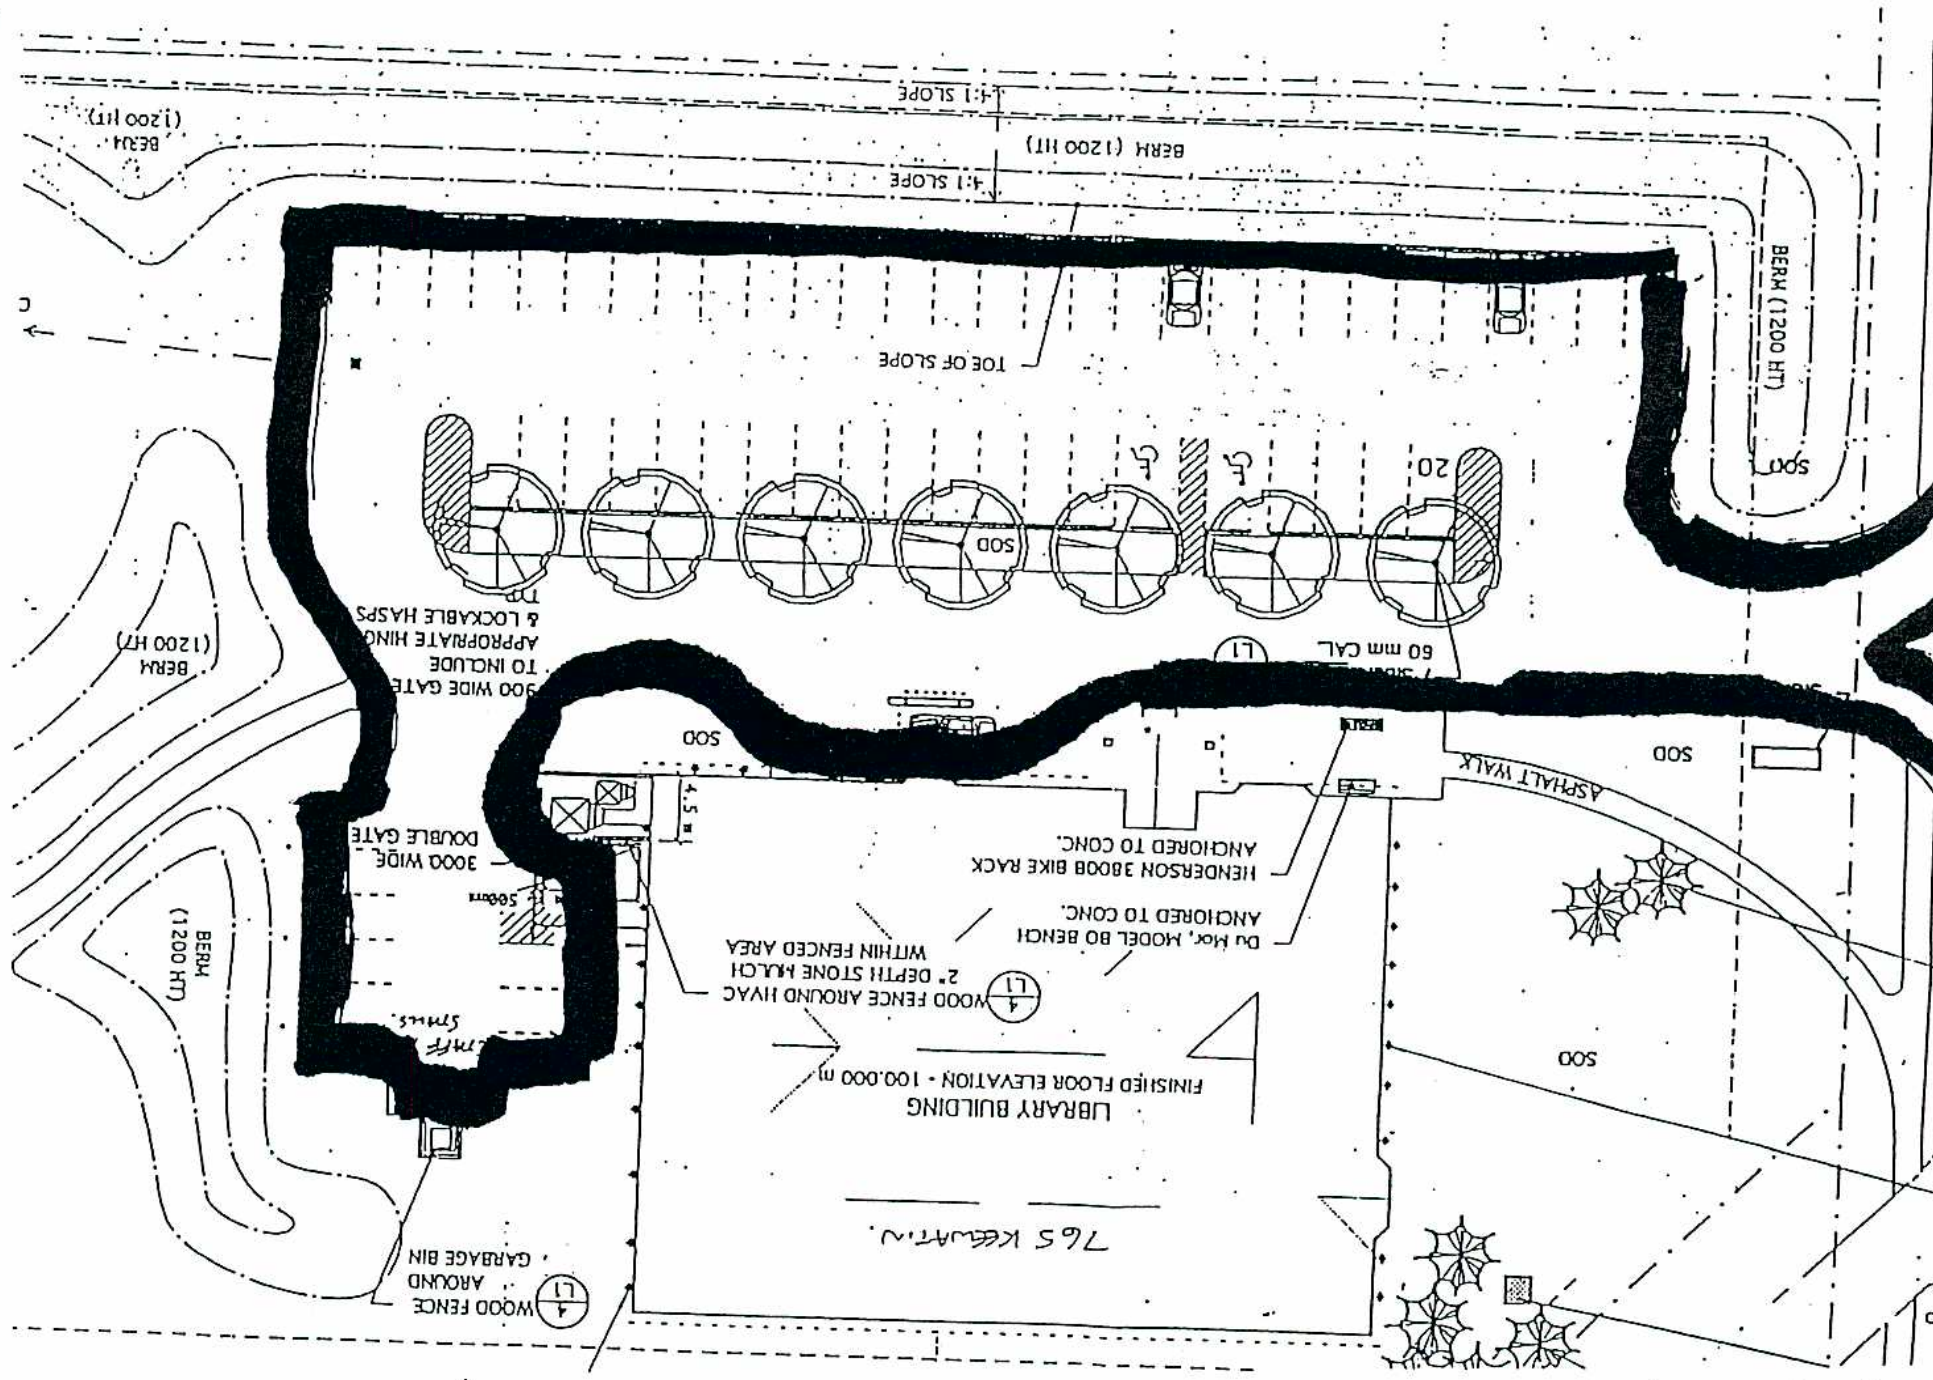

WOOD FENCE AROUND GARBAGE BIN (L1)

GARBAGE BIN

WOOD FENCE AROUND

TO INCLUDE APPROPRIATE HINGES & LOCKABLE HASPS

900 WIDE GATE

DOUBLE GATE

3000 WIDE

BERM (1200 HT)

BERM (1200 HT)

