


SWALES AVENUE

WILLIAMS STREET

60,421 SQ FT

25.66  
acres

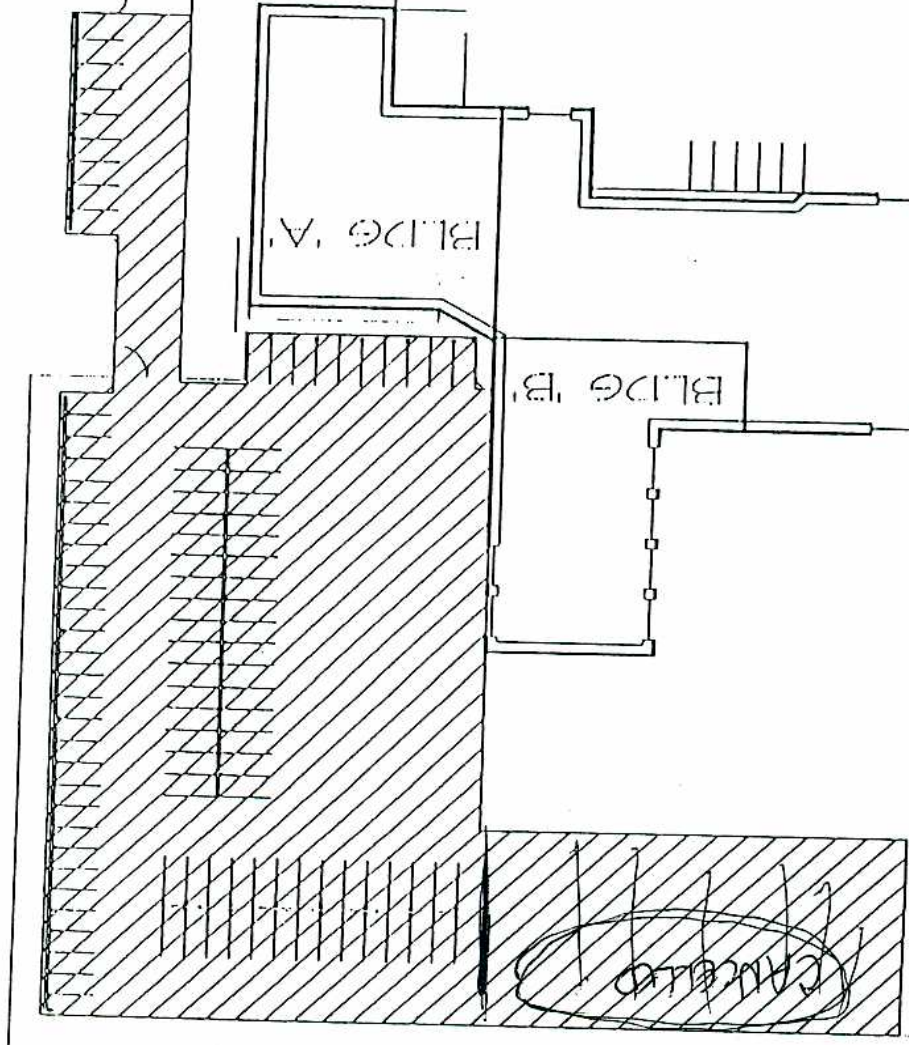

BLDG 'C'

CHURCH