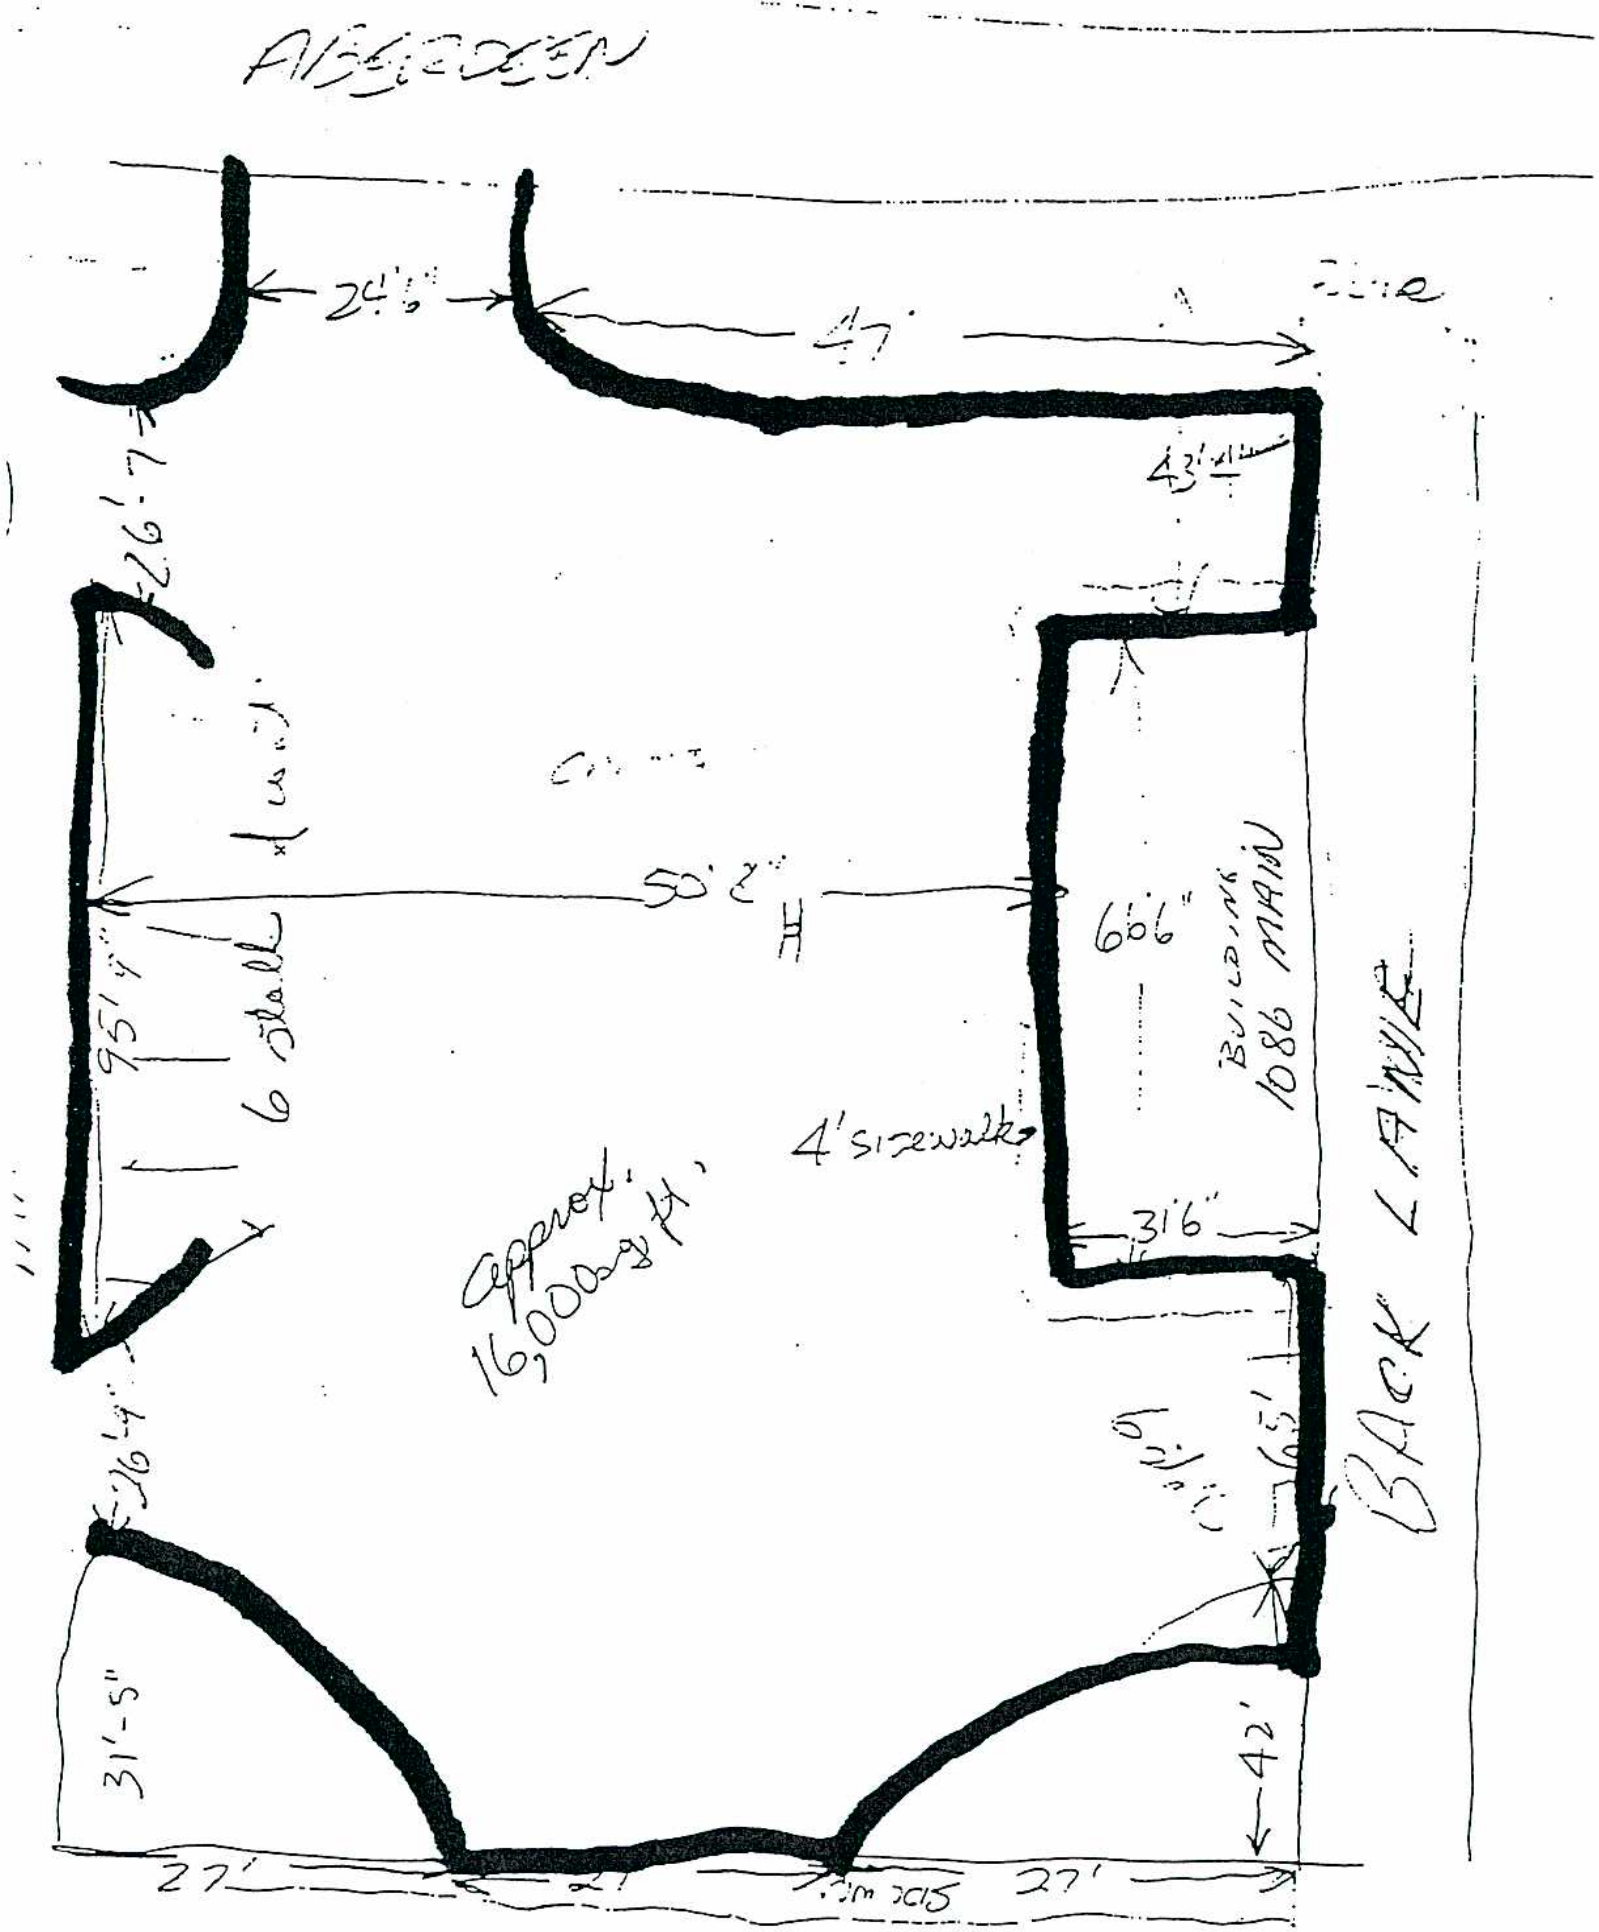


1086 MAIN ST