


FAN AND DUCT REVISION

SCALE NTS

| | | | | | |
|---|--|--------------------------|-----------------------|-------------------|---------------------|
| <p>SMS ENGINEERING</p> <p>SMS Engineering Ltd. Consulting Engineers 770 Bradford Street Winnipeg MB Canada R3H 0N3 Telephone 204.775.0291 Fax 204.772.2153 sms@smseng.com</p> | <p>CONSTRUCTION OF ALTERNATE EMERGENCY COMMUNICATION CENTRE 700 ASSINIBOINE PARK DRIVE WINNIPEG MANITOBA</p> | | FAN AND DUCT CHANGE | | |
| | | | Drawn By RNS | Approved By MA | Reference 5015M1 |
| | File No. 05-015-01 | Setup Date MARCH 2006 | Detail Sheet MDR-1 | | |

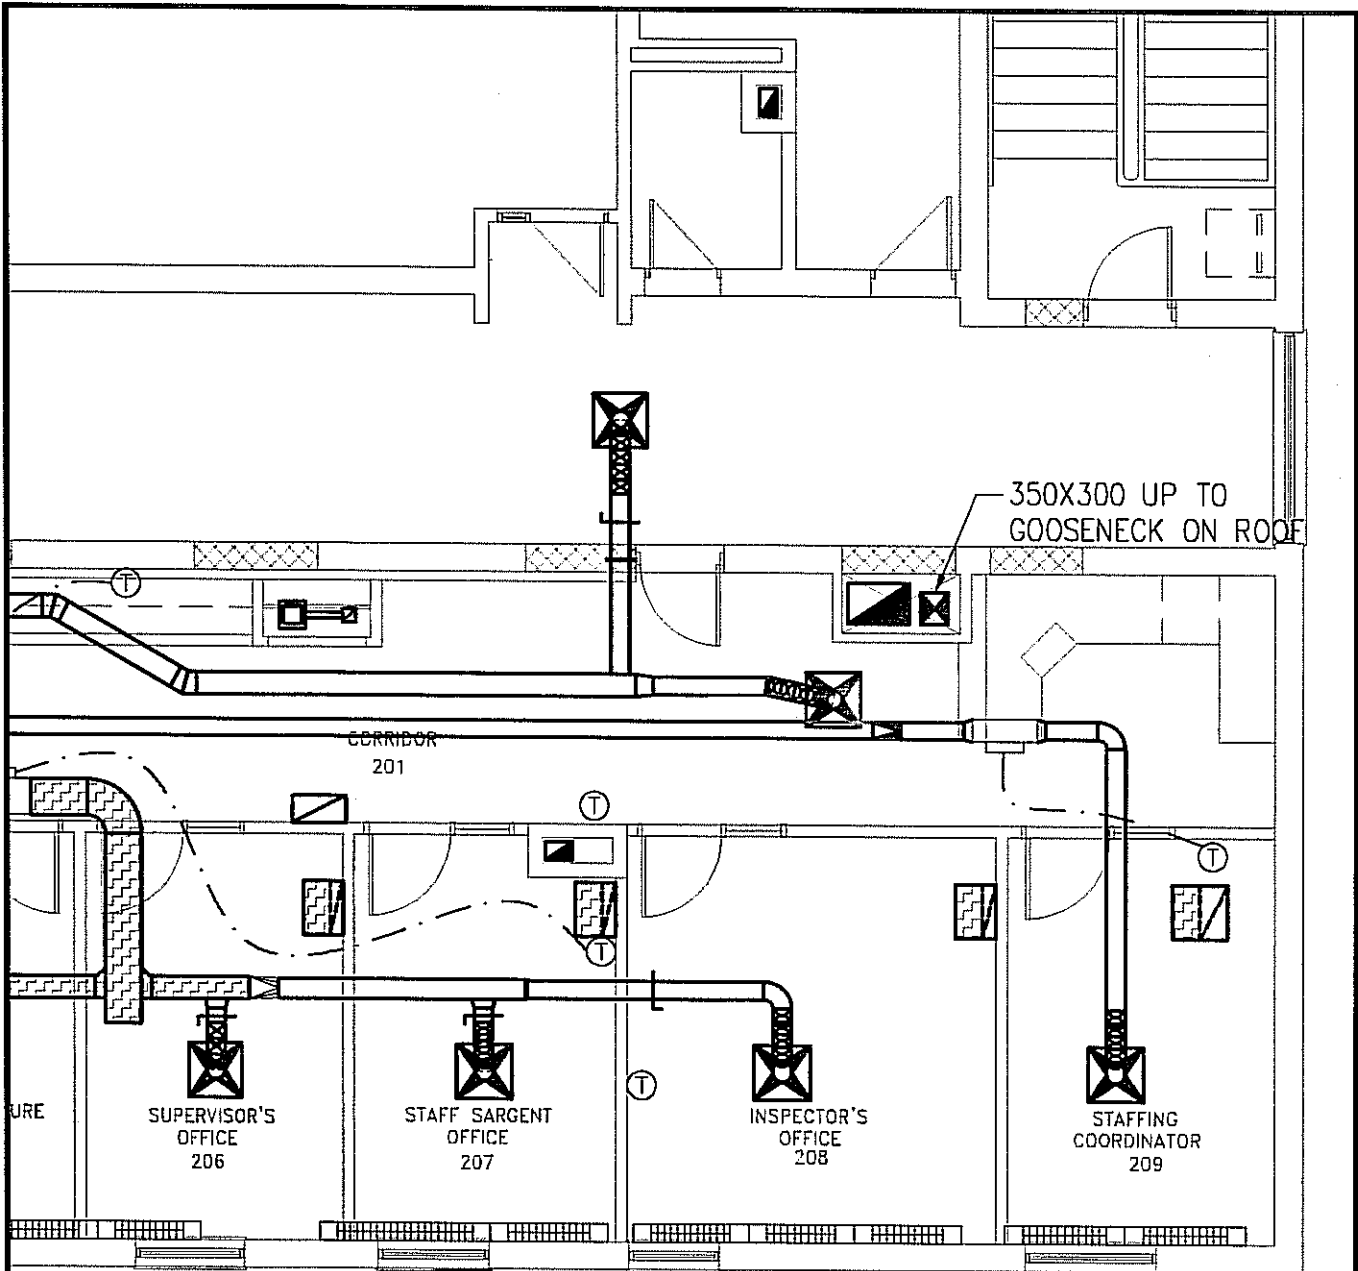

FAN AND DUCT REVISION

SCALE NTS

SMS ENGINEERING

SMS Engineering Ltd. Consulting Engineers
 770 Bradford Street Winnipeg MB Canada R3H 0N3
 Telephone 204.775.0291 Fax 204.772.2153
 sms@smseng.com


CONSTRUCTION OF
 ALTERNATE EMERGENCY
 COMMUNICATION CENTRE
 700 ASSINBOINE PARK DRIVE

WINNEPEG

MANITOBA

FAN AND DUCT CHANGE

| | | |
|-----------------------|--------------------------|-----------------------|
| Drawn By RNS | Approved By MA | Reference 5015M2 |
| File No. 05-015-01 | Setup Date MARCH 2006 | Detail Sheet MDR-2 |

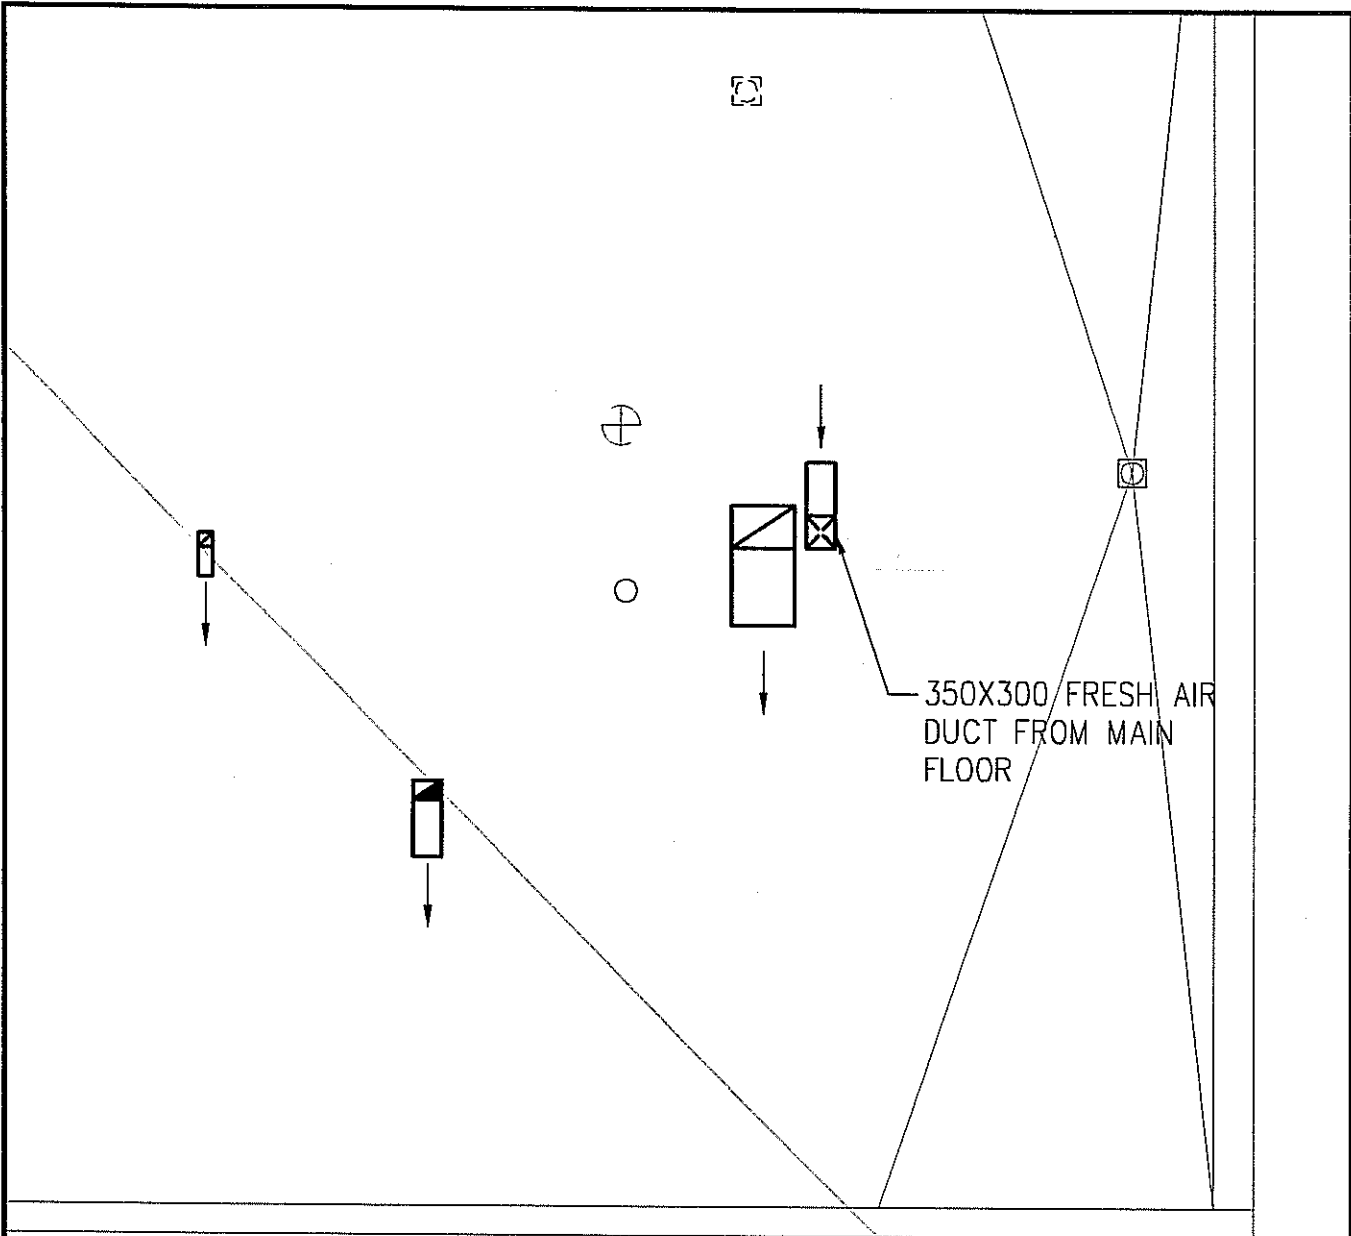

DUCT REVISION
SCALE NTS


SMS ENGINEERING

SMS Engineering Ltd. Consulting Engineers
770 Bradford Street Winnipeg MB Canada R3H 0N3
Telephone 204.775.0291 Fax 204.772.2153
sms@smseng.com

CONSTRUCTION OF
ALTERNATE EMERGENCY
COMMUNICATION CENTRE
700 ASSINIBOINE PARK DRIVE
WINNEPEG MANITOBA

FAN AND DUCT CHANGE

| | | |
|-----------------------|--------------------------|-----------------------|
| Drawn By RNS | Approved By MA | Reference 5015MR |
| File No. 05-015-01 | Setup Date MARCH 2006 | Detail Sheet MDR-3 |

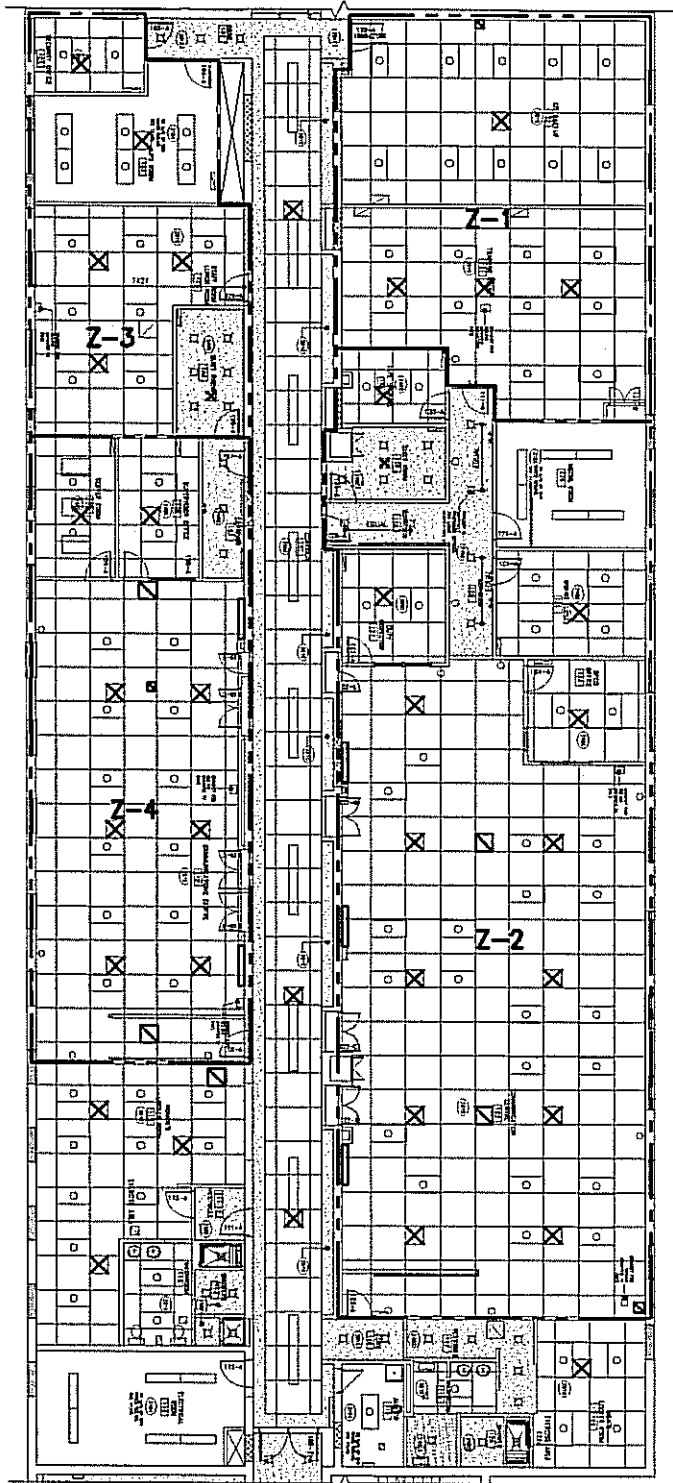

- Z-1: SOUTHWEST
- Z-2: NORTHWEST
- Z-3: SOUTHWEST
- Z-4: NORTHEAST



SMS ENGINEERING
 SMS Engineering Ltd. Consulting Engineers
 770 Bradford Street Winnipeg MB Canada R3H 0N3
 Telephone 204.775.0291 Fax 204.772.2153
 sms@smseng.com

CONSTRUCTION OF
 ALTERNATE EMERGENCY
 COMMUNICATION CENTRE
 700 ASSINIBOINE PARK DRIVE
 WINNIPEG MANITOBA

SMOKE CONTROL CAPARTMENTS

| | | |
|-----------------------|--------------------------|-----------------------|
| Drawn By RNS | Approved By MA | Reference |
| File No. 05-015-01 | Setup Date MARCH 2006 | Detail Sheet MDR-4 |