



**2** DETAIL  
WC-M0111 1:50

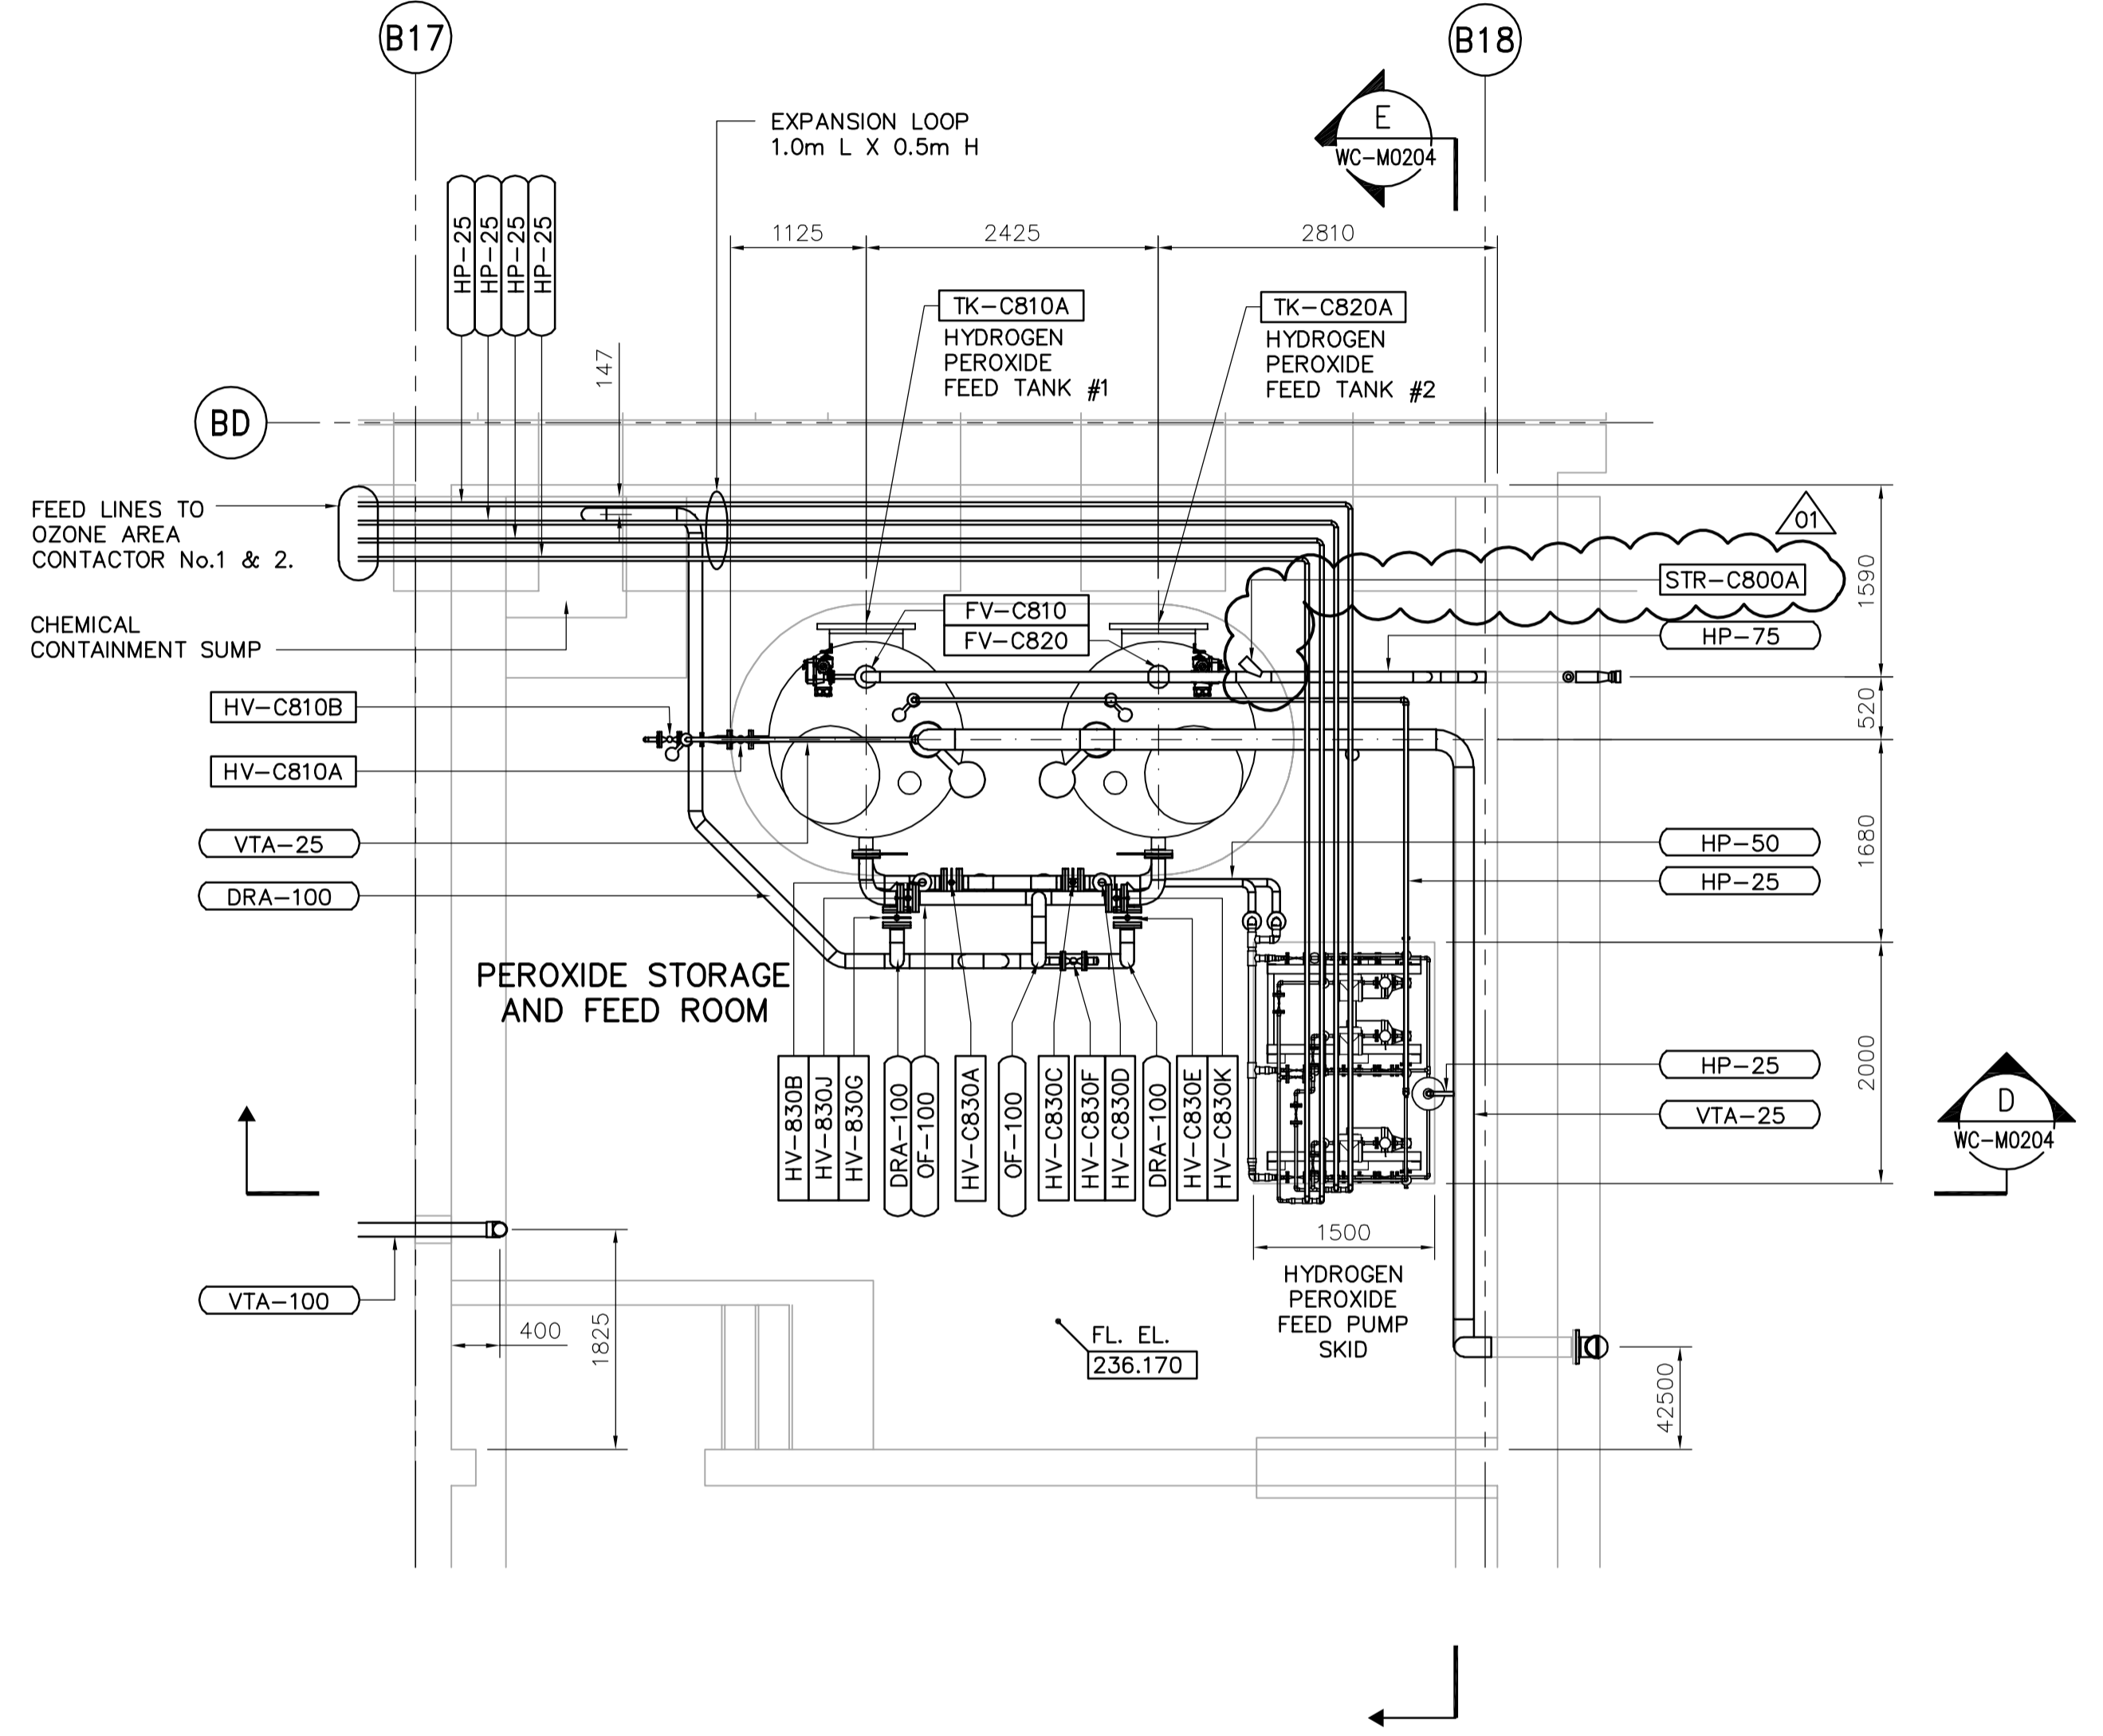

**3** DETAIL  
WC-M0111 1:50

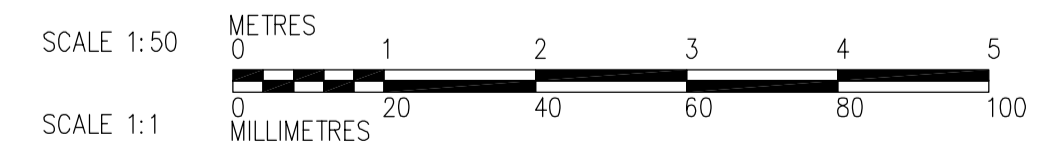

 <b>Certificate of Authorization</b> CH2M HILL Canada Ltd. No. 1441 Expiry: April 30, 2007	B.M. ELEV.	 Frederickson Cooper ARCHITECTS	 A Yeo International Ltd. Company	ENGINEER'S SEAL ORIGINAL SIGNED BY J.W. SINCLAIR 2006/03/29	 <b>THE CITY OF WINNIPEG</b> WATER AND WASTE DEPARTMENT ENGINEERING DIVISION WATER TREATMENT PLANT CHEMICAL FEED SYSTEMS MECHANICAL AND ELECTRICAL PROCESS MECHANICAL SODIUM BISULPHITE AND PEROXIDE STORAGE AND FEED ROOMS - PLAN DETAILS	CITY FILE NUMBER
	DESIGNED BY KS CHECKED BY NN			SHEET OF		
	DRAWN BY YFS APPROVED BY AHL			CITY DRAWING NUMBER		
	SCALE: 1:50 RELEASED FOR CONSTRUCTION BY: R. SOROKOWSKI DATE 2005/07/26 DATE 2006/03/29			CONSULTANT DRAWING NO. WC-M0403		1-0601C-A-M0403-001-010