







**NOTES**

- 1. PROVIDE STAIRWELL SMOKE DETECTORS AS SHOWN ON FIRE PROTECTION DRAWINGS.

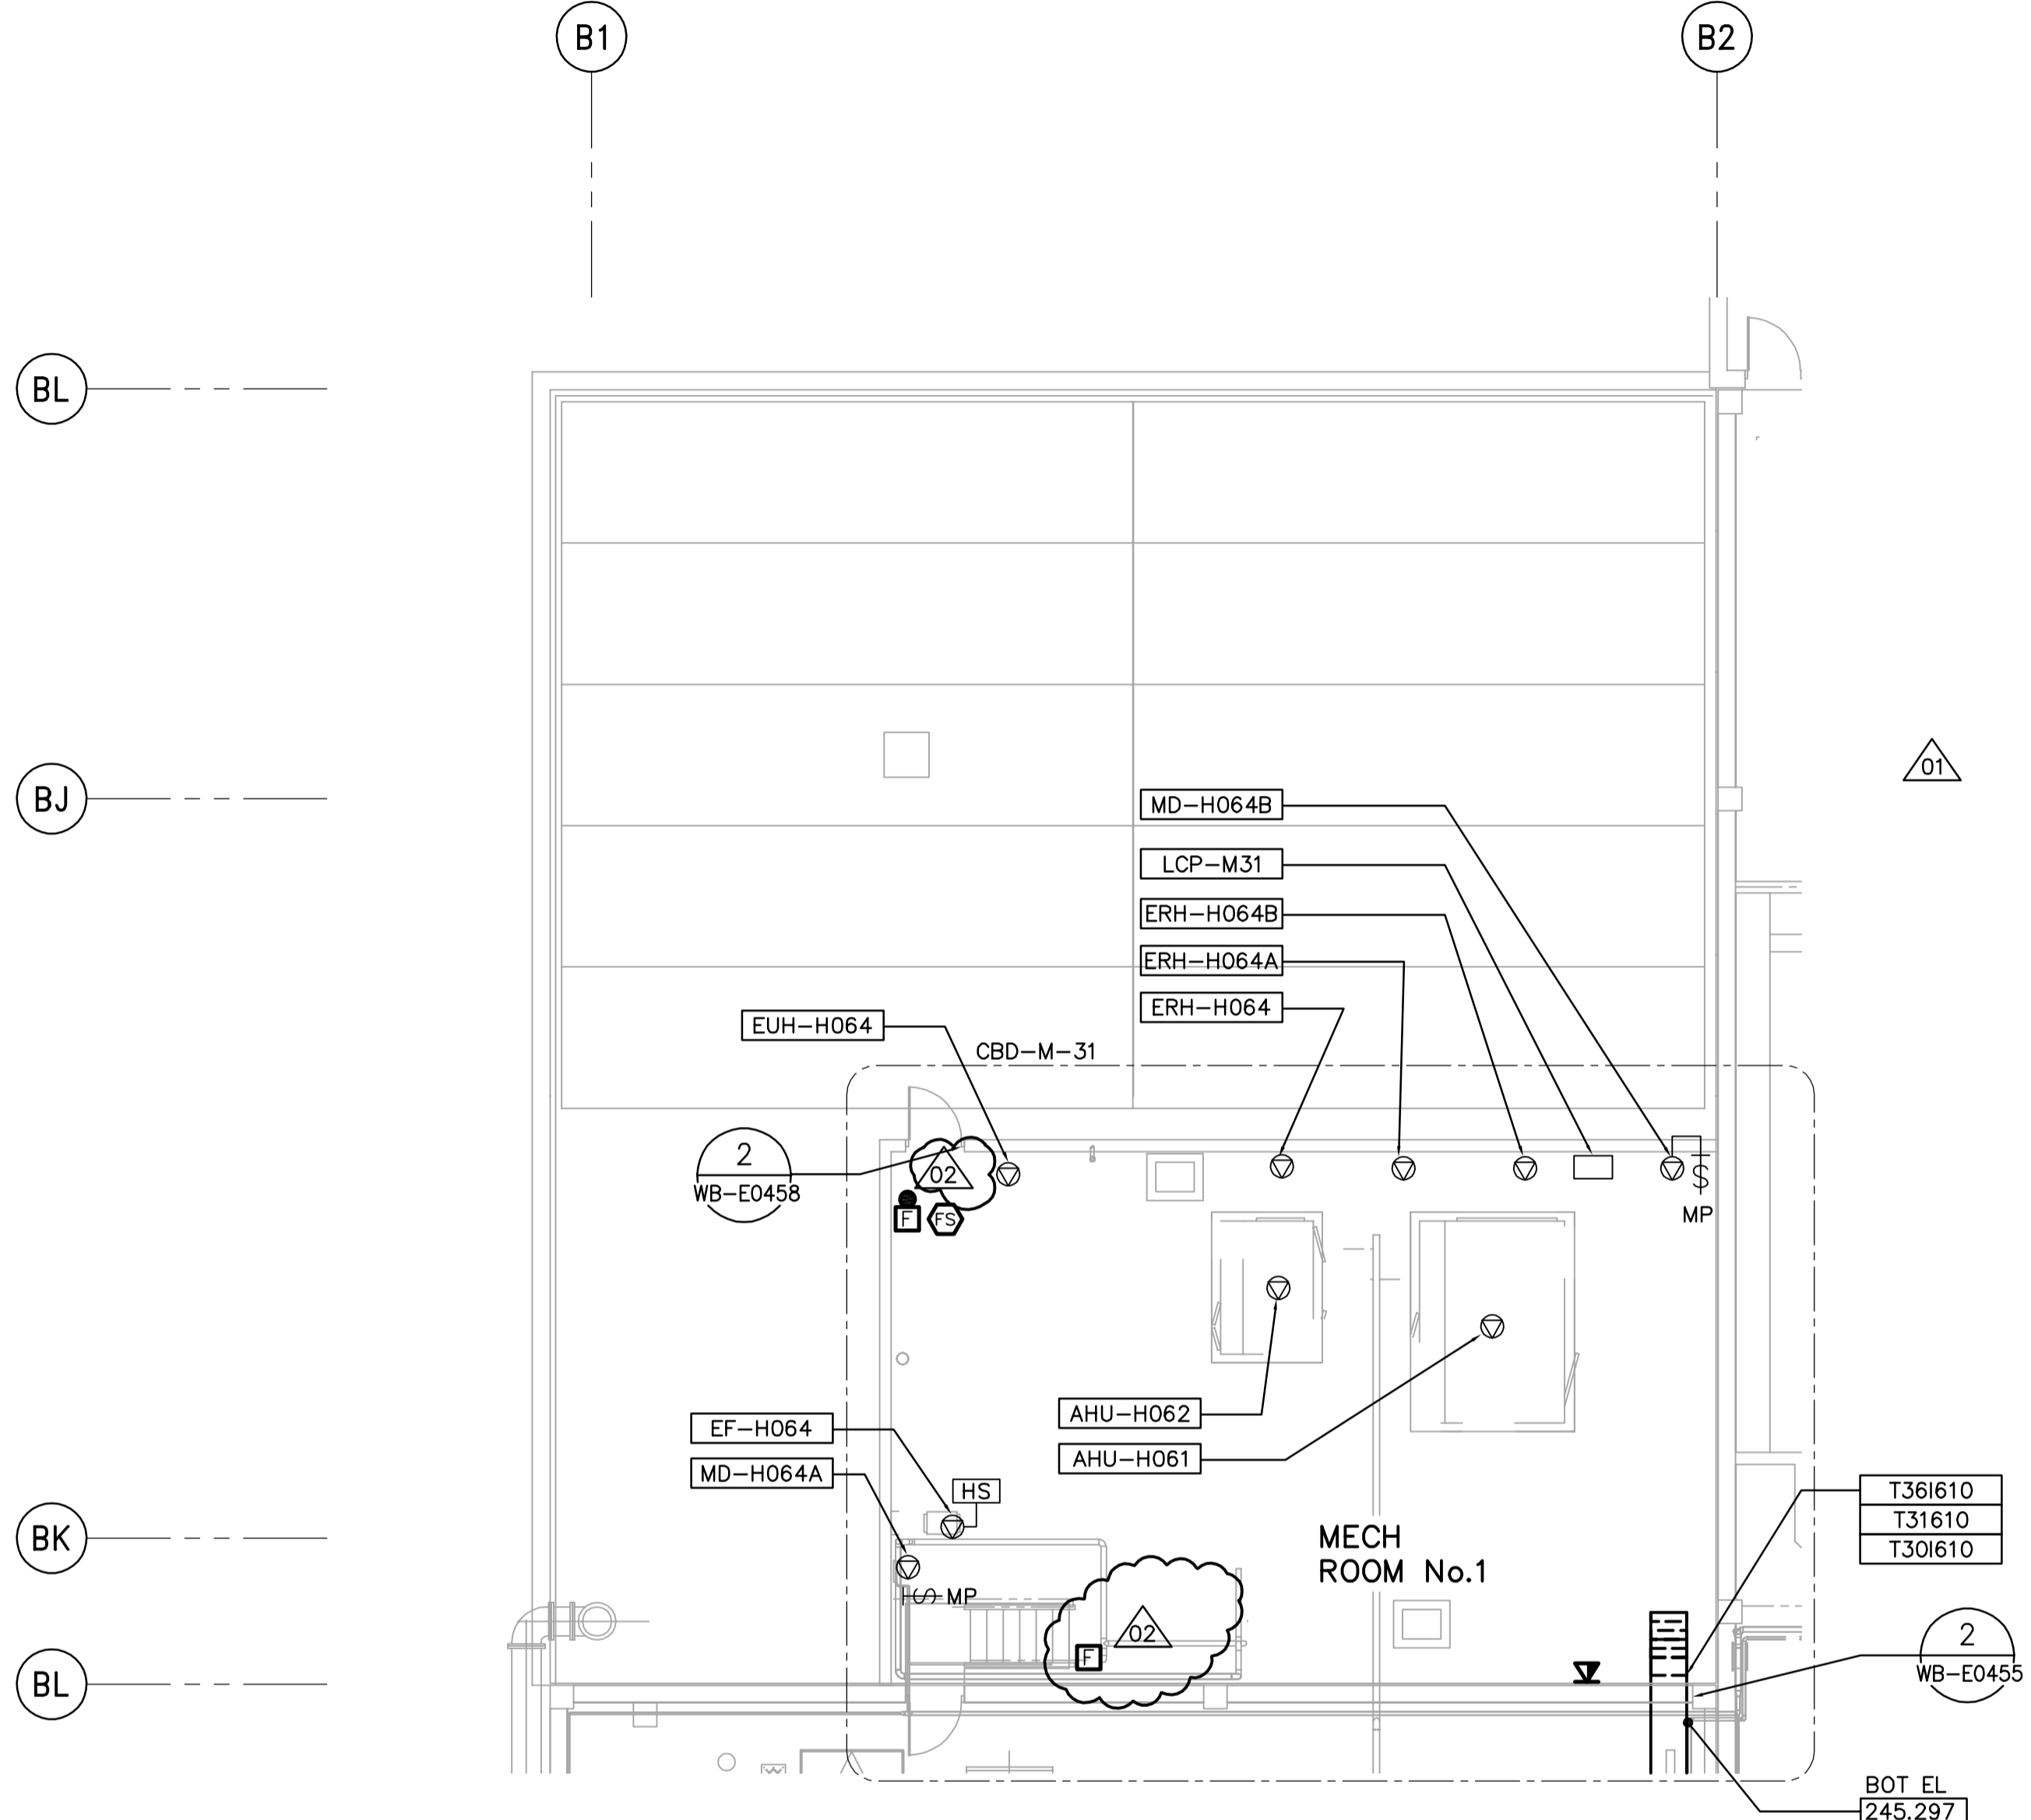

**THIRD FLOOR FACILITY PLAN**  
1:100

CABLE TRAY TAGGING  
SEE DETAIL

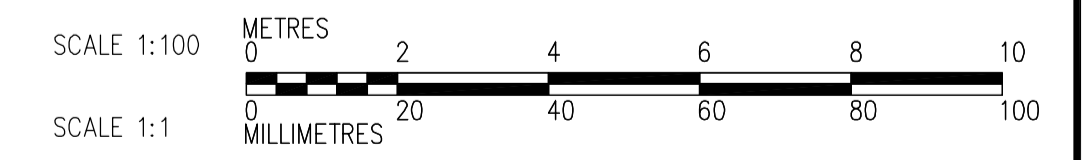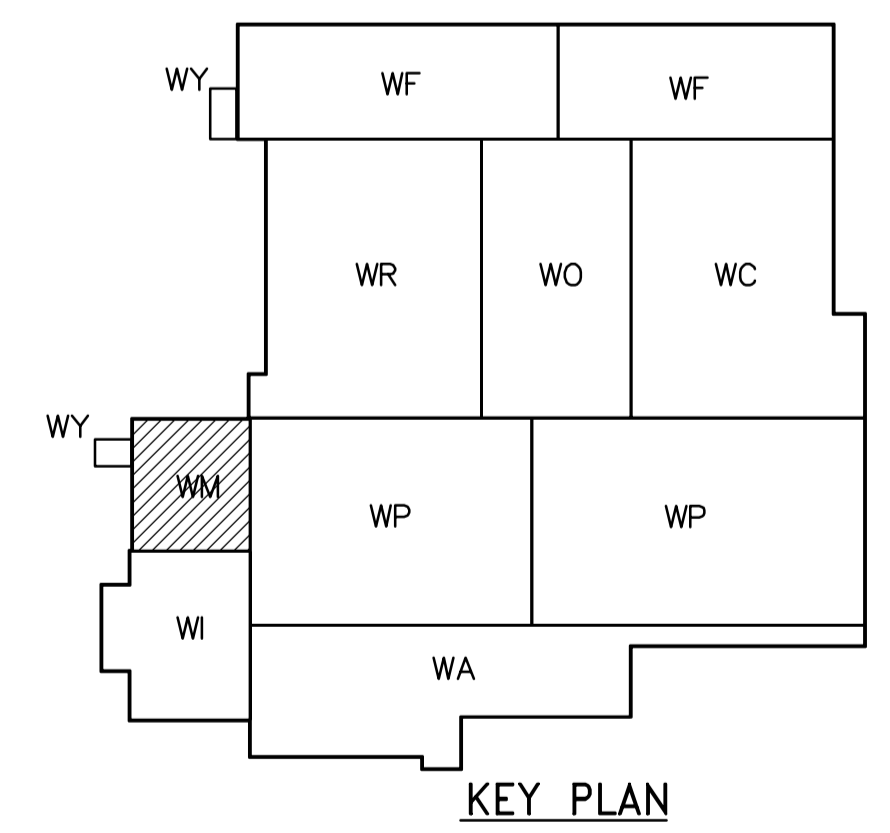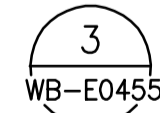

<p><b>APEGN</b> Certificate of Authorization CH2M HILL Canada Ltd. No. 1441 Expiry: April 30, 2007</p>	<table border="1"> <tr> <th>B.M.</th> <th>ELEV.</th> </tr> <tr> <td> </td> <td> </td> </tr> <tr> <td> </td> <td> </td> </tr> <tr> <td> </td> <td> </td> </tr> </table>	B.M.	ELEV.							<p>Frederickson Cooper ARCHITECTS</p>	<p>EarthTech A Tyco International Ltd. Company</p>	ENGINEER'S SEAL	<p><b>THE CITY OF WINNIPEG</b> WATER AND WASTE DEPARTMENT ENGINEERING DIVISION</p>															
		B.M.	ELEV.																									
DESIGNED BY PF	CHECKED BY ND	ORIGINAL SIGNED BY L.D. LLEWELLYN																										
DRAWN BY TL	APPROVED BY AHL	2006/03/29																										
SCALE: 1:100	RELEASED FOR CONSTRUCTION BY: R. SOROKOWSKI	CONSULTANT DRAWING NO. WM-E0131																										
<table border="1"> <thead> <tr> <th>NO.</th> <th>REVISIONS</th> <th>DATE</th> <th>BY</th> </tr> </thead> <tbody> <tr> <td>02</td> <td>742-2005 ADDENDUM 5</td> <td>06/05/19</td> <td>LL</td> </tr> <tr> <td>01</td> <td>742-2005 ADENDUM 3</td> <td>06/05/05</td> <td>LL</td> </tr> <tr> <td>00</td> <td>ISSUED FOR TENDER</td> <td>06/03/29</td> <td>LL</td> </tr> </tbody> </table>		NO.	REVISIONS	DATE	BY	02	742-2005 ADDENDUM 5	06/05/19	LL	01	742-2005 ADENDUM 3	06/05/05	LL	00	ISSUED FOR TENDER	06/03/29	LL	DATE 2006/02/14	DATE 2006/03/29	<table border="1"> <tr> <td>WATER TREATMENT PLANT GENERAL PLANT SERVICES/MISCELLANEOUS MECHANICAL AND ELECTRICAL</td> <td>CITY FILE NUMBER</td> </tr> <tr> <td>ELECTRICAL ELECTRICAL ROOM LAYOUT THIRD FLOOR FACILITY PLAN</td> <td>SHEET OF</td> </tr> <tr> <td></td> <td>CITY DRAWING NUMBER</td> </tr> <tr> <td></td> <td>1-0601M-A-E0131-001-02D</td> </tr> </table>	WATER TREATMENT PLANT GENERAL PLANT SERVICES/MISCELLANEOUS MECHANICAL AND ELECTRICAL	CITY FILE NUMBER	ELECTRICAL ELECTRICAL ROOM LAYOUT THIRD FLOOR FACILITY PLAN	SHEET OF		CITY DRAWING NUMBER		1-0601M-A-E0131-001-02D
NO.	REVISIONS	DATE	BY																									
02	742-2005 ADDENDUM 5	06/05/19	LL																									
01	742-2005 ADENDUM 3	06/05/05	LL																									
00	ISSUED FOR TENDER	06/03/29	LL																									
WATER TREATMENT PLANT GENERAL PLANT SERVICES/MISCELLANEOUS MECHANICAL AND ELECTRICAL	CITY FILE NUMBER																											
ELECTRICAL ELECTRICAL ROOM LAYOUT THIRD FLOOR FACILITY PLAN	SHEET OF																											
	CITY DRAWING NUMBER																											
	1-0601M-A-E0131-001-02D																											