




SECTION - INFLUENT GALLERY SUMP PUMPS
WP-M0214 1:50

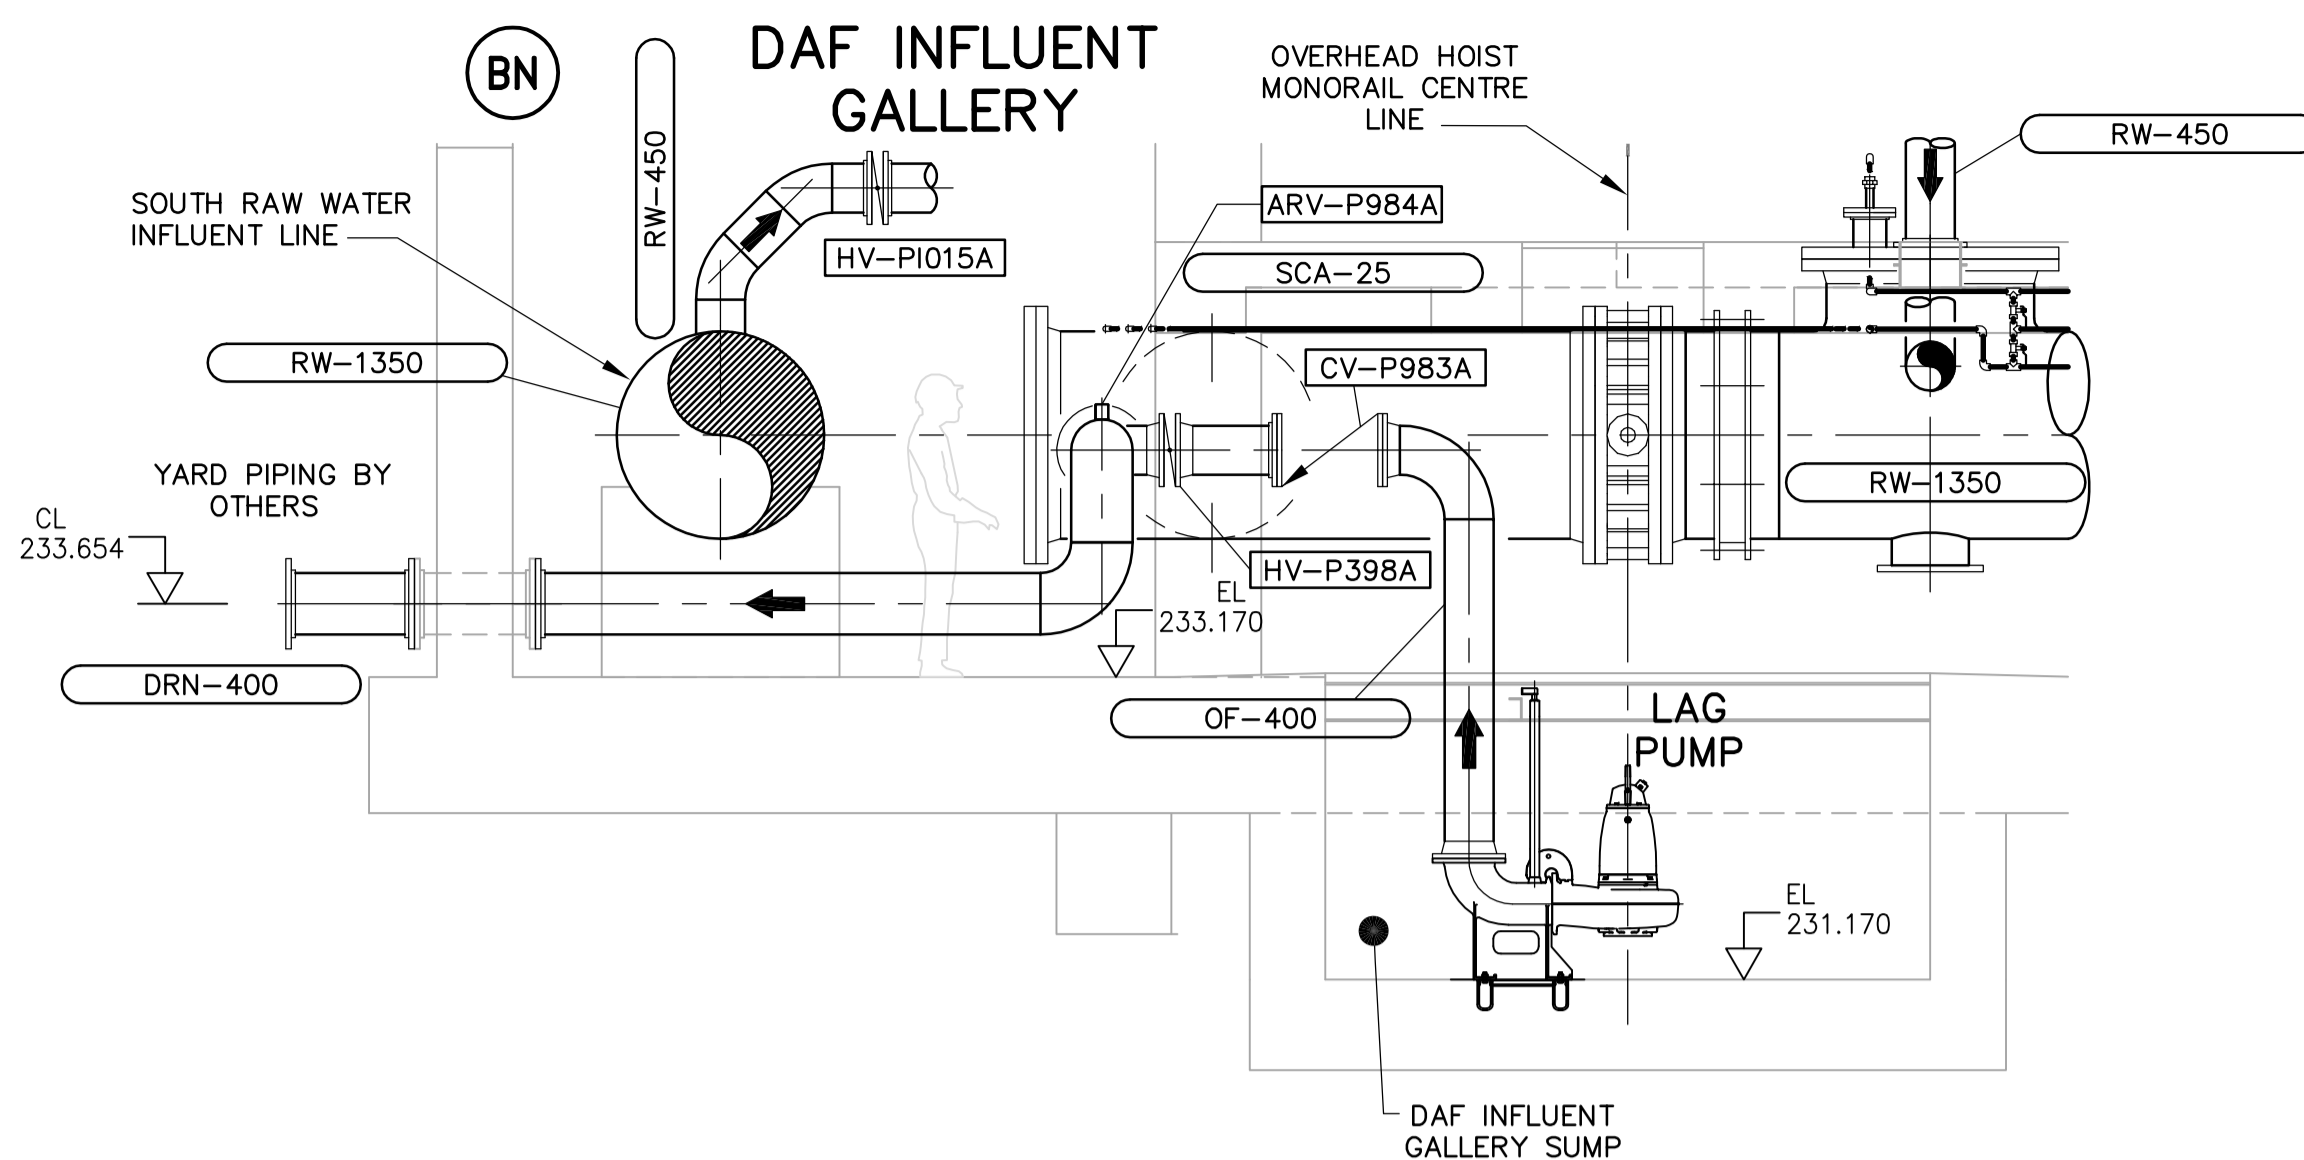



SECTION - INFLUENT GALLERY SUMP PUMPS
WP-M0214 1:50

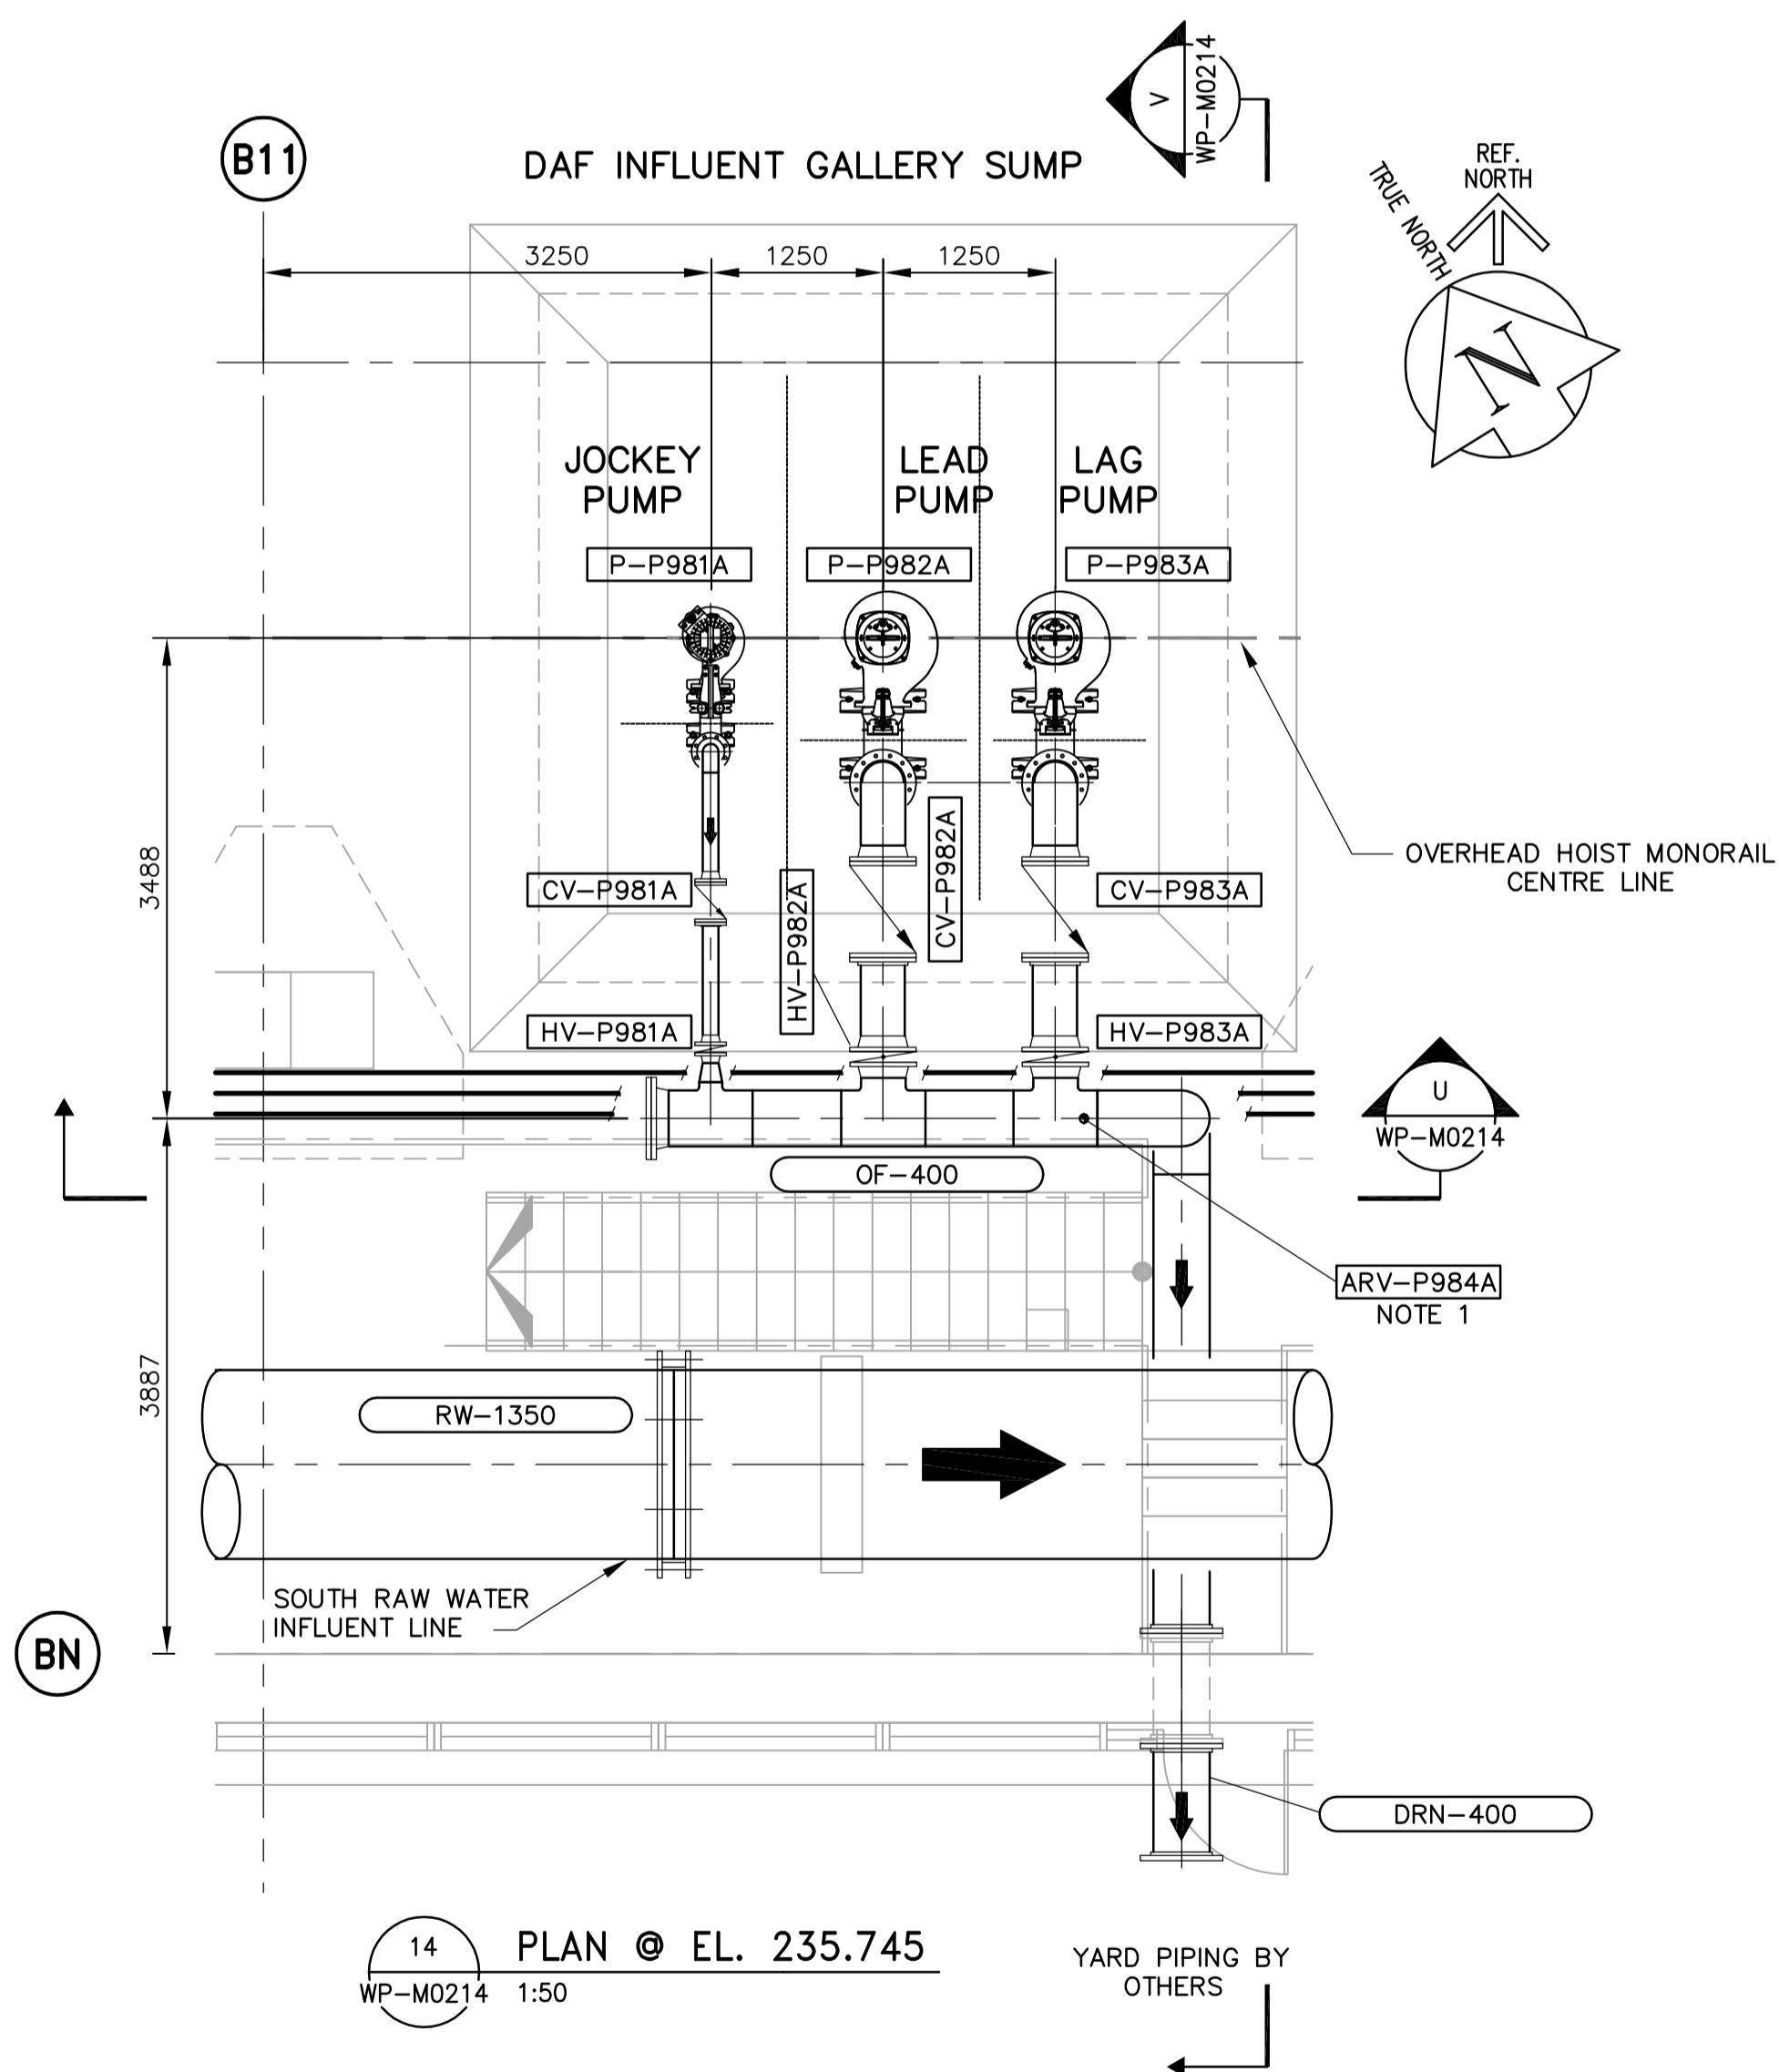

PLAN @ EL. 235.745
WP-M0214 1:50

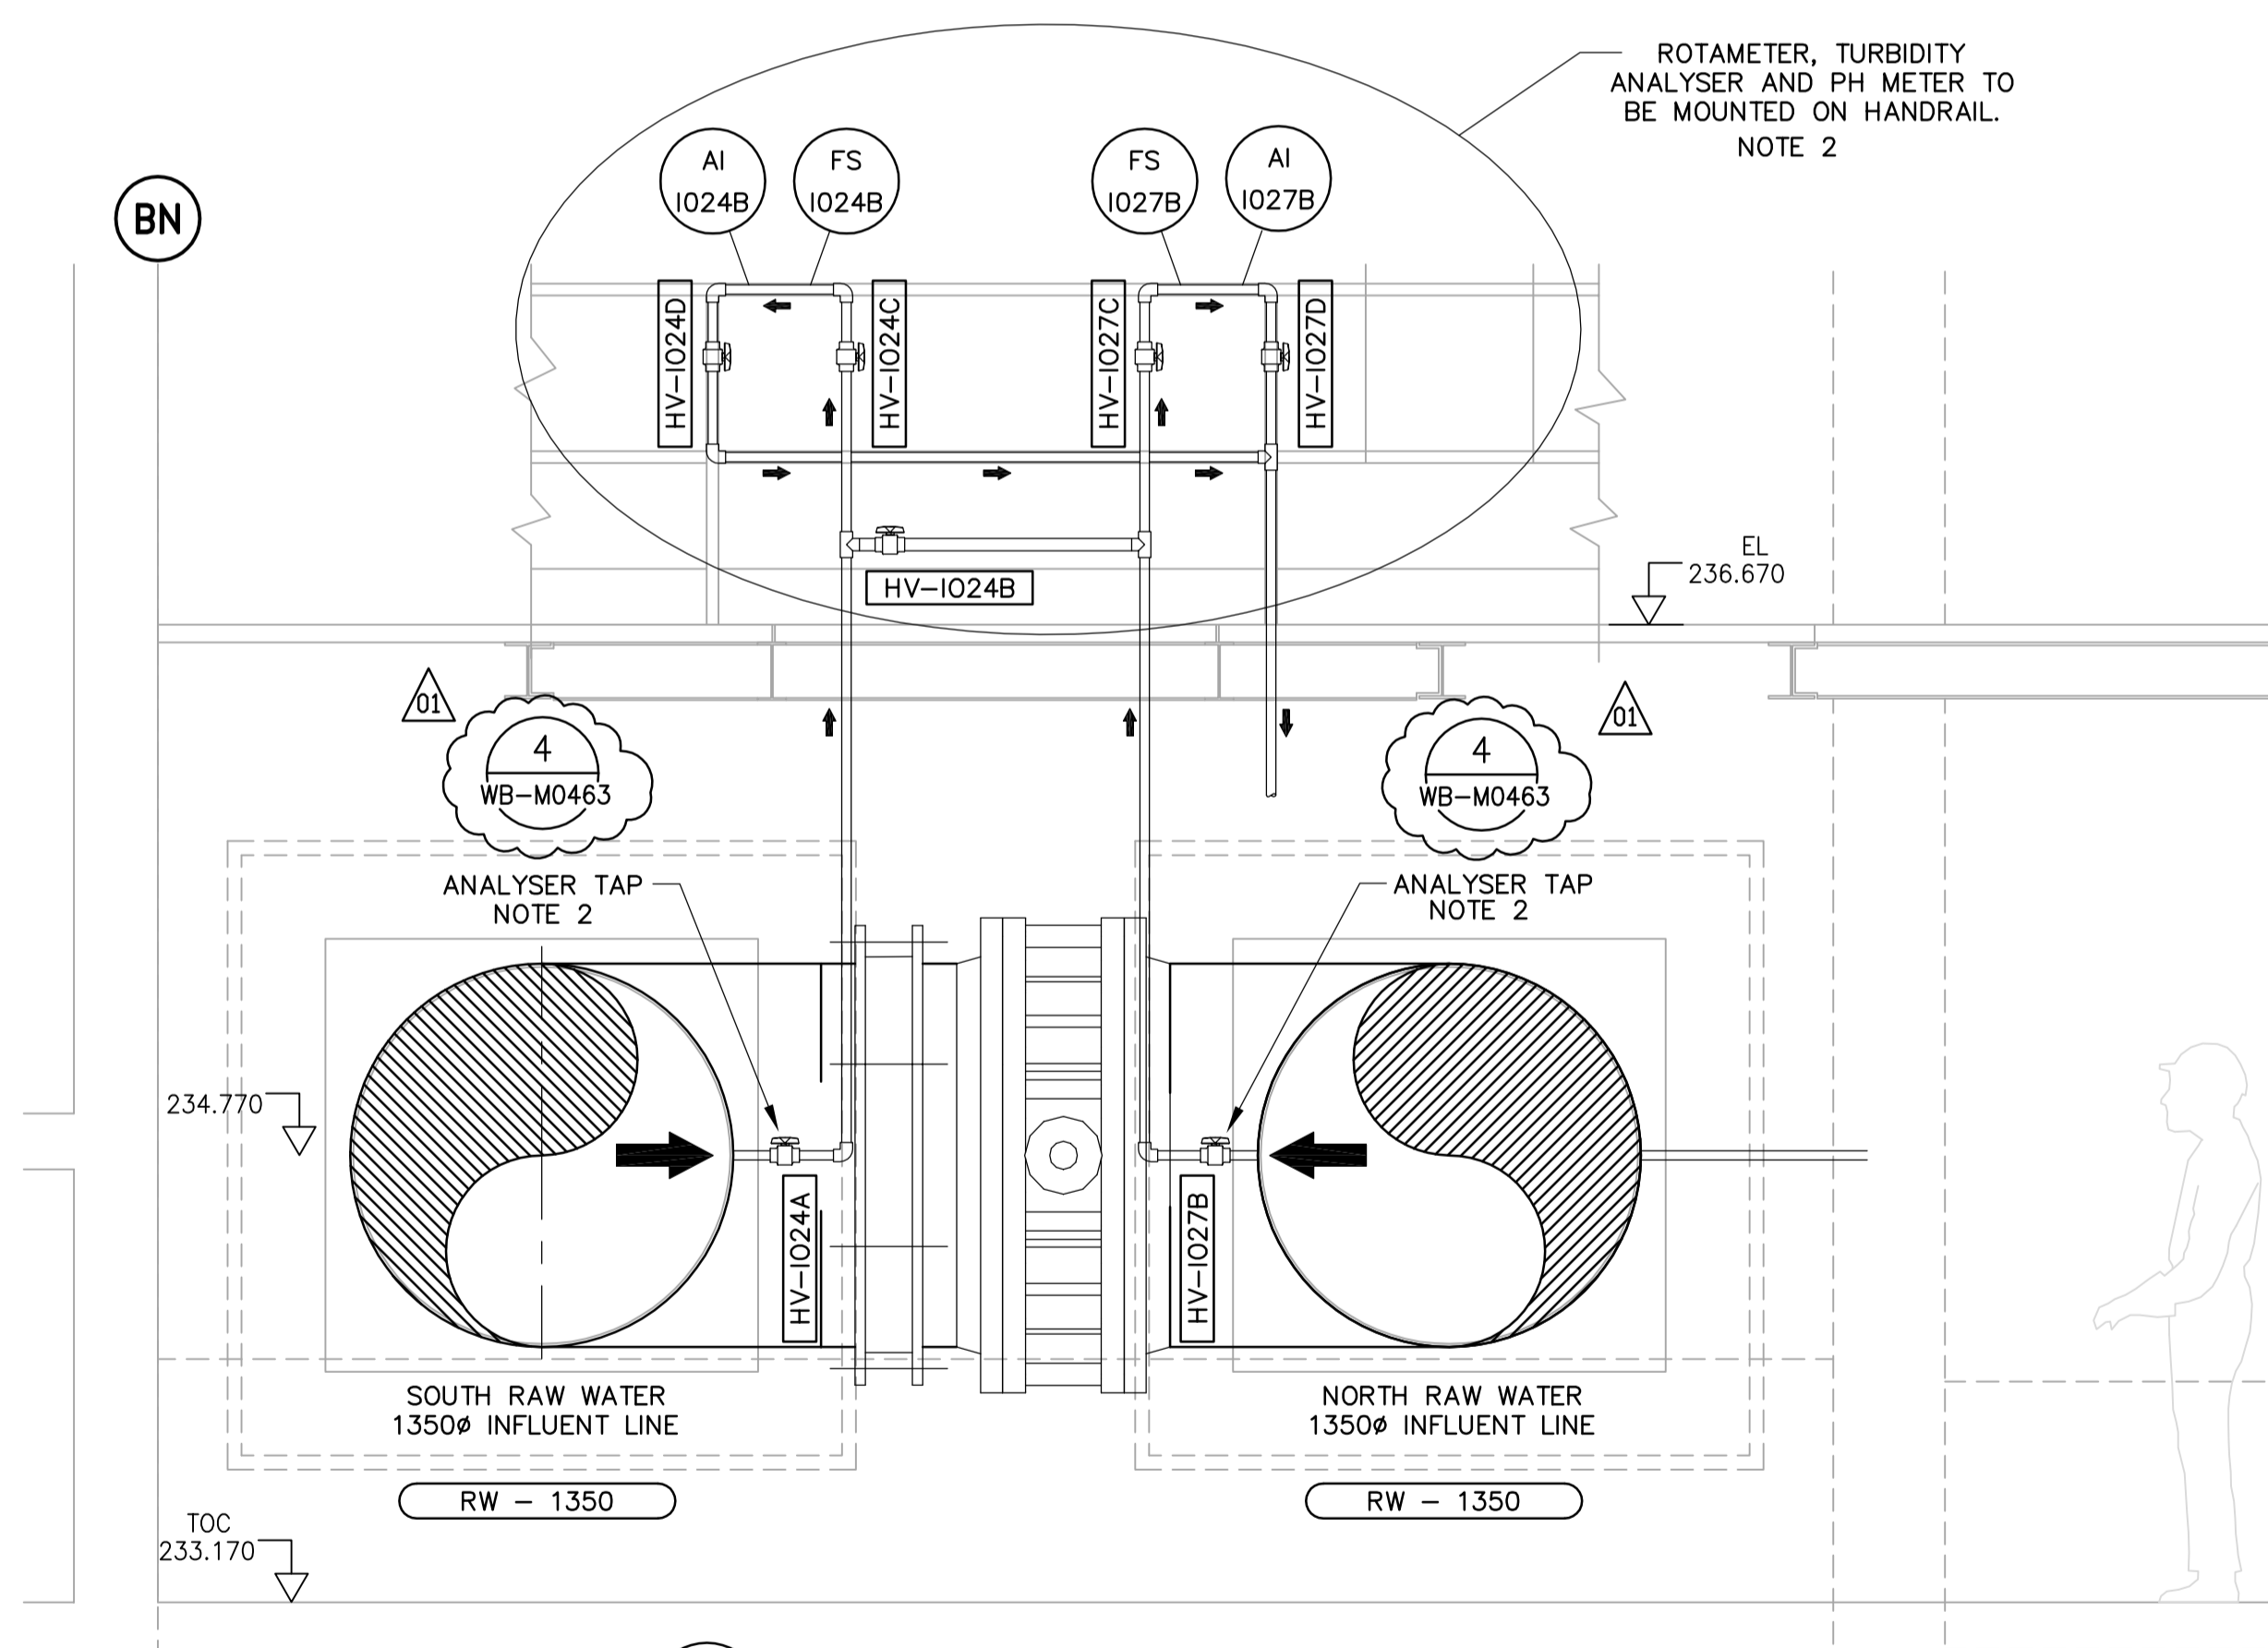

SECTION - ANALYSER TAPS AND STATIONS
WP-M0110 1:25

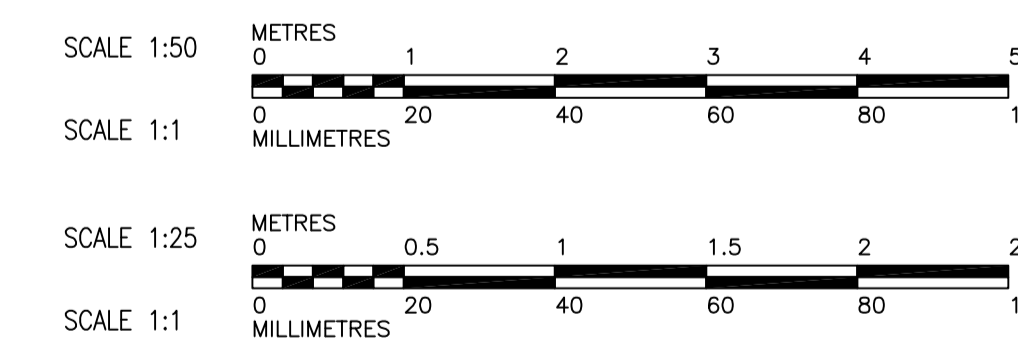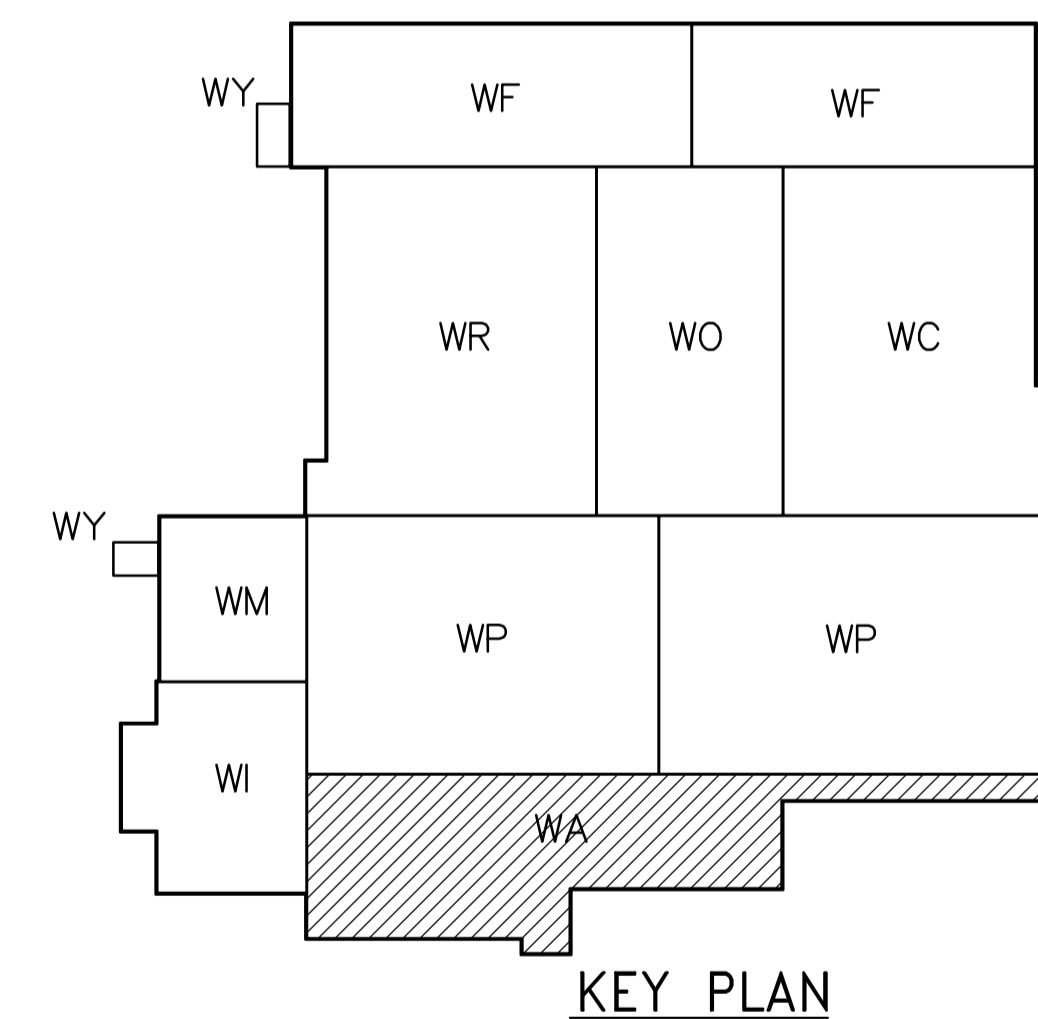

NOTES:
1. RUN AIR RELEASE VALVE DRAIN BACK TO PROCESS SUMP.
2. RUN ANALYSER SAMPLE LINES UP TO PLATFORM @ 236.67m LEVEL. INSTALL ROTAMETER, PH METER AND TURBIDITY METER ALONG HANDRAILS OF PLATFORM. REFER TO INSTRUMENTATION DRAWINGS FOR STANDARD DETAILS. COMBINE DRAIN LINES FROM ANALYSERS AND AIR RELIEF VALVES AND RUN UNDER THE PLATFORM TO THE HUB DRAIN AT FLOOR ELEVATION 233.170m.
3. FOR ADDITIONAL INFORMATION ON PIPE EMBEDS, REFER TO SERIES WP-M9000 DRAWINGS.

APEGM
Certificate of Authorization
Earth Tech Canada Inc.
No. 730 Expiry: April 30, 2006

B.M. ELEV.			
01	742-2005 ADDENDUM 6	06/05/26	SRP
00	ISSUED FOR TENDER	06/03/29	PL
NO. REVISIONS	DATE	BY	

CH2M HILL Frederickson Cooper ARCHITECTS	DESIGNED BY: KAS	CHECKED BY: SMB
	DRAWN BY: PL/LPT/LC	APPROVED BY: AHL
	SCALE: 1:50	RELEASED FOR CONSTRUCTION BY: R. SOROKOWSKI
	DATE: 2005/12/09	DATE: 2006/03/29

ENGINEER'S SEAL	ORIGINAL SIGNED BY: S.M. BREESE	DATE: 2006/03/29
	CONSULTANT DRAWING NO. WP-M0214	

THE CITY OF WINNIPEG WATER AND WASTE DEPARTMENT ENGINEERING DIVISION	CITY FILE NUMBER
WATER TREATMENT PLANT FLOCCULATION AND DAF MECHANICAL AND ELECTRICAL	SHEET OF
PROCESS MECHANICAL DAF INFLUENT GALLERY PLANS AND SECTIONS	CITY DRAWING NUMBER 1-0601P-A-M0214-001-010