


FOUNDATION SLAB ELEVATIONS PLAN  
1:200

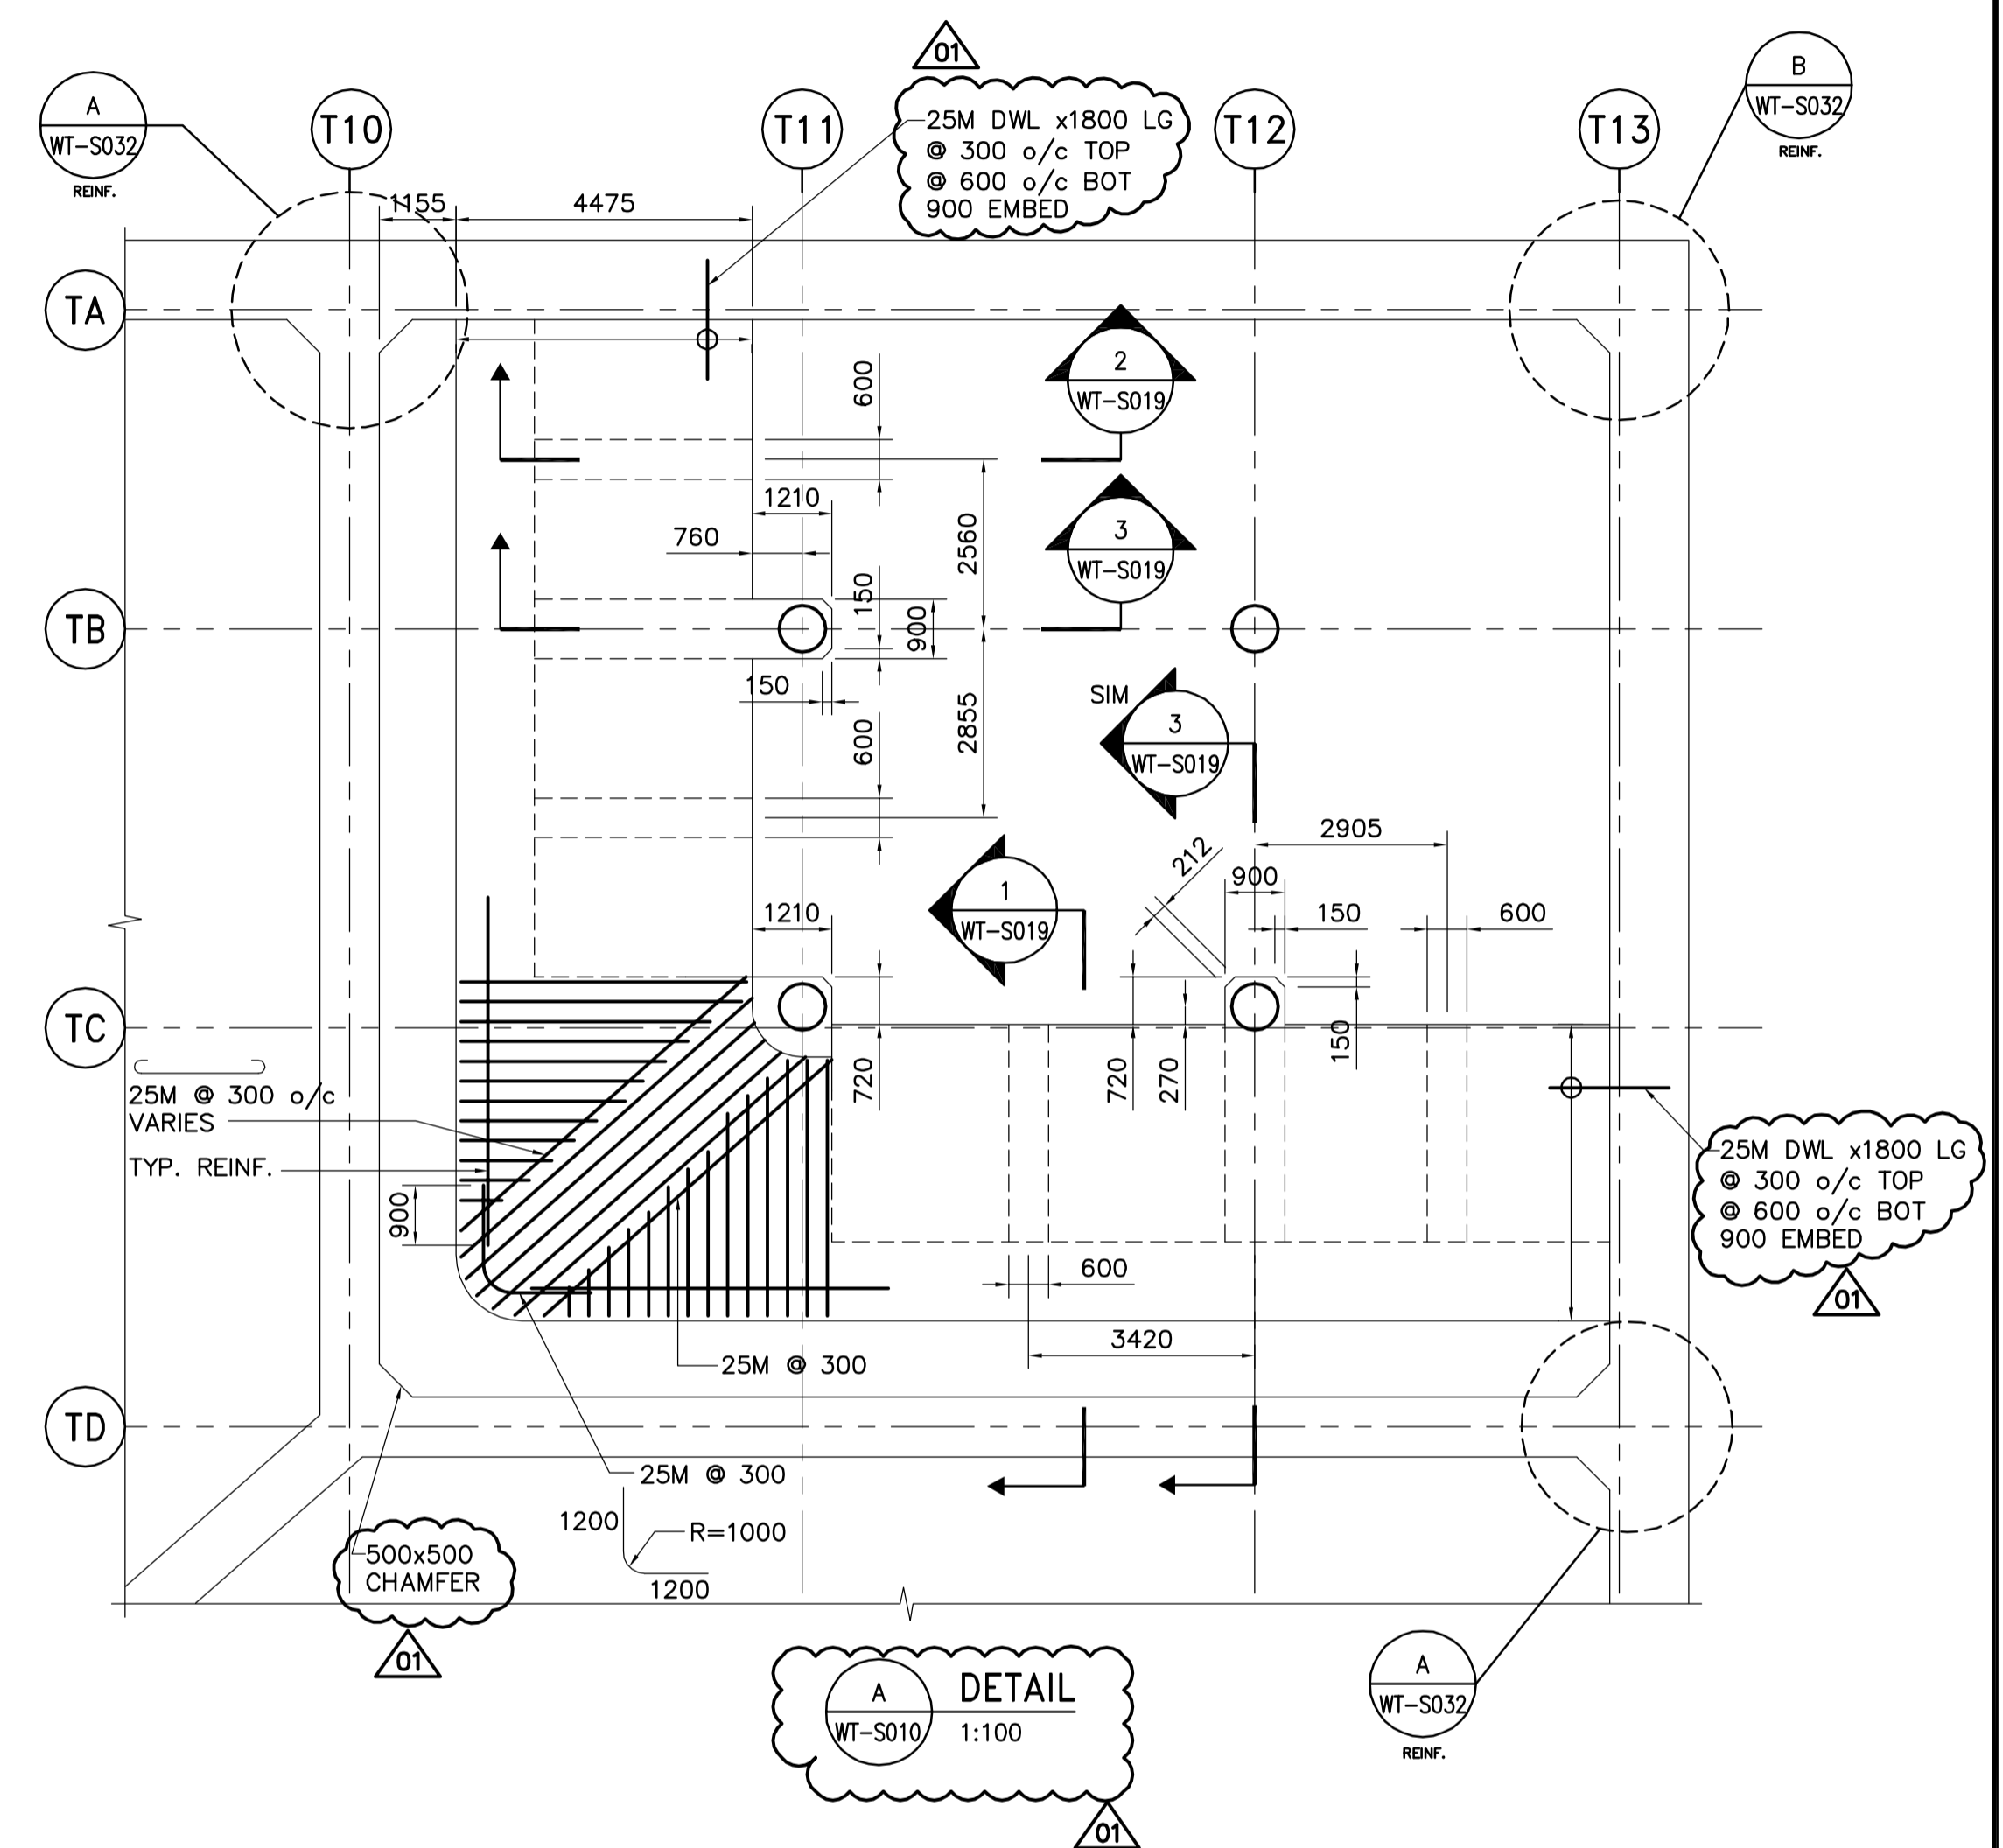

DRAWING NOTES:  
1. REFER TO DRAWING WT-S020 FOR EXPANSION JOINTS AND CONSTRUCTION JOINTS.

<p>Certificate of Authorization Earth Tech Canada Inc. No. 730 Expiry: April 30, 2006</p>	
---	--

NO.	REVISIONS	DATE	BY
04	OUTLET FLOOR LOWERED 100	05/09/13	C.T.
03	GENERAL REVISIONS	05/07/25	C.T.
02	ISSUED FOR CONSTRUCTION	05/06/08	C.T.
01	166-2005 ADDENDUM 1	05/05/06	C.T.
00	ISSUED FOR TENDER	05/04/17	C.T.

<p>Frederickson Cooper ARCHITECTS</p>	<p>A Tech International Ltd. Company</p>
DESIGNED BY: FK	CHECKED BY: MK
DRAWN BY: C.T. / WDB	APPROVED BY: AHL
SCALE: AS NOTED	RELEASED FOR CONSTRUCTION BY: R. SOROKOWSKI
DATE: 2005/02/24	DATE: 2005-04-17

ENGINEER'S SEAL
ORIGINAL SIGNED BY: F.A. KEMP
2005/04/17
CONSULTANT DRAWING NO. WT-S010

<p>THE CITY OF WINNIPEG WATER AND WASTE DEPARTMENT ENGINEERING DIVISION</p>	
WATER TREATMENT PLANT	CITY FILE NUMBER
STRUCTURAL FOUNDATION SLAB ELEVATIONS PLAN	SHEET OF
	CITY DRAWING NUMBER
	1-060TT-B-S0010-001-04D