



PLAN VIEW AT ELEVATION 239.410  
1:25

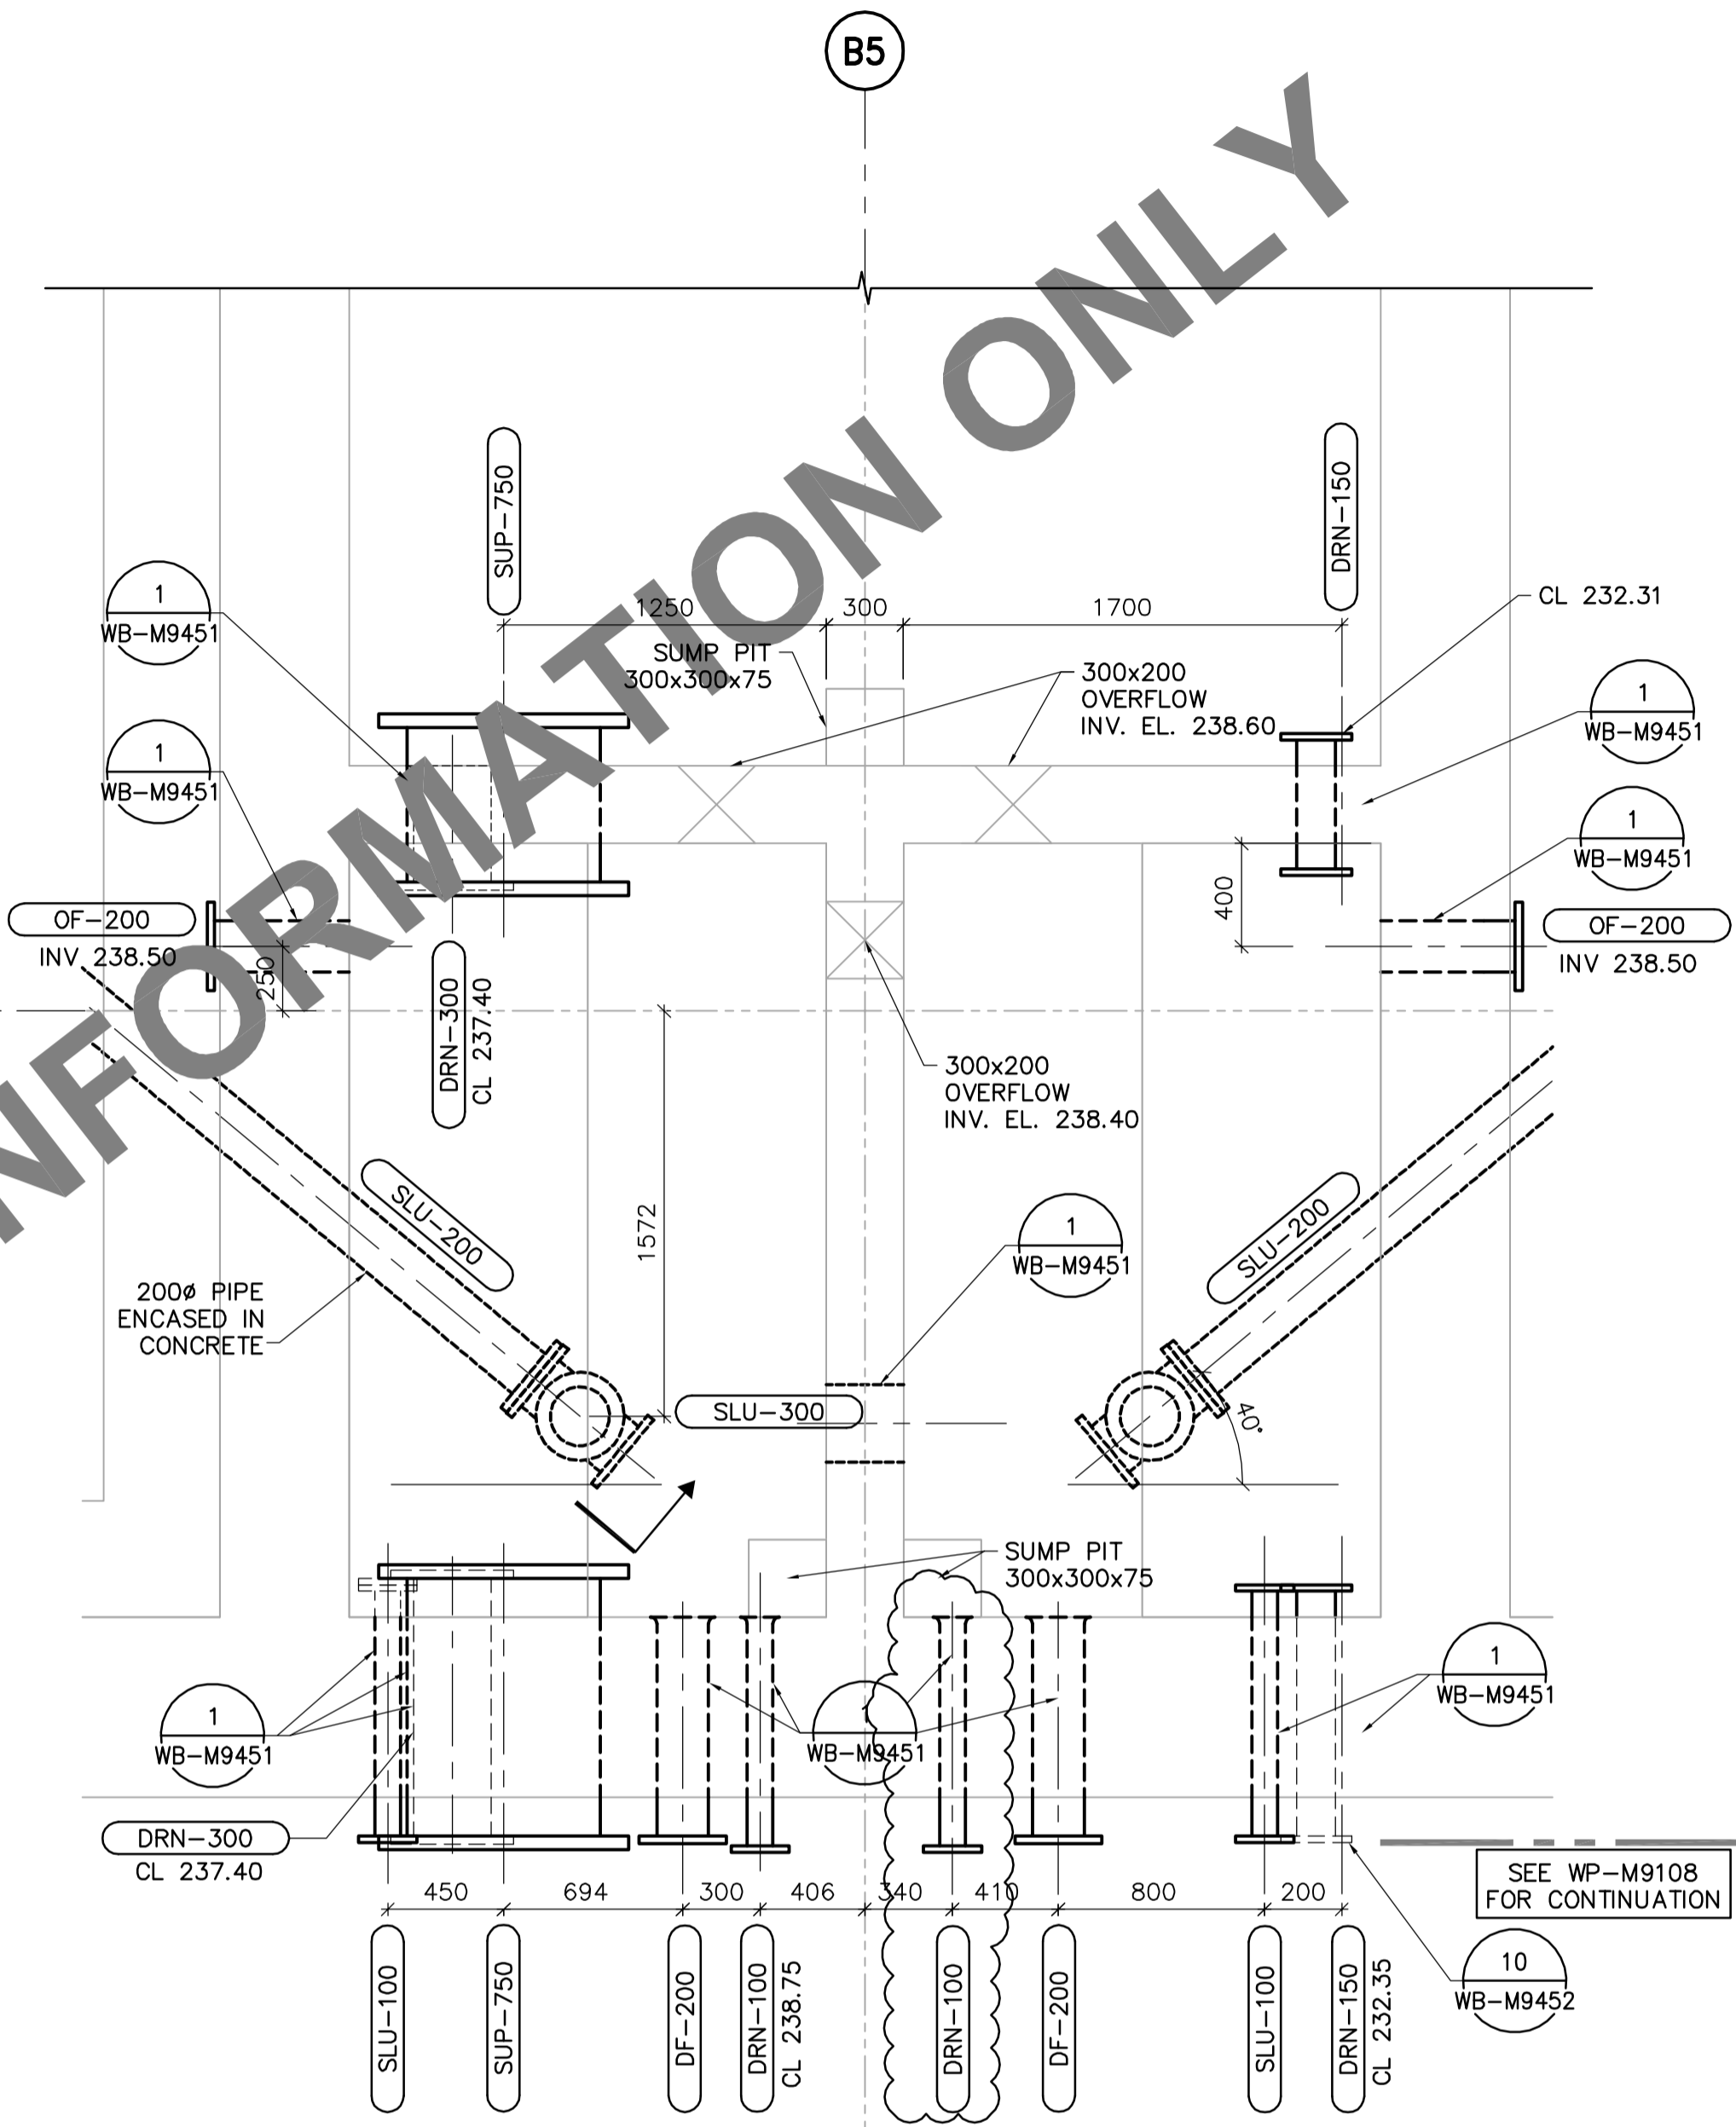

PLAN VIEW AT ELEVATION 239.000  
1:25

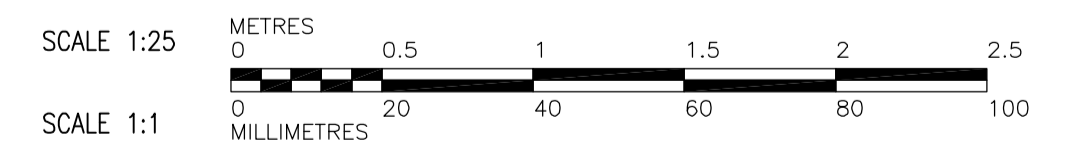

<p>Certificate of Authorization Earth Tech Canada Inc. No. 730 Expiry: April 30, 2006</p>	B.M. ELEV.	<p>Frederickson Cooper ARCHITECTS</p>	<p>A Tech International Ltd. Company</p>	ENGINEER'S SEAL	<p>THE CITY OF WINNIPEG WATER AND WASTE DEPARTMENT ENGINEERING DIVISION</p>		
				DESIGNED BY SM		CHECKED BY SRB	ORIGINAL SIGNED BY S.R. BILEVICIUS
				DRAWN BY JBC		APPROVED BY DJT	2006/02/07
				SCALE: 1:25		RELEASED FOR CONSTRUCTION BY: R. SOROKOWSKI	CONSULTANT DRAWING NO. WR-M9123
	01 583-2005 ADDENDUM 3 06/03/10 GLG				CITY FILE NUMBER		
	00 ISSUED FOR TENDER 06/02/03 JBC				SHEET OF		
	NO. REVISIONS	DATE	DATE 2005/09/29	DATE 2006/02/07	CITY DRAWING NUMBER		
					1-0601R-A-M9123-001-01D		