SHEET: COW-A1 (03/2005)

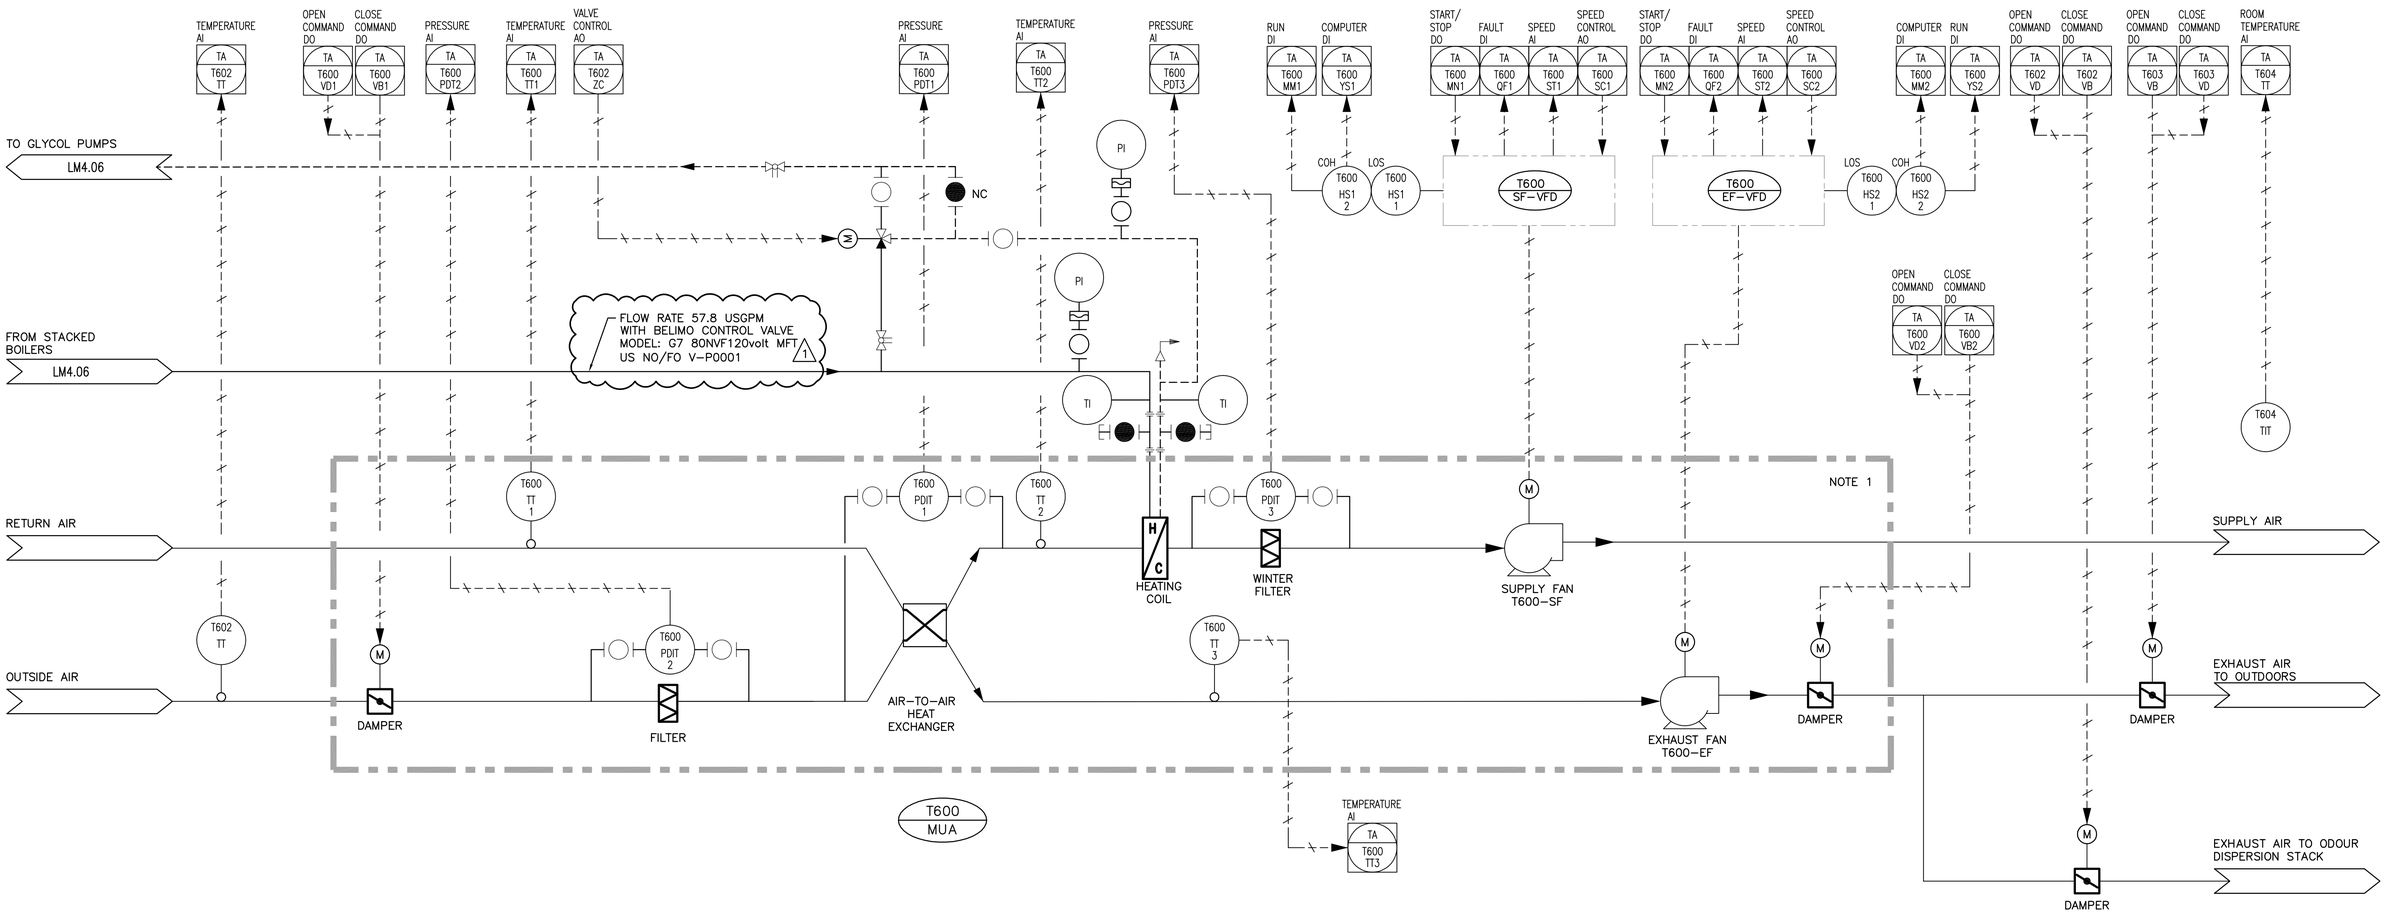

1 / LM4.04 VENTILATION SCHEMATIC – MAKE-UP AIR UNIT T600-MUA

SCALE N.T.S.

GENERAL NOTES

1. COMPONENTS WITHIN UNIT OUTLINE ARE SUPPLIED WITH MAKE-UP AIR UNIT.
2. REFER TO SPEC. SECTION 15900 FOR ADDITIONAL CONTROL REQUIREMENTS.

APEGM
Certificate of Authorization
Earth Tech Canada Inc.
No. 730 Expiry: April 30, 2006

NO.	REVISIONS	DATE	BY
01	21-2006 ADDENDUM 3	06/05/19	LJW
00	ISSUED FOR TENDER	06/04/26	LJW

B.M. ELEV.

EarthTech
A Tyco International Ltd. Company

DESIGNED BY AB | CHECKED BY PVL
DRAWN BY DL | APPROVED BY JEH
HOR. SCALE: AS NOTED | RELEASED FOR CONSTRUCTION BY: J. VEILLEUX
VERTICAL SCALE:
DATE 2006/01/02 | DATE 2006/04/26

ENGINEER'S SEAL
ORIGINAL SIGNED BY
A. BURACHYNSKY
2006/04/26

CONSULTANT DRAWING NO.
LM4.04

Winnipeg
THE CITY OF WINNIPEG
WATER AND WASTE DEPARTMENT
ENGINEERING DIVISION

WEWPCC
BIOLOGICAL NUTRIENT REMOVAL UPGRADE
CONTRACT 3

CITY FILE NUMBER
SHEET OF

MECHANICAL
AREA L – GENERAL AND SITEWORKS
HEATING AND VENTILATION SCHEMATICS

CITY DRAWING NUMBER