SHEET: COW-A1 (03/2005)

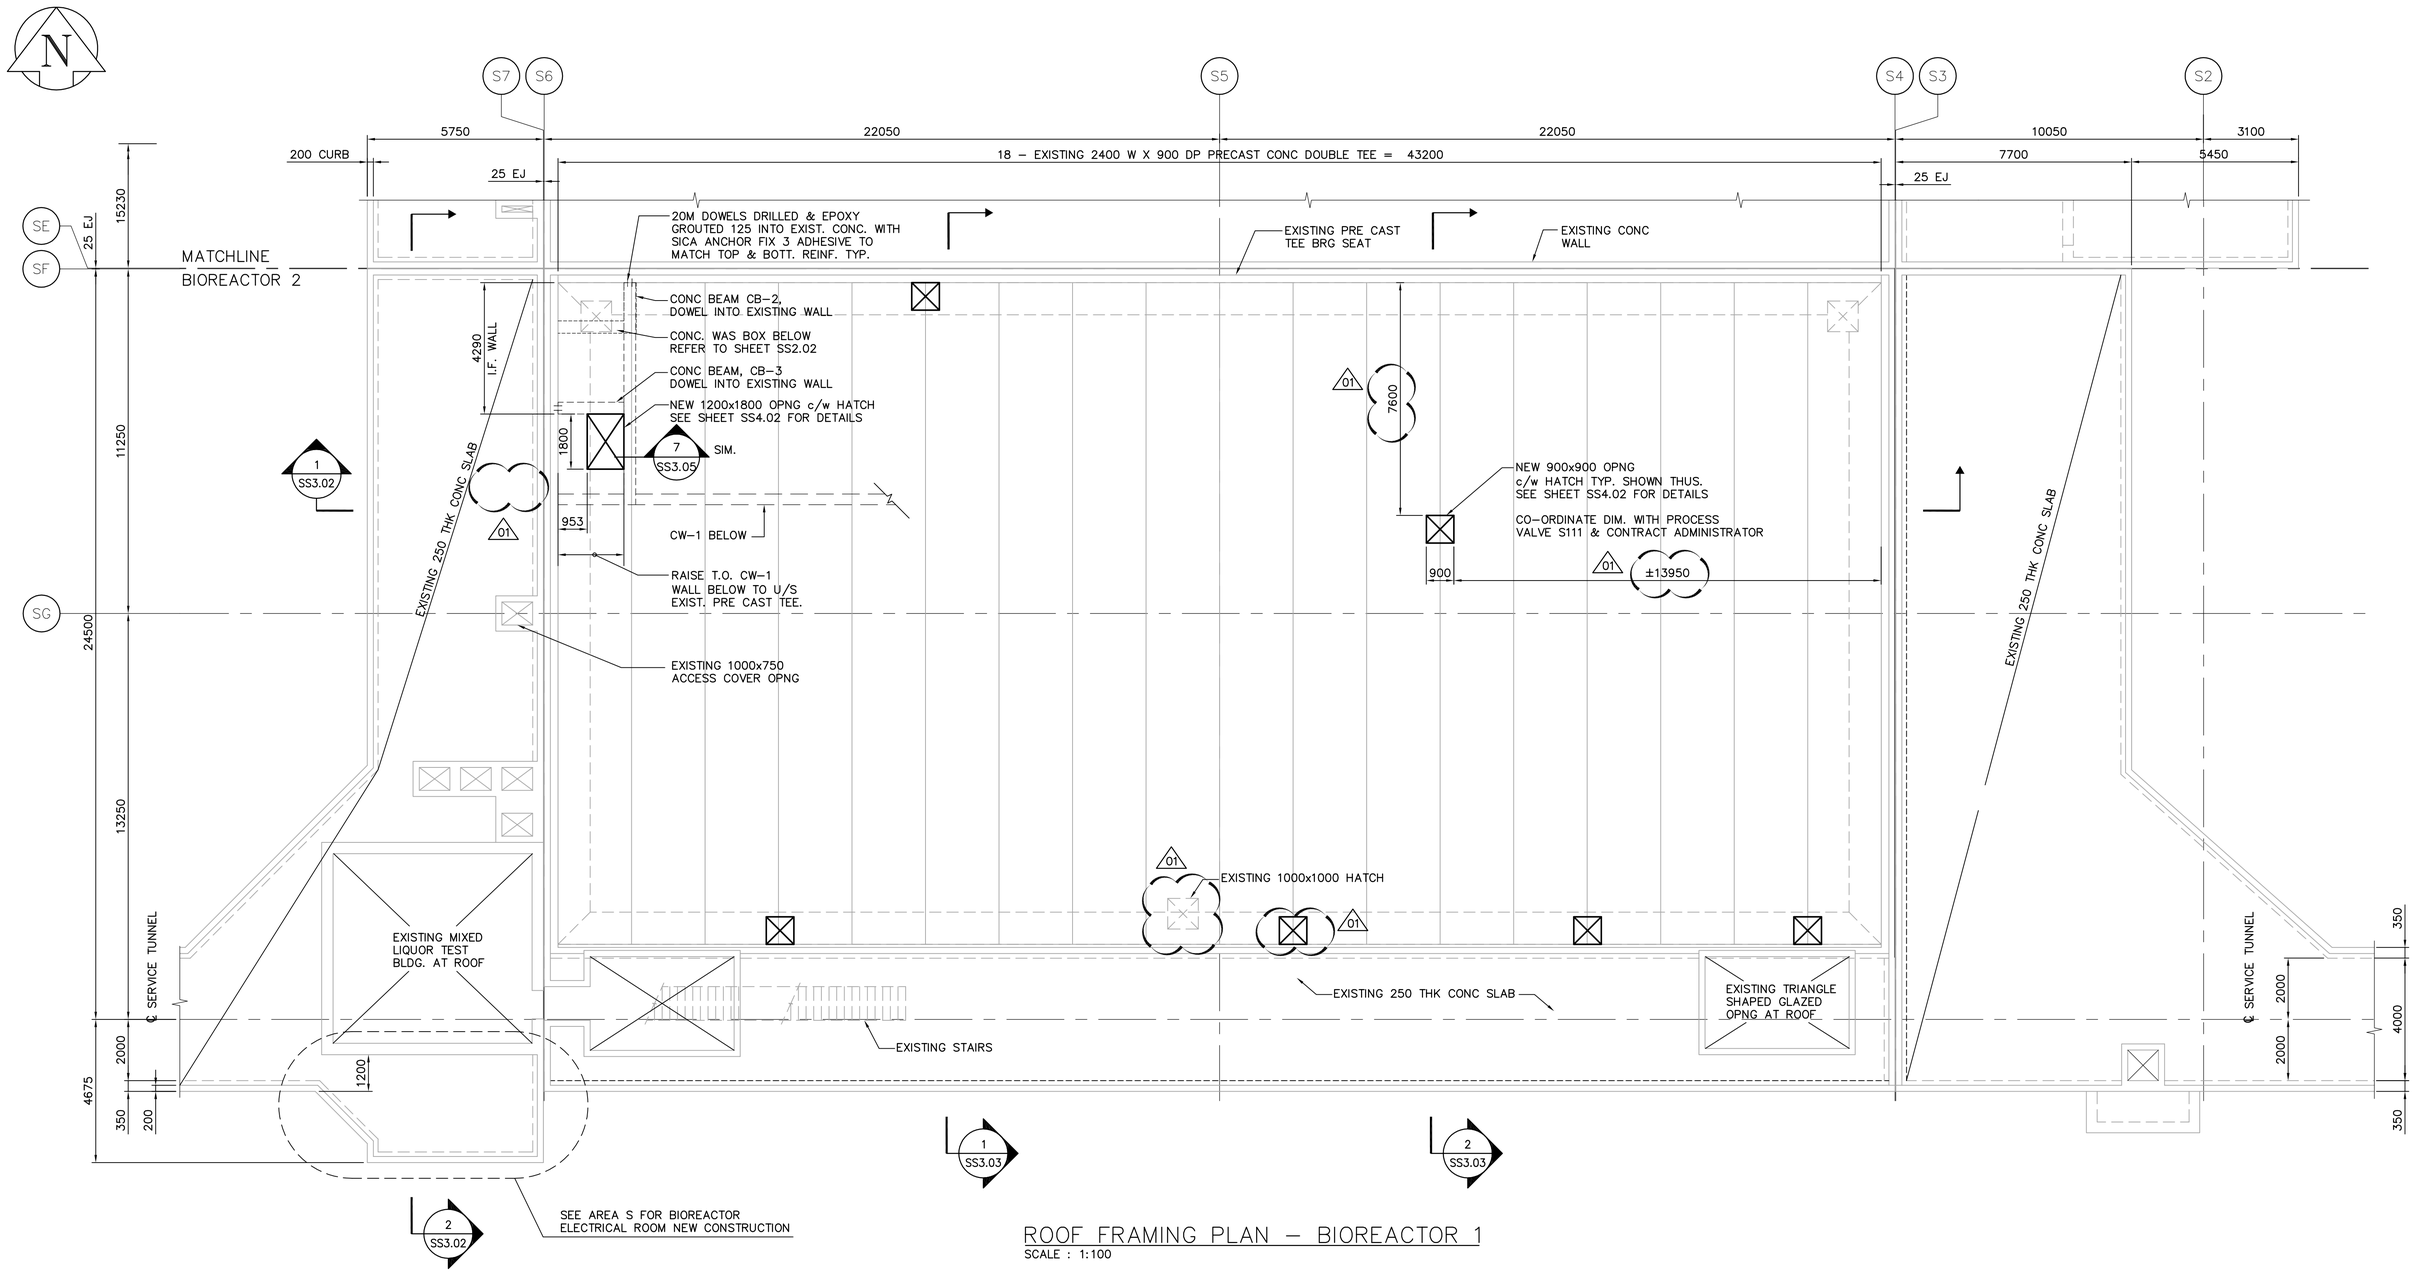

ROOF FRAMING PLAN – BIOREACTOR 1

SCALE : 1:100

NOTES:

1. EXISTING CONCRETE SURFACE TO BE INTENTIONALLY ROUGHENED TO A FULL AMPLITUDE OF 5mm & TO BE CLEAN, SOUND & FREE OF LAINTANCE. EXISTING CONC. TO BE IN A S.S.D. CONDITION FOR 24 HOURS PRIOR TO CASTING OF CONCRETE INFILL WALLS/BEAMS (SEE SECTION 1 SHEET SS3.03). TYPICAL AT NEW & EXISTING INTERSECTION POINTS FOR: CB-1, CB-2, CB-3, CC-1, SL-1 & CW-6
2. SHORE EXISTING PRECAST DOUBLE TEE'S AS REQUIRED TO SUIT NEW CONSTRUCTION.
3. ± DIMENSION

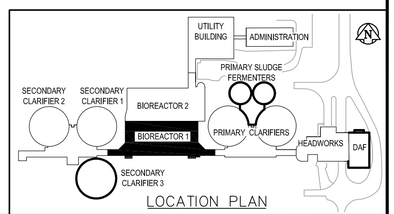

LOCATION PLAN

APEGM
Certificate of Authorization
Earth Tech Canada Inc.
No. 730 Expiry: April 30, 2006

B.M. ELEV.

NO.	REVISIONS	DATE	BY
01	21–2006 ADDENDUM 3	06/05/19	CMF
00	ISSUED FOR TENDER	06/04/26	WDB

EarthTech
A Tyco International Ltd. Company

DESIGNED BY	AA/JB	CHECKED BY	AA/JB
DRAWN BY	WDB	APPROVED BY	JEH
HOR. SCALE: VERTICAL SCALE:	AS NOTED	RELEASED FOR CONSTRUCTION BY:	J. VEILLEUX
DATE	2005/11/15	DATE	2006/04/26

ENGINEER'S SEAL
ORIGINAL SIGNED BY
J. BETKE
2006/04/26

CONSULTANT DRAWING NO.
SS2.03

Winnipeg
THE CITY OF WINNIPEG
WATER AND WASTE DEPARTMENT
ENGINEERING DIVISION

WEWPCC
BIOLOGICAL NUTRIENT REMOVAL UPGRADE
CONTRACT 3

CITY FILE NUMBER
SHEET OF

STRUCTURAL
AREA S – BIOREACTOR 1
ROOF FRAMING PLAN & SCHEDULES

CITY DRAWING NUMBER

05/19/06 12:18pm sondra.polten L:\work\76000\76063\02a-CAD\IND\CONTR\Bioreactor\SS2-03.dwg Layout:BIO. 1