



FOR CONTINUATION SEE DRAWING FP1.03

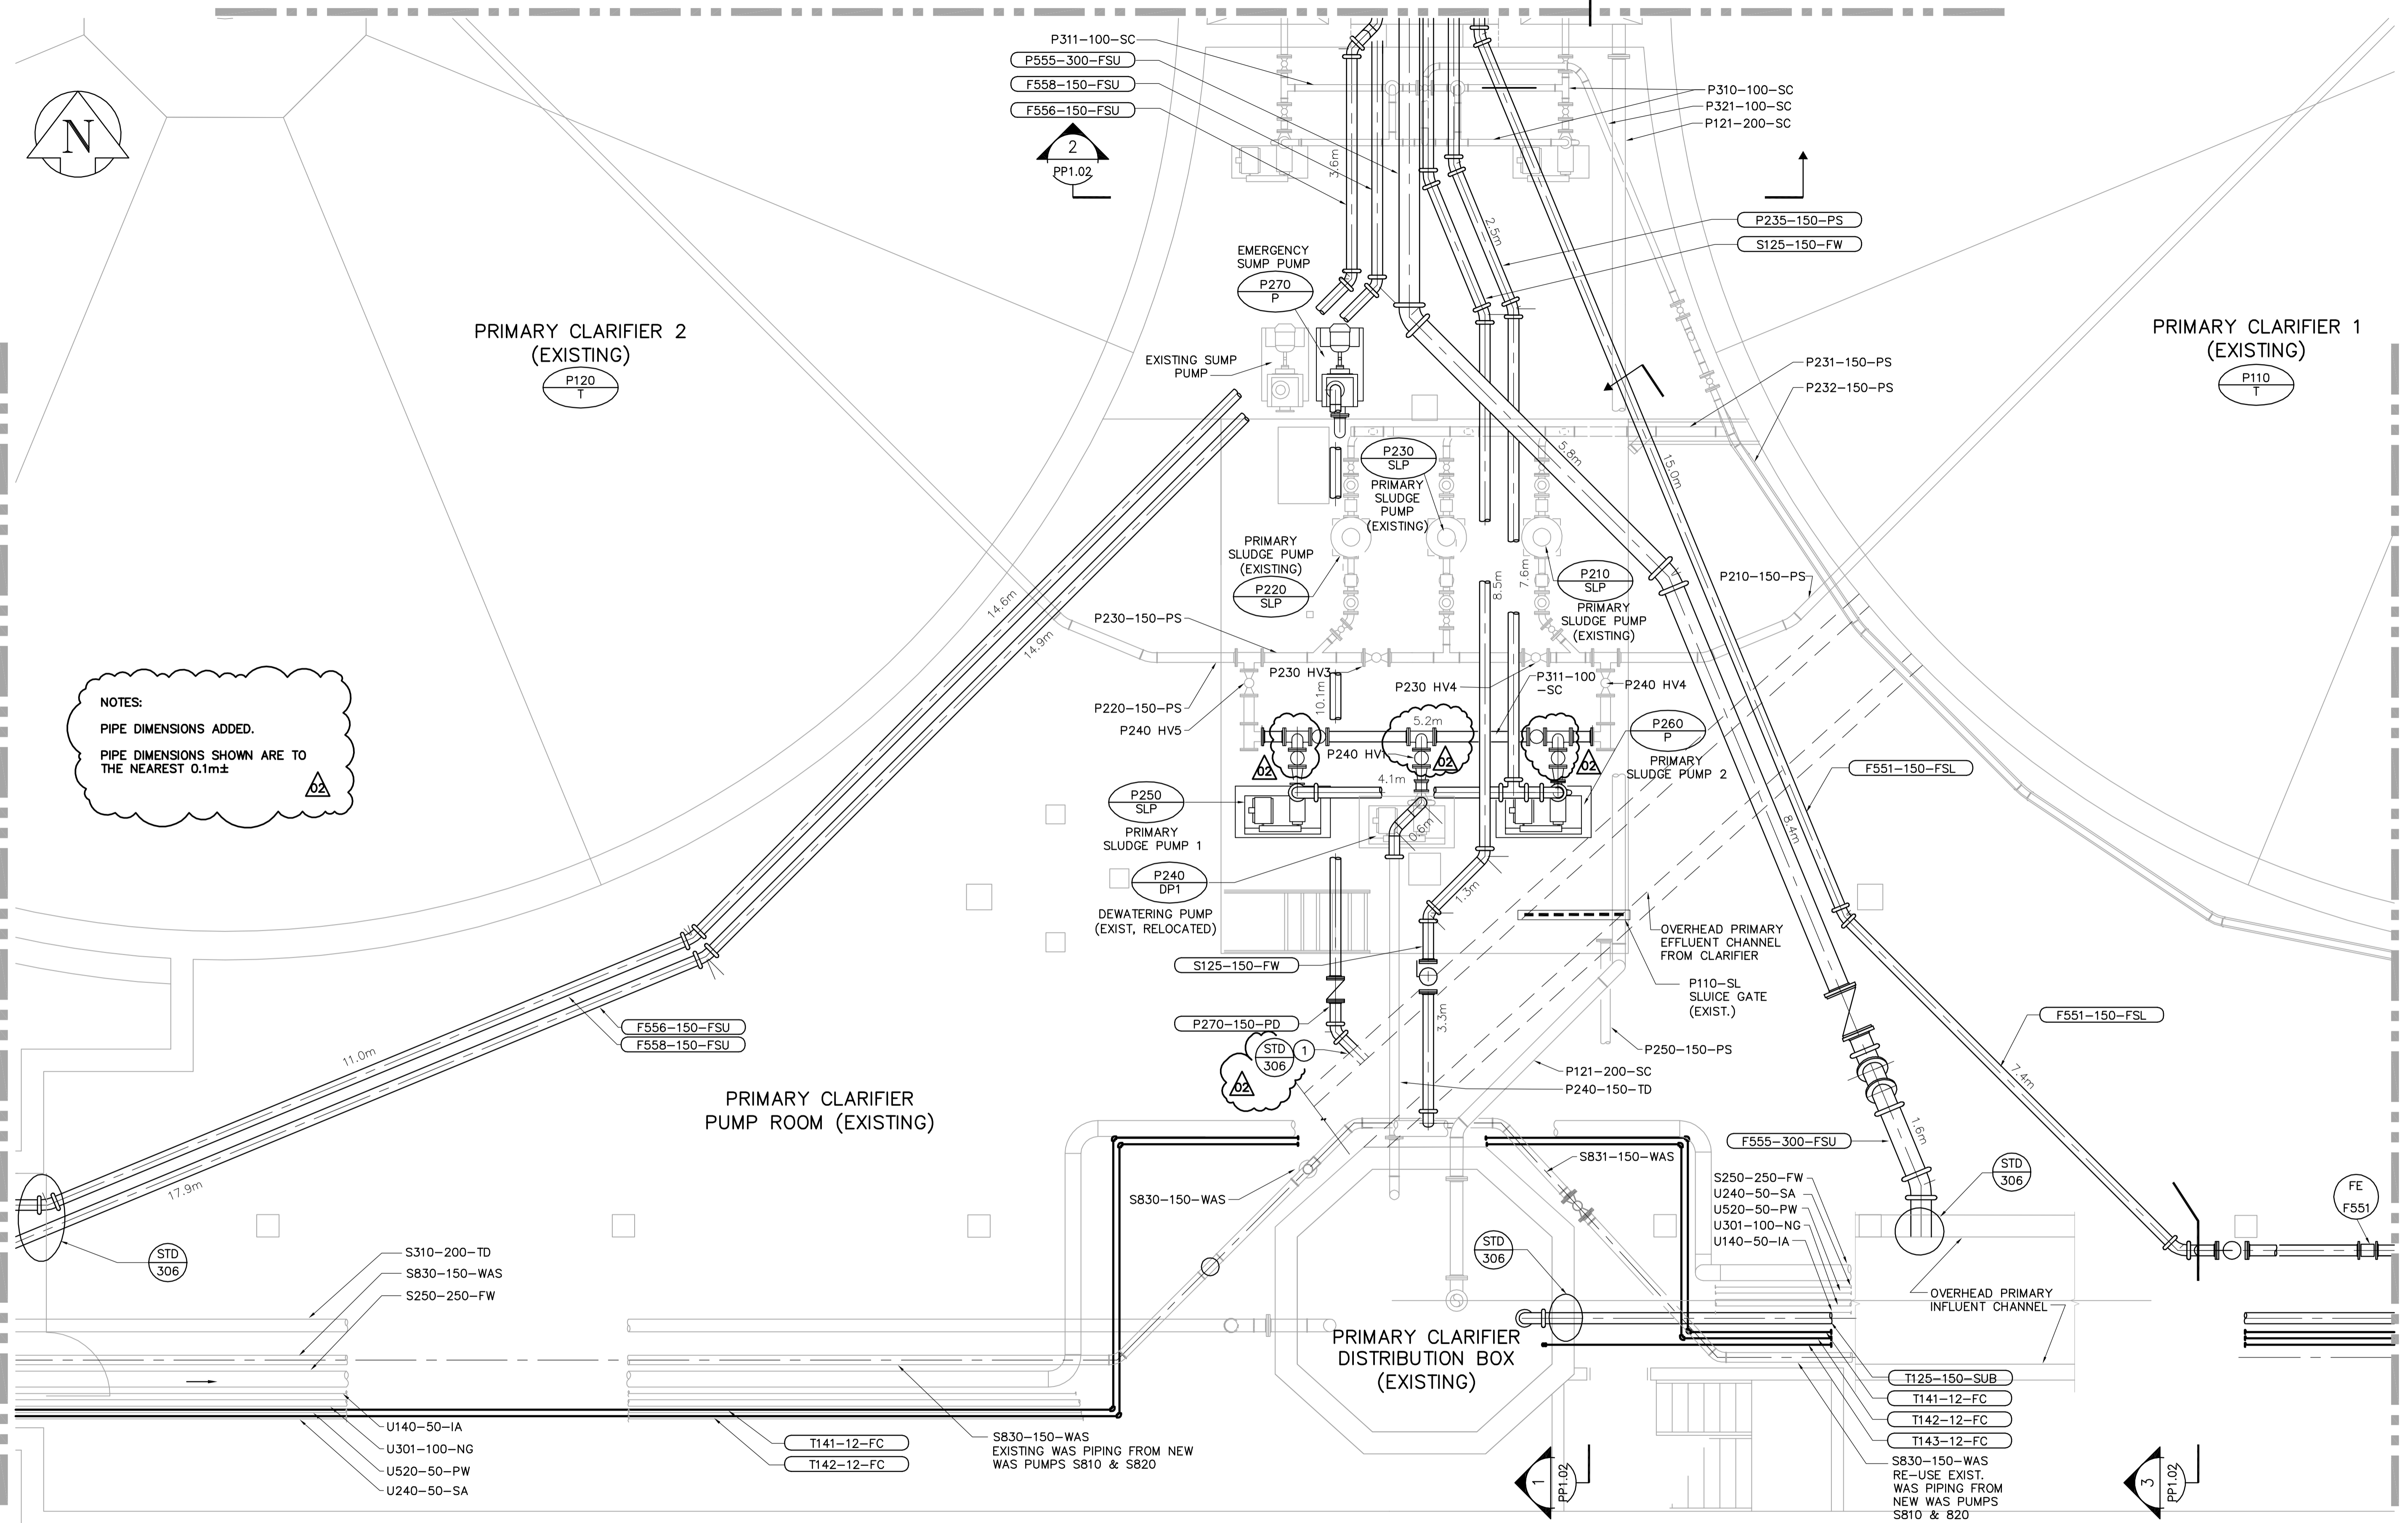

NOTES:
 PIPE DIMENSIONS ADDED.
 PIPE DIMENSIONS SHOWN ARE TO THE NEAREST 0.1m±

FOR CONTINUATION SEE DRAWING SP1.05

FOR CONTINUATION SEE DRAWING HP1.02

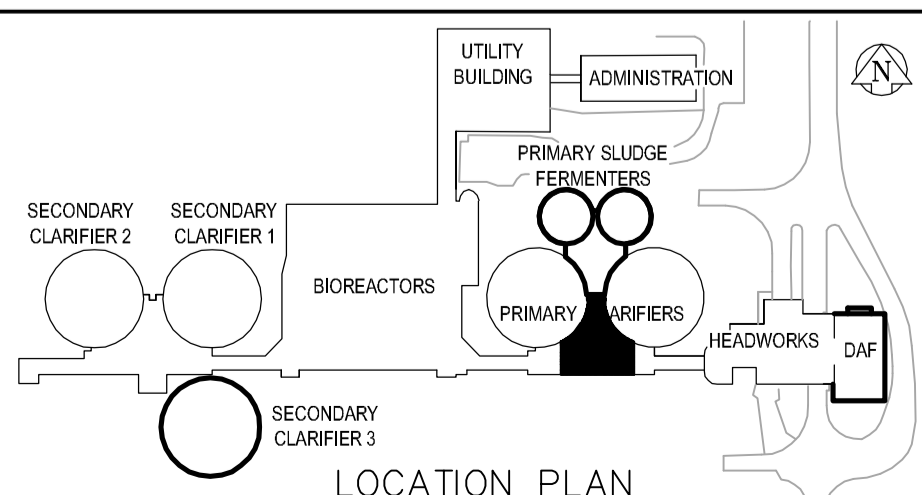

EXISTING PRIMARY CLARIFIERS - PUMP ROOM PLAN
 1:50

DRAWING NOTES

1 TIE (P270-150-PD) INTO THE HEAD SPACE ABOVE THE WATER LINE IN THE OVERHEAD PRIMARY EFFLUENT CHANNEL FROM CLARIFIER DOWNSTREAM OF THE EXIST. P110-SL SLUICE GATE.



NO.	REVISIONS	DATE	BY
02	21-2006 ADDENDUM 6	06/06/30	JBC
01	21-2006 ADDENDUM 3	06/05/19	PJY
00	ISSUED FOR TENDER	06/04/26	SRP

EarthTech
 A Tyco International Ltd. Company

DESIGNED BY: YL	CHECKED BY: KM
DRAWN BY: PJY	APPROVED BY: JEH
HOR. SCALE: 1:50	RELEASED FOR CONSTRUCTION BY: J. VEILLEUX
VERTICAL SCALE:	DATE: 2005/10/06

ENGINEER'S SEAL
 ORIGINAL SIGNED BY: J.E. HUTCHISON
 2006/04/26
 CONSULTANT DRAWING NO. PP1.01

THE CITY OF WINNIPEG
 WATER AND WASTE DEPARTMENT
 ENGINEERING DIVISION

WEWPCC
 BIOLOGICAL NUTRIENT REMOVAL UPGRADE
 CONTRACT 3

PROCESS
 AREA P - PRIMARY CLARIFIERS
 PUMP ROOM - PLAN

CITY FILE NUMBER
 SHEET OF
 CITY DRAWING NUMBER