SHEET: COW-A1 (03/2005)

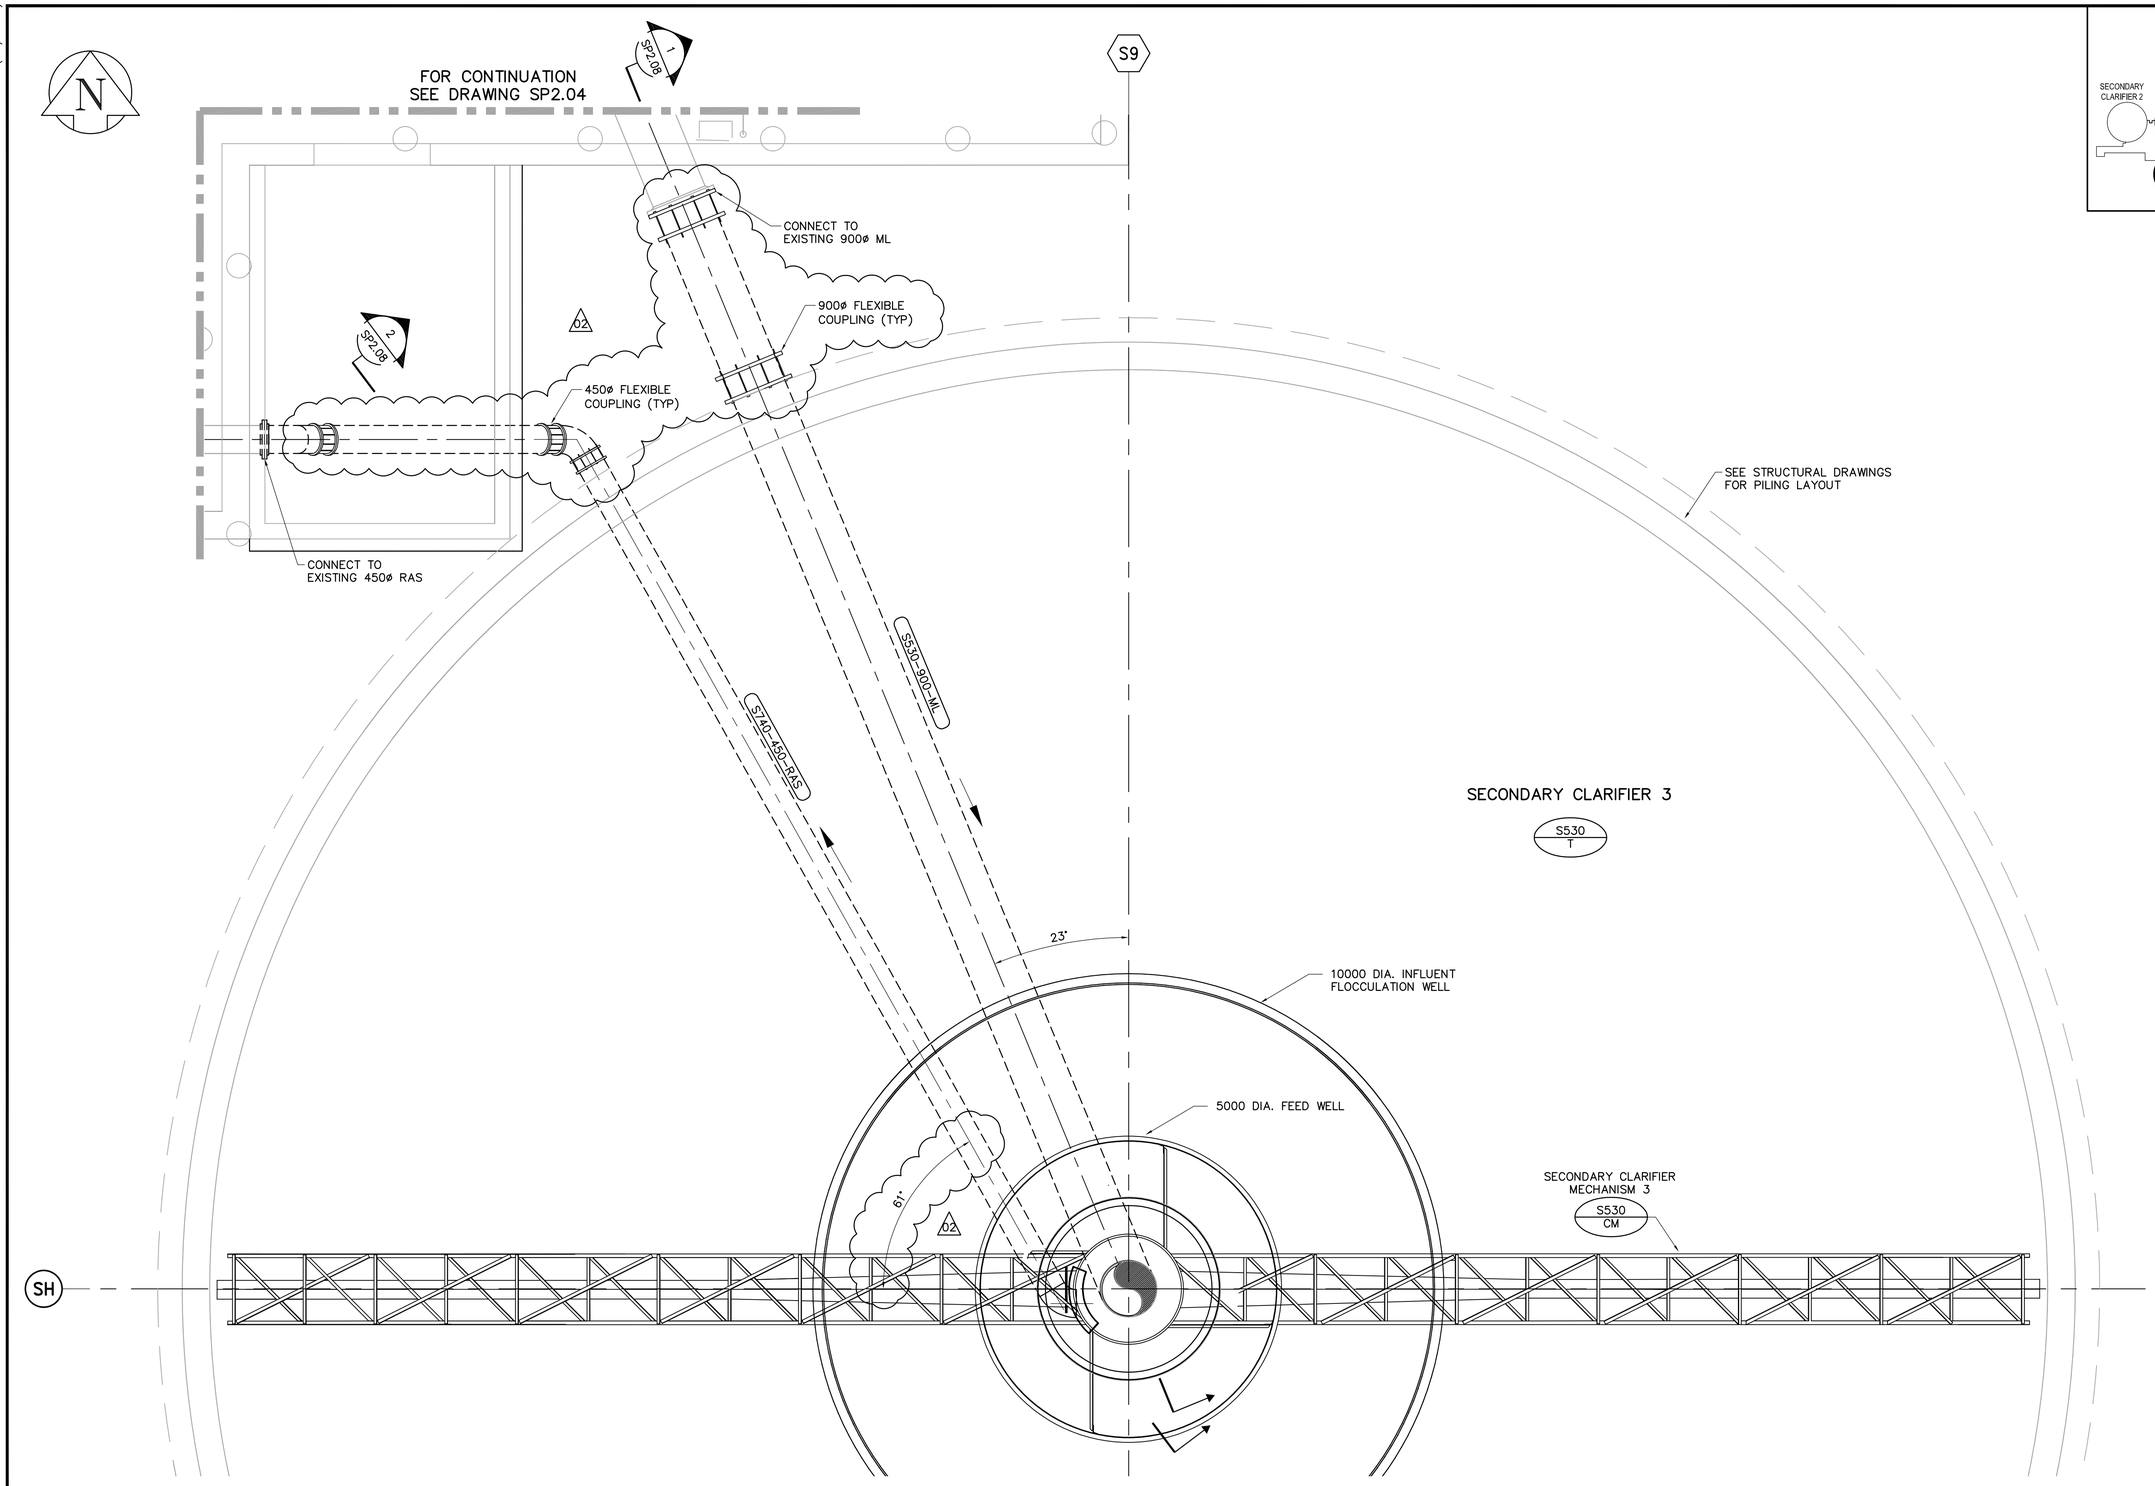

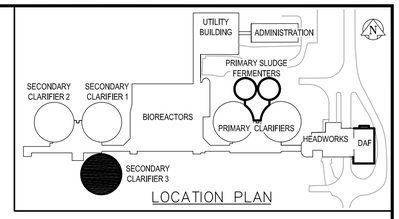

LOWER LEVEL PLAN

1:50

APEGM
Certificate of Authorization
Earth Tech Canada Inc.
No. 730 Expiry: April 30, 2006

GENERAL NOTES

1. CONTRACTOR TO CONFIRM EXISTING PIPE AND EQUIPMENT DIMENSIONS AND LOCATIONS PRIOR TO CONSTRUCTION.

B.M.
ELEV.

NO.	REVISIONS	DATE	BY
02	21-2006 ADDENDUM 6	06/07/05	SRP
01	21-2006 ADDENDUM 3	06/05/19	PAL
00	ISSUED FOR TENDER	06/04/26	SRP

EarthTech
A Tyco International Ltd. Company

DESIGNED BY	KS	CHECKED BY	KM
DRAWN BY	PJY	APPROVED BY	JEH
HOR. SCALE:	AS NOTED	RELEASED FOR CONSTRUCTION BY:	J. VEILLEUX
VERTICAL SCALE:			
DATE	2005/10/06	DATE	2006/04/26

ENGINEER'S SEAL
ORIGINAL SIGNED BY
J.E. HUTCHISON
2006/04/26

CONSULTANT DRAWING NO.
SP2.03

Winnipeg
THE CITY OF WINNIPEG
WATER AND WASTE DEPARTMENT
ENGINEERING DIVISION

WEWPCC
BIOLOGICAL NUTRIENT REMOVAL UPGRADE
CONTRACT 3

PROCESS
AREA S – SECONDARY CLARIFIER 3
LOWER LEVEL PLAN

CITY FILE NUMBER
SHEET OF
CITY DRAWING NUMBER

07/05/06 02:41pm sondra.polten L:\work\76000\76063\02a-CAD\WAT\CONTR\Detail design\AREA S – Secondary Clarifiers and Bioreactors\SP2.03.dwg Layout:Layout1