
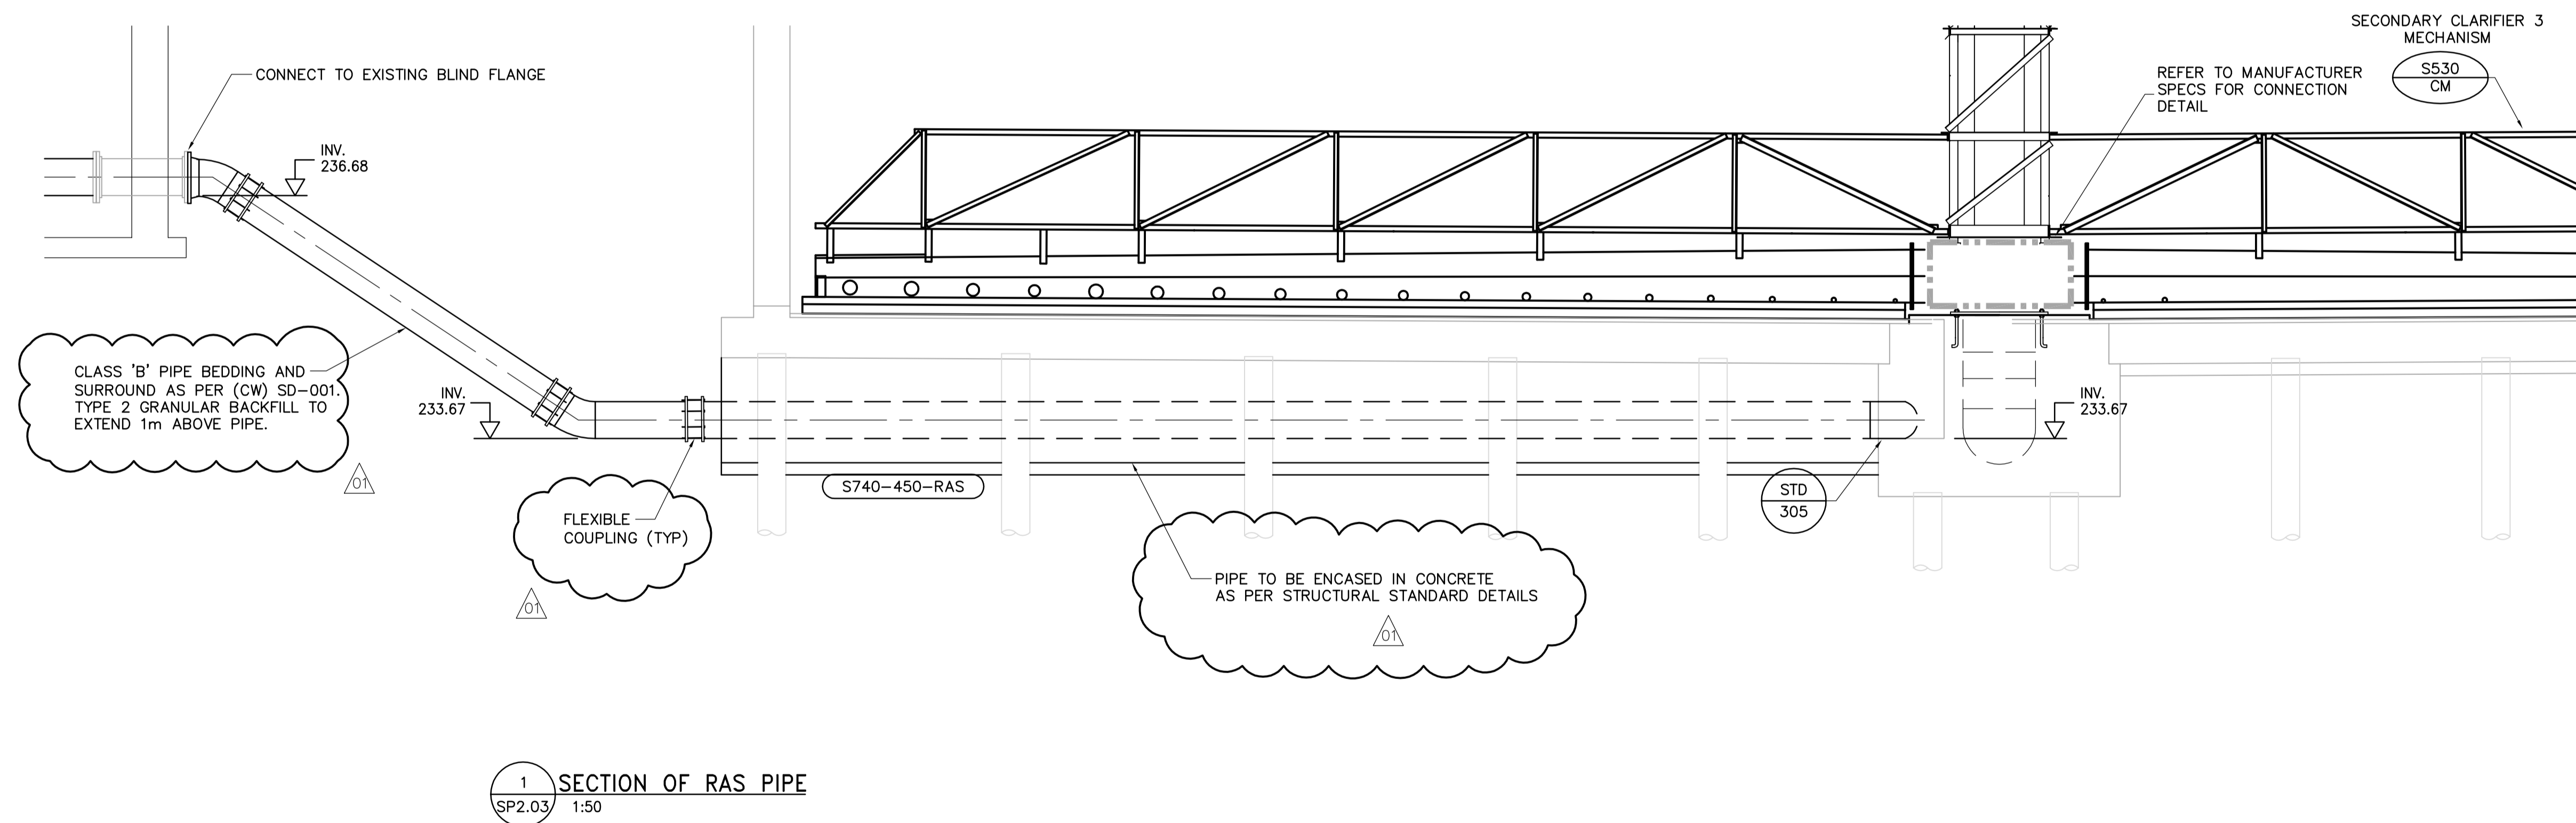


SP2.03 1:50

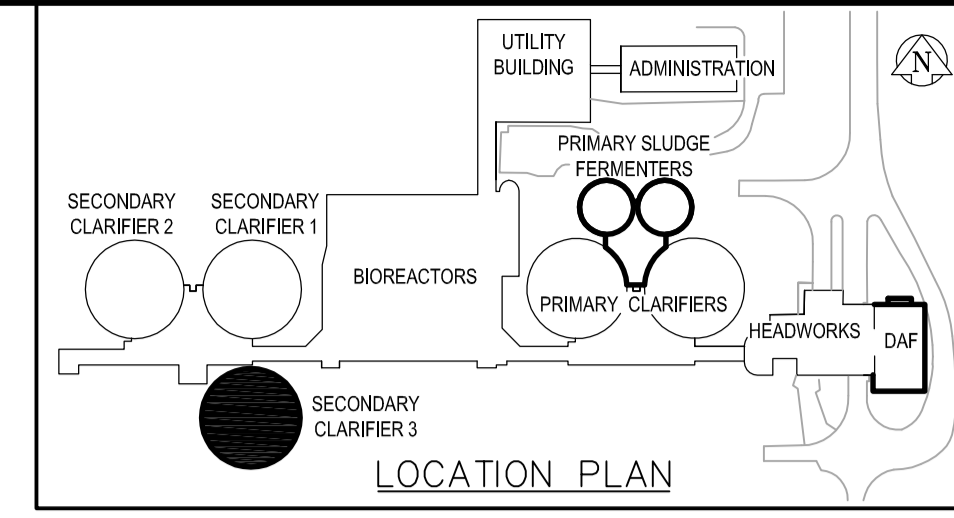

1 SECTION OF RAS PIPE
SP2.03 1:50

GENERAL NOTES

1. CONTRACTOR TO CONFIRM EXISTING PIPE AND EQUIPMENT DIMENSIONS AND LOCATIONS PRIOR TO CONSTRUCTION.



B.M. ELEV.				ENGINEER'S SEAL		THE CITY OF WINNIPEG WATER AND WASTE DEPARTMENT ENGINEERING DIVISION	CITY FILE NUMBER
				ORIGINAL SIGNED BY J.E. HUTCHISON			
DESIGNED BY KS	CHECKED BY KM	DATE 2006/04/26		CONSULTANT DRAWING NO. SP2.08	CITY DRAWING NUMBER		
DRAWN BY PJY	APPROVED BY JEH	HOR. SCALE: 1:50 VERTICAL SCALE:				AREA S - SECONDARY CLARIFIER 3 SECTIONS AND DETAILS	
NO. REVISIONS	DATE	BY	DATE	DATE	DATE		DATE
01	21-2006 ADDENDUM 6	06/07/05	JBC	2005/10/06	2006/04/26		
00	ISSUED FOR TENDER	06/04/26	SRP				