



INSTRUMENT LOOP DIAGRAM

LOOP NO. F551

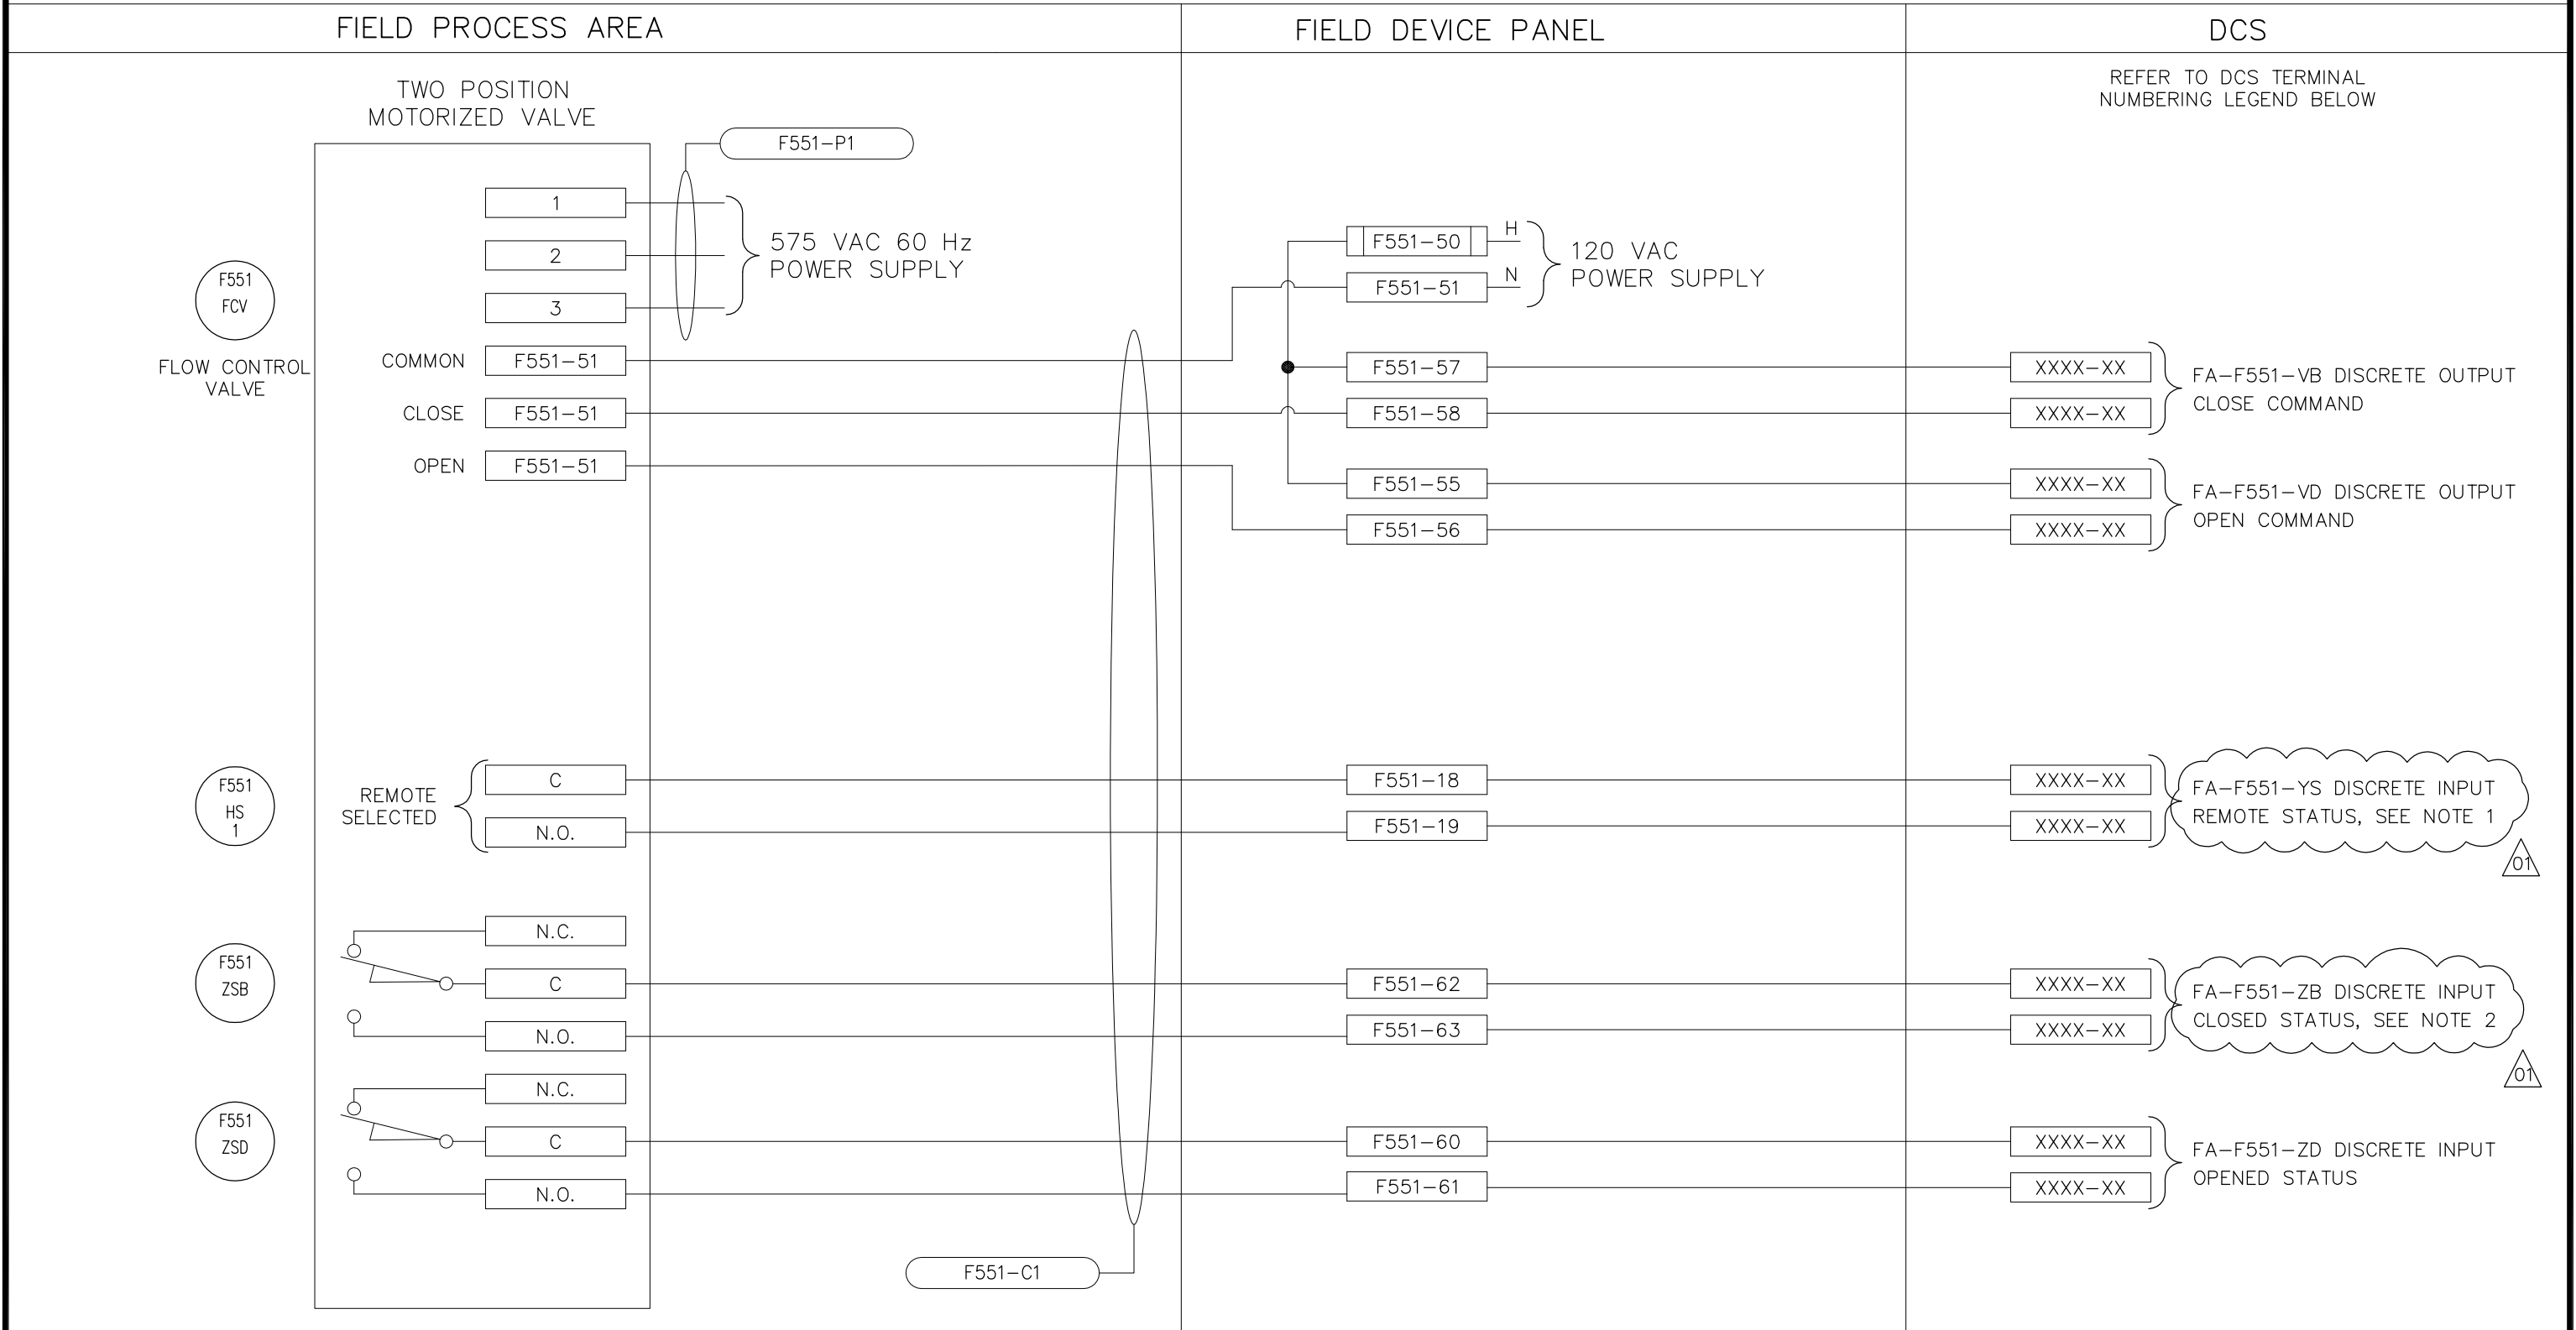

NOTE:

1. THE "YS" INPUT IS NOT REQUIRED FOR MOTORIZED DAMPER NUMBERS T111, T121, F550, F560, F651, F661, F662, AND H710.
2. THE "ZB" INPUT IS NOT REQUIRED FOR MOTORIZED DAMPER NUMBERS T111, T121, F550, F560, F651, AND H710.

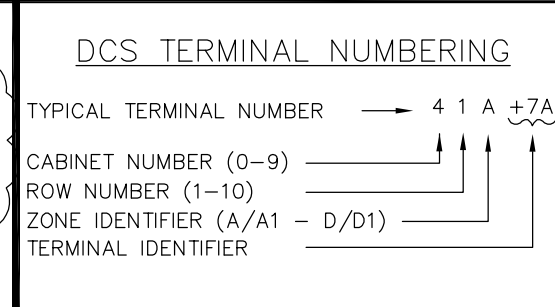

EarthTech		
<small>Earth Tech (Canada) Inc. Winnipeg, Manitoba 204.477.5381</small>		
06/07/10	21-2006 ADDENDUM 8	BL
DATE	REVISION	APP.

THE CITY OF WINNIPEG

Winnipeg WATER AND WASTE DEPARTMENT

WEWPCC - BIOLOGICAL NUTRIENT REMOVAL UPGRADE

INSTRUMENT LOOP DIAGRAM
TWO POSITION MOTORIZED VALVE

SCALE	AS NOTED
DATE	2006/06/05
DES	SWT DWN SRP
CKD	BL APP SWT
DRAWING NO.	ILD-03