D SIZE 22" x 34" (559mm x 864mm)

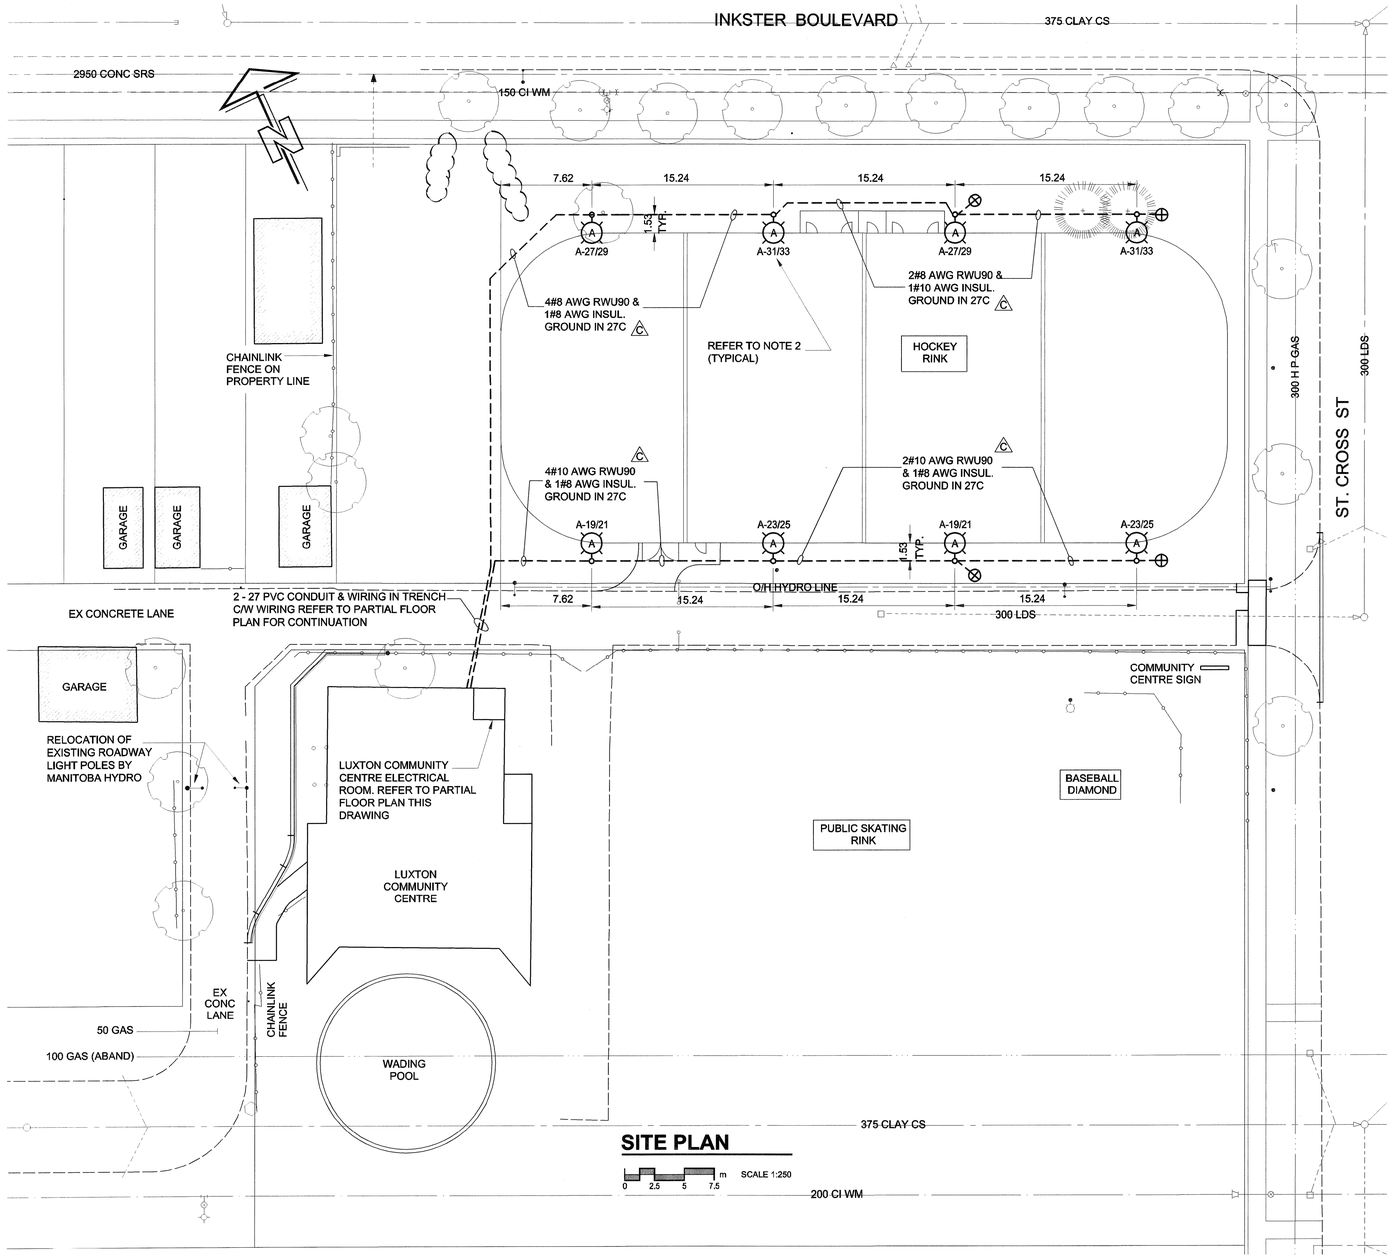

SITE PLAN

0 2.5 5 7.5 m SCALE 1:250

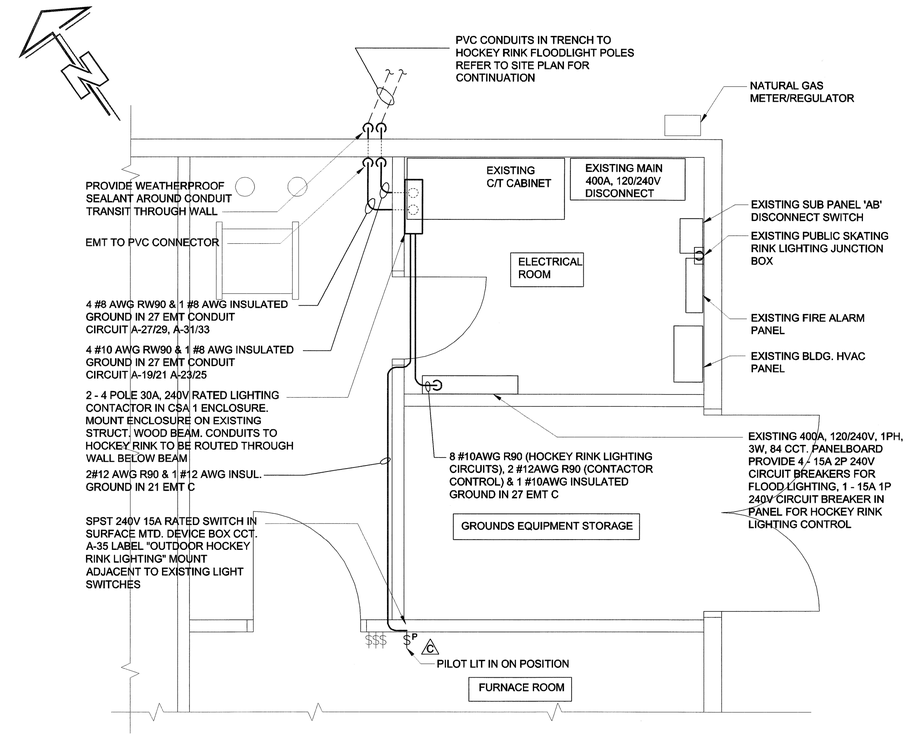

PARTIAL FLOOR PLAN

0 250 500 750 mm SCALE 1:25

NOTES

1. REFER TO CITY OF WINNIPEG STANDARD DRAWING CS-6 FOR ELECTRICAL WORK DESCRIPTION, LIGHT POLE SYSTEMS CONTROLS, LIGHTING POLE CONCRETE BASES AND TRENCH DETAIL.
2. CONTRACTOR TO SUBMIT FLOOD LIGHT SHOP DRAWINGS C/W LIGHTING LEVELS FOR HOCKEY RINK AREA INCLUDING AIMING ANGLES. FLOOD LIGHTS TO BE INSTALLED AND AIMED AS PER SUBMITTED AND APPROVED SHOP DRAWINGS. ALLOW FOR ENGINEER AND CITY OF WINNIPEG REPRESENTATIVE TO WITNESS FINAL INSTALLATION, START UP AND FINAL ADJUSTMENTS OF FLOOD LIGHT AIMING DURING DARK SKY CONDITIONS.
3. SUBMIT SHOP DRAWING FOR LIGHTING CONTRACTOR CONTROLS CABINET, INCLUDING WIRING DIAGRAM.

LEGEND

- EXISTING LIGHT STANDARD
- EXISTING HYDRO POLE
- A-27/29 NEW POLE MOUNTED FLOOD LIGHT
- 20mm Ø X 3m LONG COPPER CLAD GROUND ROD C/W BARE #8 AWG COPPER GROUND CONDUCTOR TO FLOODLIGHT POLE GROUND LUG & CIRCUIT GROUND
- PVC CONDUIT & CABLING IN TRENCH

TENDER NO. 225-2006

LOCATION APPROVED
UNDERGROUND STRUCTURES

SUPR. U/G STRUCTURES COMMITTEE DATE

NOTE:
LOCATION OF UNDERGROUND STRUCTURES AS SHOWN ARE BASED ON THE BEST INFORMATION AVAILABLE. BUT NO GUARANTEE IS GIVEN THAT ALL EXISTING UTILITIES ARE SHOWN OR THAT THE GIVEN LOCATIONS ARE EXACT. CONFIRMATION OF EXISTENCE AND EXACT LOCATION OF ALL SERVICES MUST BE OBTAINED FROM THE INDIVIDUAL UTILITIES BEFORE PROCEEDING WITH CONSTRUCTION.

APEGM
Certificate of Authorization
UMA Engineering Ltd.
No. 256 Expiry: April 30, 2007

NO.	REVISIONS	YY/MM/DD	BY
C	REVISED FOR ADDENDUM	06/07/21	SS
B	REVISED AS PER CITY COMMENTS	06/06/29	QHL
A	ISSUED FOR BID	06/05/17	WJd

UMA | AECOM

© 2006 UMA ENGINEERING LTD. ALL RIGHTS RESERVED.

DESIGNED BY	SCK	CHECKED BY	
DRAWN BY	SCK	APPROVED BY	
HOR. SCALE	AS NOTED	RELEASED FOR CONSTRUCTION	
VERT. SCALE			
DATE		DATE	

PROFESSIONAL'S SEAL
PROVINCE OF MANITOBA
S. K. SMART
Member
20996
July 21, 2006
REGISTERED PROFESSIONAL ENGINEER

CONSULTANT DRAWING NO. E1
0265-378-00

Winnipeg

THE CITY OF WINNIPEG
PUBLIC WORKS DEPARTMENT

LUXTON COMMUNITY CENTRE
SITE DEVELOPMENT PROJECT
Luxton / St. John's Park / Seven Oaks

Building Communities Initiative Plan
ELECTRICAL - PLANS AND DETAILS

CITY DRAWING NUMBER
SHEET 1 OF 1
E1 REV C

PLOT: 7/21/2006 11:37:49 AM

UMA FILE NAME: 0265-378-00_01-E-1001_RX.dwg Saved By: qli