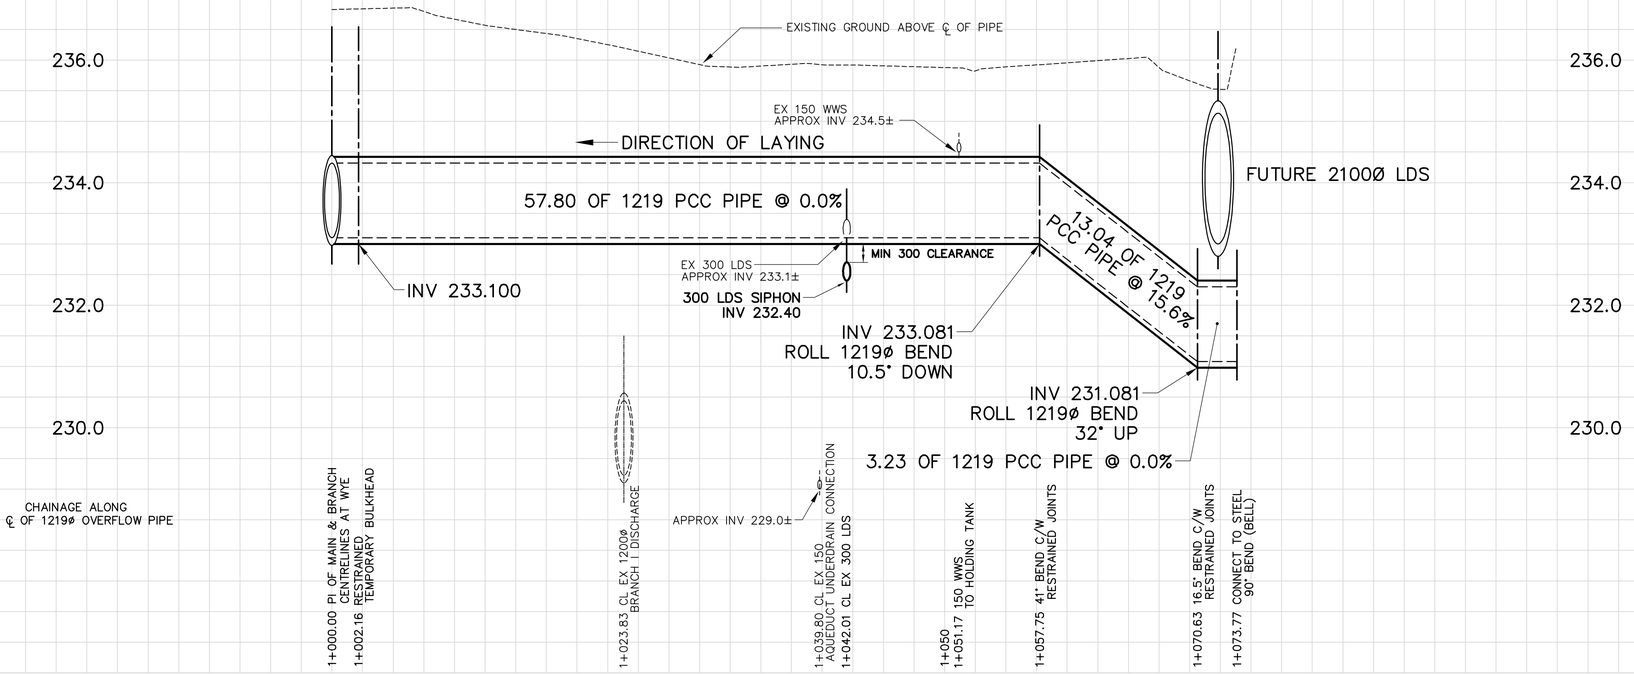

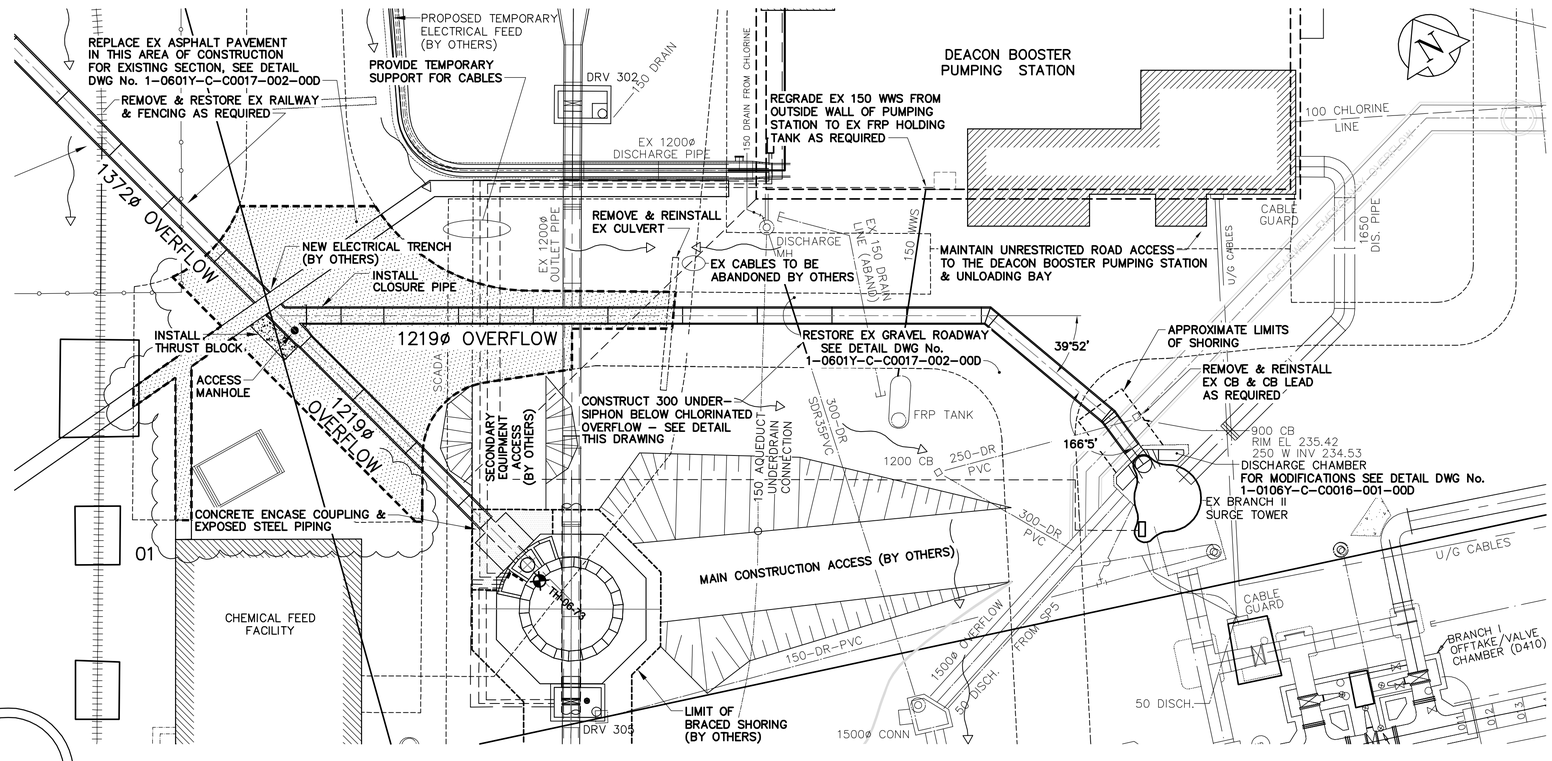

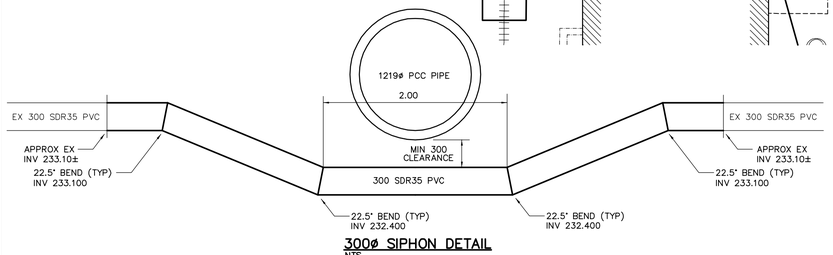

300ø SIPHON DETAIL
NTS

0 10m 20m
SCALE

Certificate of Authorization
UMA Engineering Ltd.
No. 256 Expiry: April 30, 2007

NO.	REVISIONS	DATE	BY
01	36-2006 ADDENDUM 1	06/09/15	WJd
0	ISSUED FOR TENDER	06/08/25	WJd

B.M. ELEV.

UMA | AECOM

©2005 UMA ENGINEERING LTD. ALL RIGHTS RESERVED.

DESIGNED BY	EDT	CHECKED BY	CCM
DRAWN BY	WJd	APPROVED BY	CCM
HOR. SCALE: 1:250 VERTICAL SCALE: 1:50		RELEASED FOR CONSTRUCTION BY:	R. Amann
DATE	2006/05/31	DATE	August 28, 2006

ENGINEER'S SEAL

ORIGINAL SIGNED BY

E. D. J. TOUPIN

2006/08/25

CONSULTANT DRAWING NO.

WY C012

Winnipeg

THE CITY OF WINNIPEG
WATER AND WASTE DEPARTMENT
ENGINEERING DIVISION

WINNIPEG WATER TREATMENT PROGRAM
CONSTRUCTION OF SURGE TOWER OVERFLOW PIPING

CITY FILE NUMBER

SHEET 1 OF 1

CIVIL
SURGE TOWER OVERFLOW PIPING – PLAN & PROFILE
1219ø OVERFLOW PIPE TO 1372x1219 WYE

CITY DRAWING NUMBER

1-0601Y-C-C0012-001-01D