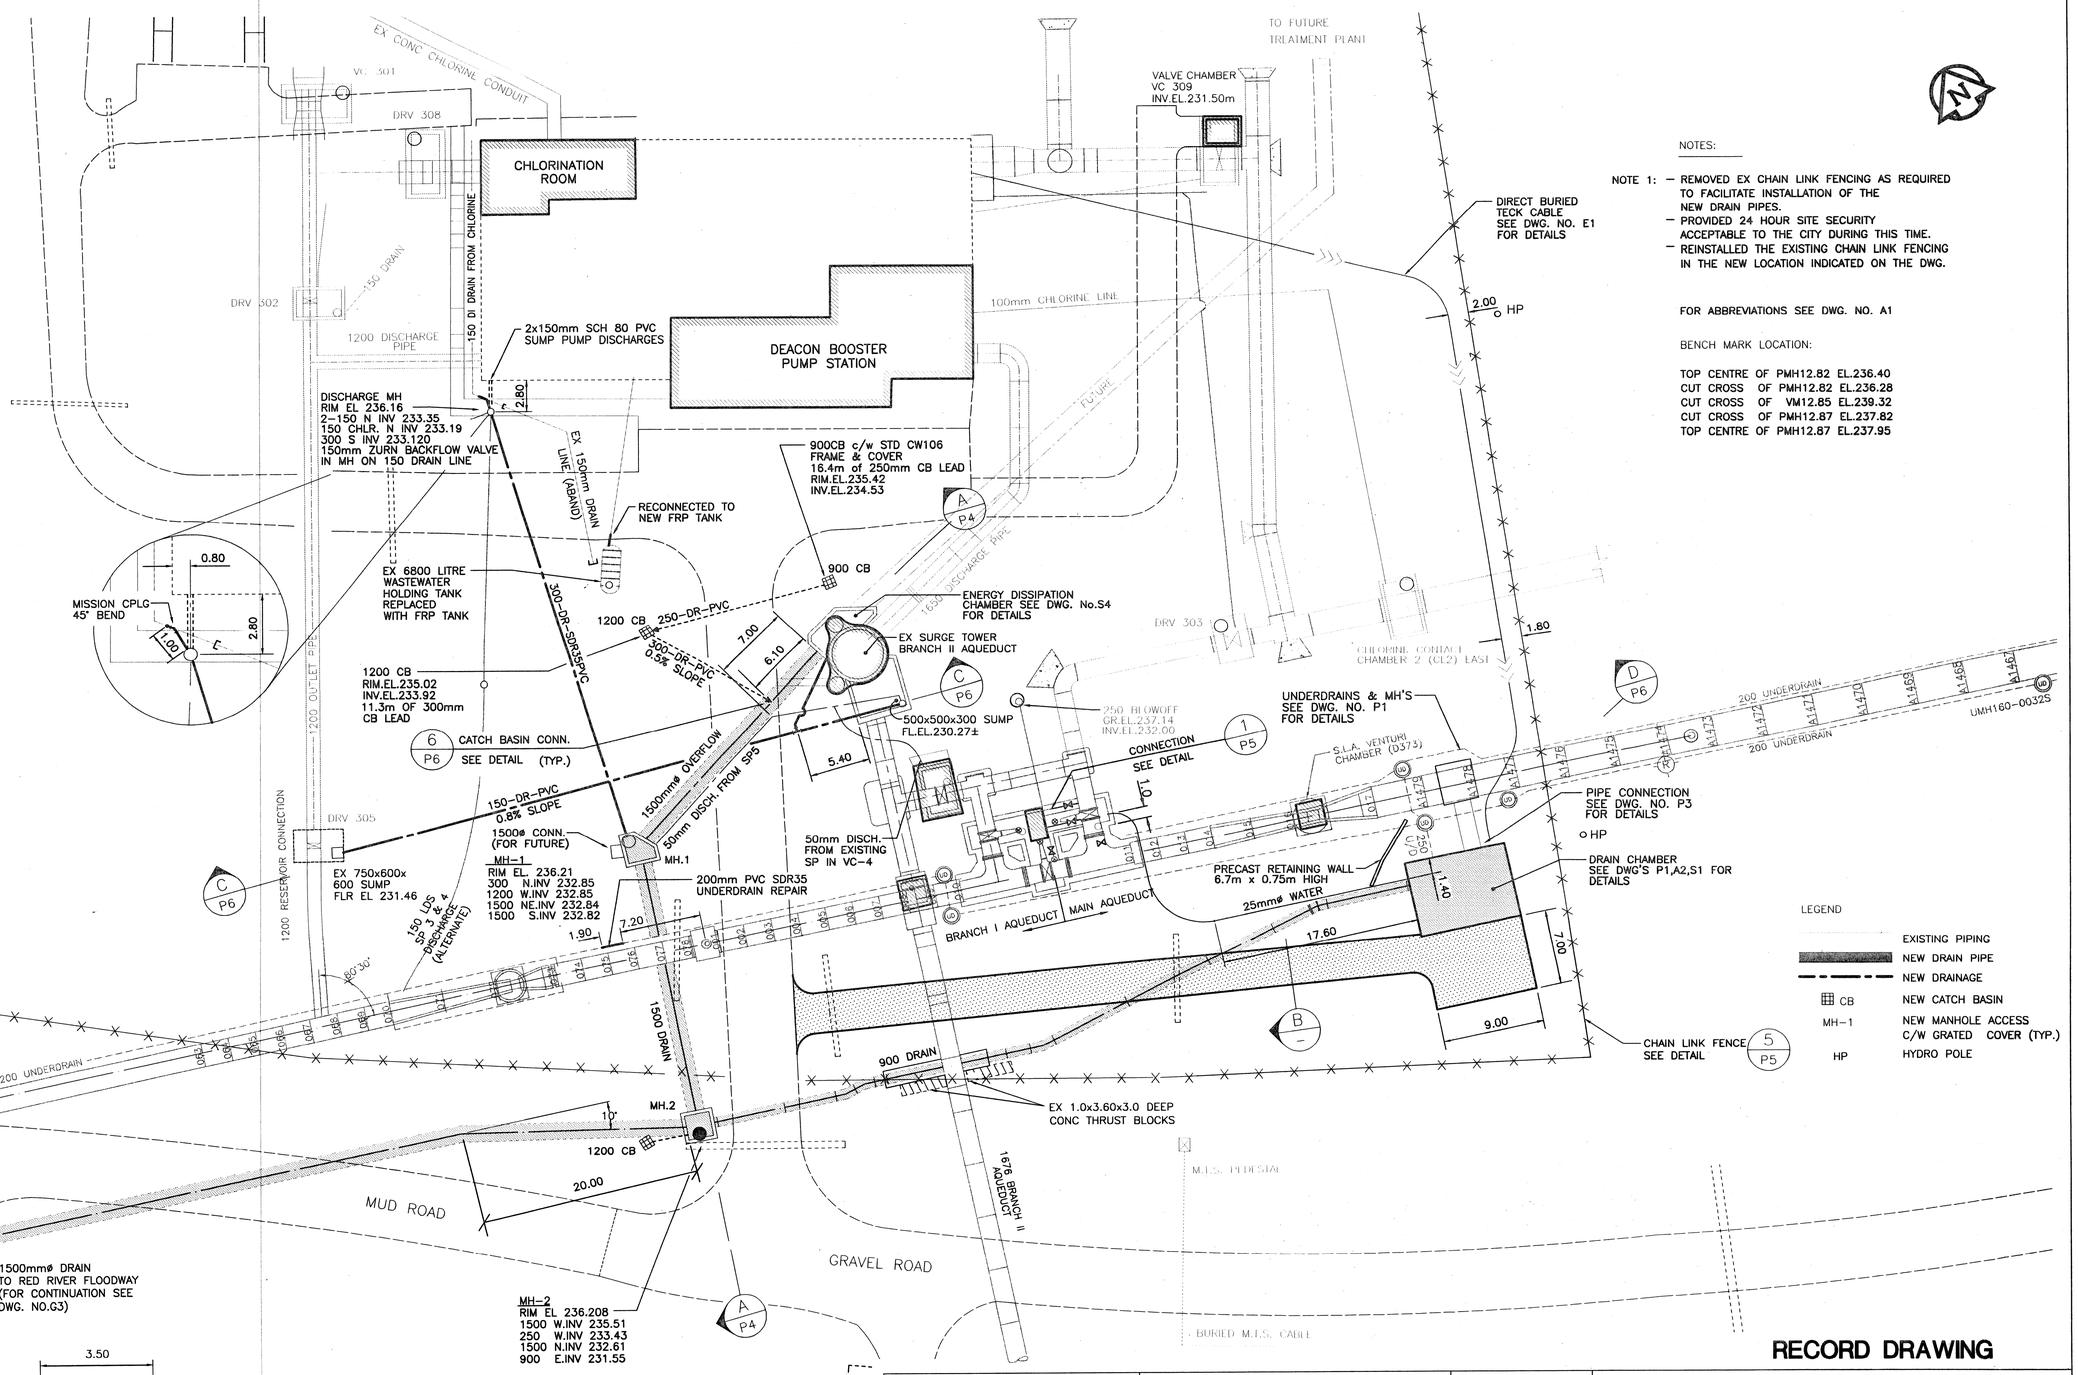

NOTES:

NOTE 1: – REMOVED EX CHAIN LINK FENCING AS REQUIRED TO FACILITATE INSTALLATION OF THE NEW DRAIN PIPES.
– PROVIDED 24 HOUR SITE SECURITY ACCEPTABLE TO THE CITY DURING THIS TIME.
– REINSTALLED THE EXISTING CHAIN LINK FENCING IN THE NEW LOCATION INDICATED ON THE DWG.

FOR ABBREVIATIONS SEE DWG. NO. A1

BENCH MARK LOCATION:

TOP CENTRE OF PMH12.82 EL.236.40
CUT CROSS OF PMH12.82 EL.236.28
CUT CROSS OF VM12.85 EL.239.32
CUT CROSS OF PMH12.87 EL.237.82
TOP CENTRE OF PMH12.87 EL.237.95

These record documents have been prepared based on information provided by others. The design professional has not verified the accuracy and/or the completeness of this information and shall not be responsible for any errors or omissions which may be incorporated herein as a result.

NO.	REVISIONS	DATE	BY
R2	RECORD DRAWING	Apr.99	CAA
R1	RECORD DRAWING	Nov.98	WJd

B.M. ELEV.

CH2M GORE & STORRIE LIMITED

DESIGNED BY	ML	CHECKED BY	ARP,CCM
DRAWN BY	ML, WJd	APPROVED BY	
HOR. SCALE	1:250	RELEASED FOR CONSTRUCTION	
VERTICAL			
DATE	1996.09.09	DATE	

ENGINEER'S SEAL

ORIGINAL TENDER DRAWING SEALED

CONSULTANT DRAWING NO. 60010-53-A1-15504

RECORD DRAWING

THE CITY OF WINNIPEG
WORKS AND OPERATIONS DIVISION
WATER AND WASTE DEPARTMENT

SHOAL LAKE AQUEDUCT
MILE 12.86 DRAIN CHAMBER AND OUTFALL
DEACON BOOSTER PUMPING STATION COMPOUND
YARD PIPING

CITY DRAWING NUMBER D-4352A
SHEET 4 OF 23
G4 REV. R2

AutoCAD Version:14