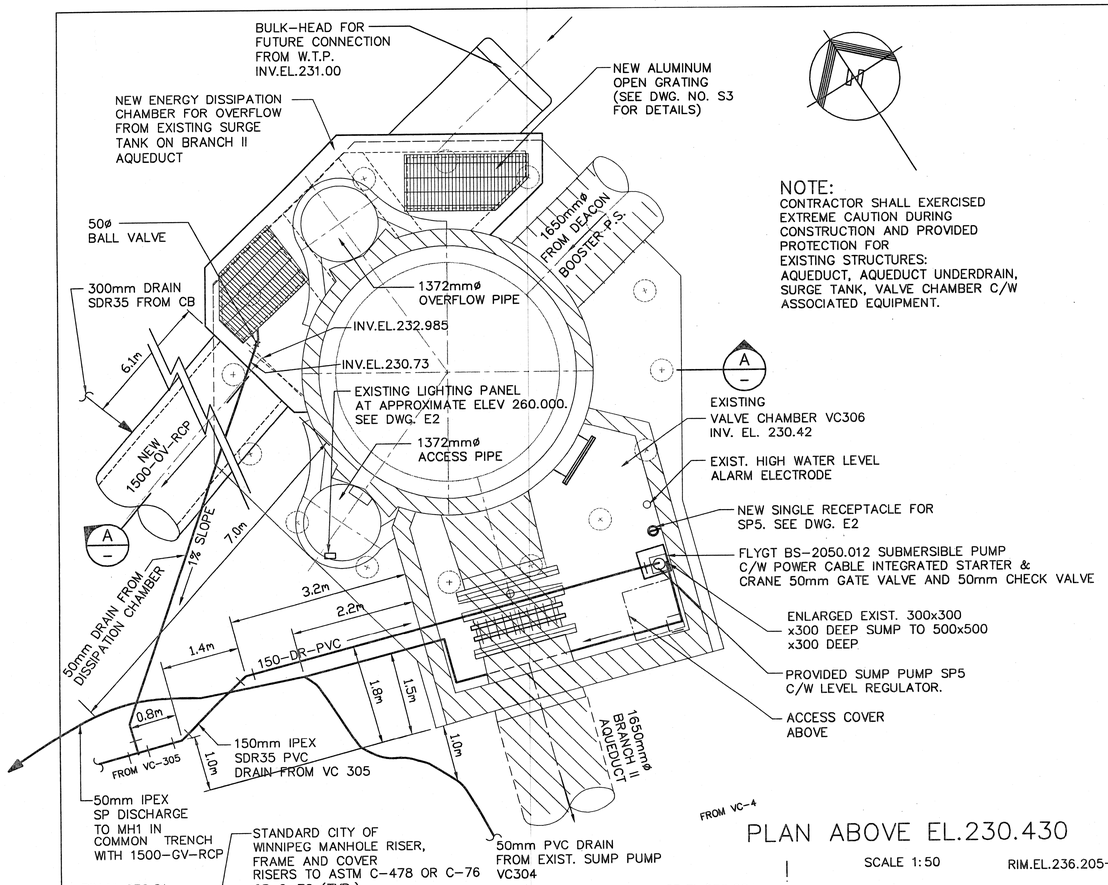

NOTE:
CONTRACTOR SHALL EXERCISED EXTREME CAUTION DURING CONSTRUCTION AND PROVIDED PROTECTION FOR EXISTING STRUCTURES: AQUEDUCT, AQUEDUCT UNDERDRAIN, SURGE TANK, VALVE CHAMBER C/W ASSOCIATED EQUIPMENT.

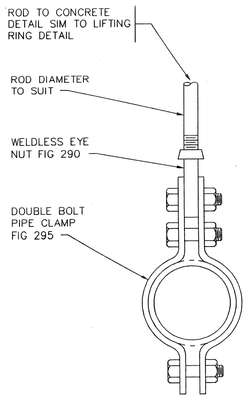

HANGER ROD DIA	
PIPE SIZE	ROD DIA
25	10
30	10
40	10
50	10
65	12
75	12
100	16
150	20
200	22
250	22
300	22
350	25
400	25
450	28
500	32
600	38

ADJUSTABLE PIPE HANGER (TYPE 2)

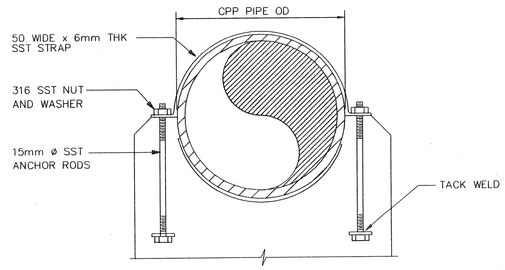

SUPPORT FOR CPP PIPE

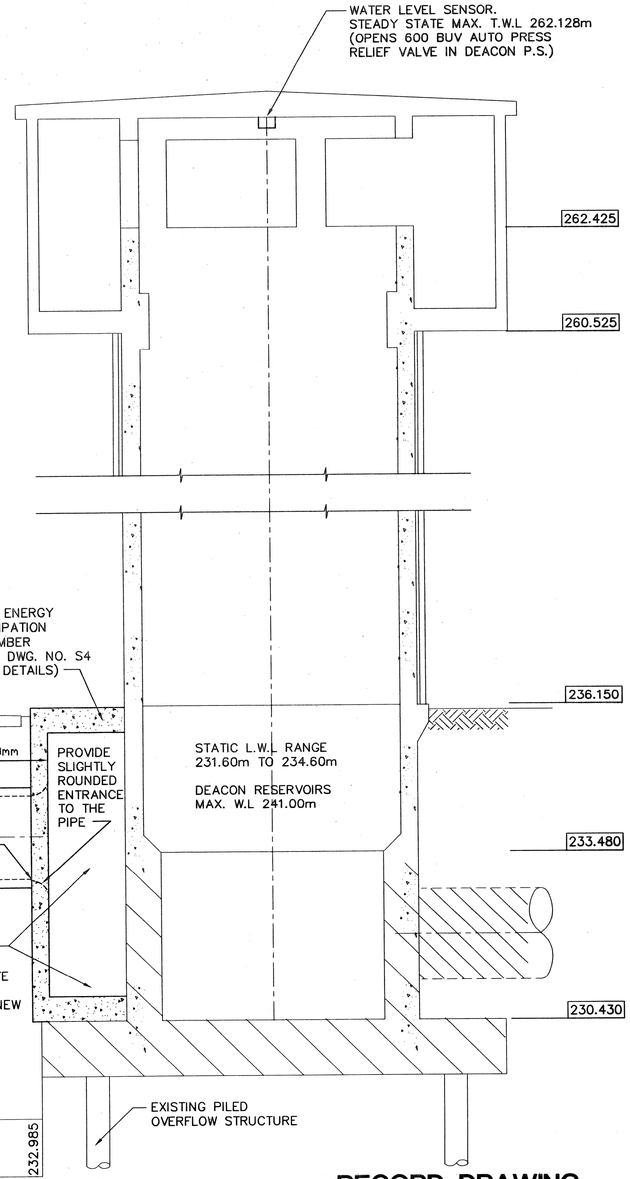


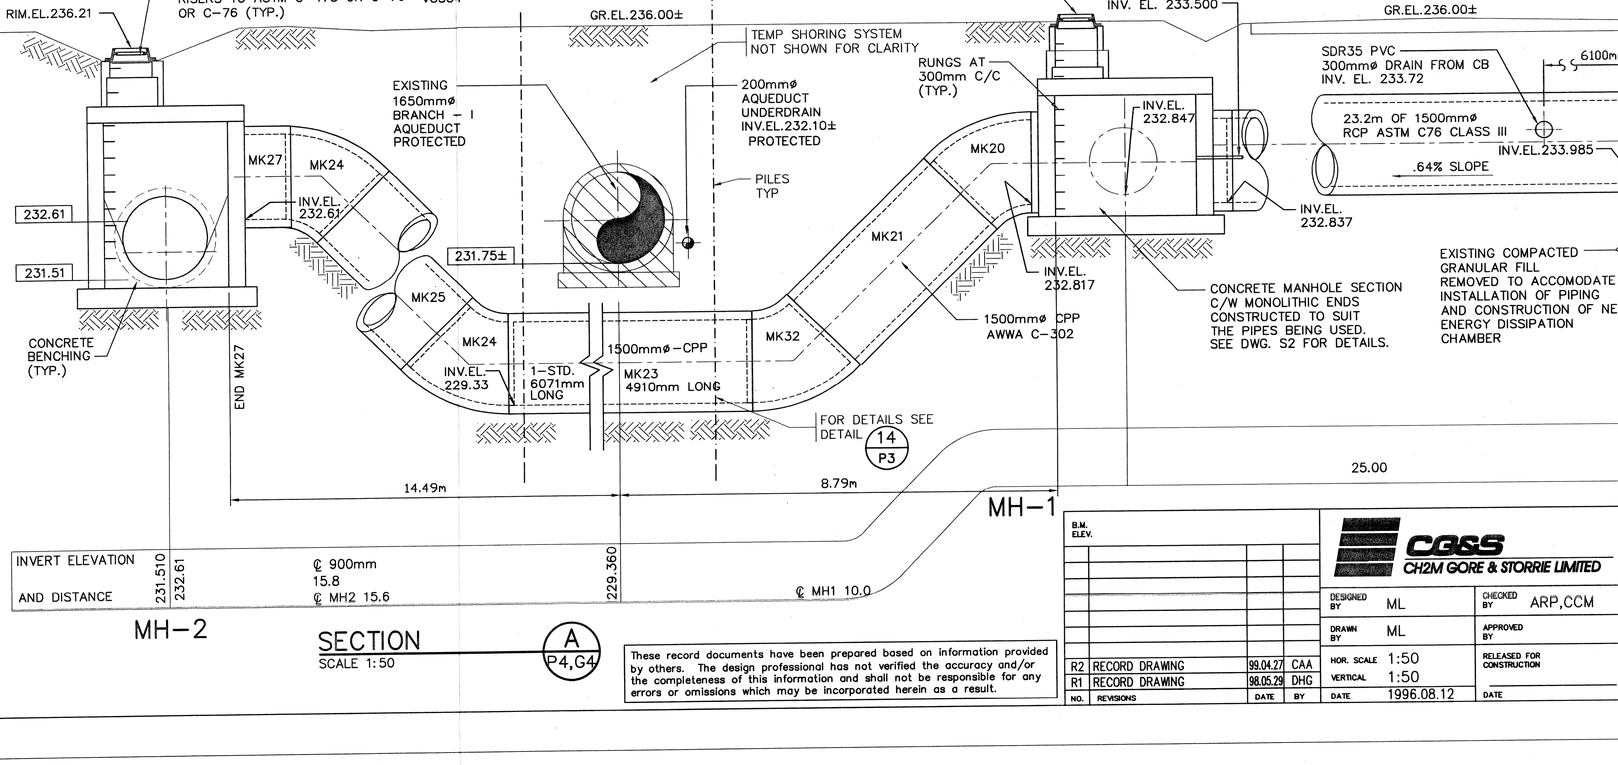

SECTION
SCALE 1:50
A P4,G4

These record documents have been prepared based on information provided by others. The design professional has not verified the accuracy and/or the completeness of this information and shall not be responsible for any errors or omissions which may be incorporated herein as a result.

NO.	REVISIONS	DATE	BY
R2	RECORD DRAWING	99.04.27	CAA
R1	RECORD DRAWING	98.05.29	DHG

B.M. ELEV.

CB&S CH2M GORE & STORRIE LIMITED

DESIGNED BY	ML	CHECKED BY	ARP,CCM
DRAWN BY	ML	APPROVED BY	
HOR. SCALE	1:50	RELEASED FOR CONSTRUCTION	
VERTICAL	1:50		
DATE	1996.08.12	DATE	

ENGINEER'S SEAL
ORIGINAL TENDER DRAWING SEALED

CONSULTANT DRAWING NO. 60010-53-A1-15518

THE CITY OF WINNIPEG
WORKS AND OPERATIONS DIVISION
WATER AND WASTE DEPARTMENT

SHOAL LAKE AQUEDUCT
MILE 12.86 DRAIN CHAMBER AND OUTFALL OVERFLOW FROM SURGE TANK-BRANCH II
PLANS AND SECTIONS

CITY DRAWING NUMBER D-4363B
SHEET 18 OF 23
P4 REV. R2

RECORD DRAWING

AutoCAD Version:14