SHEET: COW-A1 (05/2005)

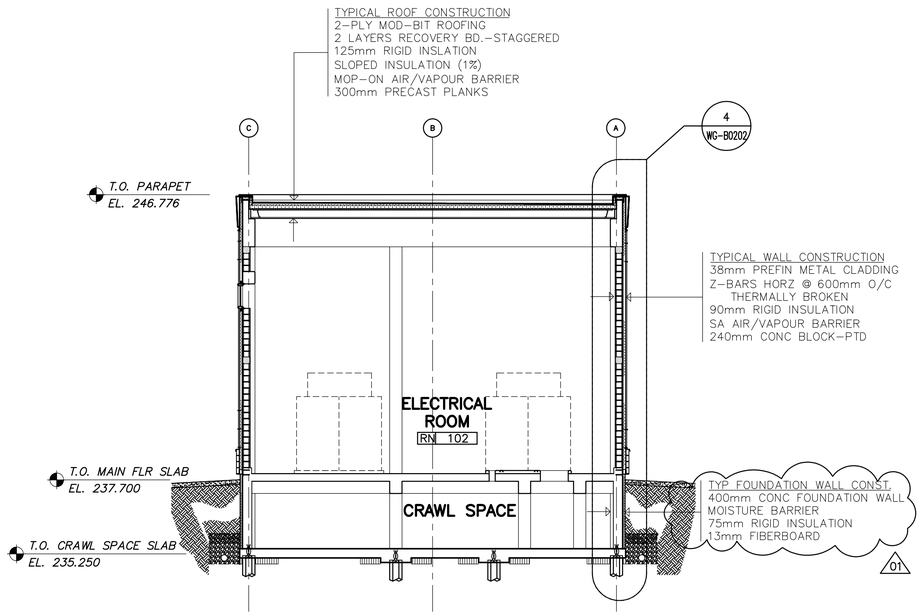

2 WG-B0100 BULDING SECTION
1:100

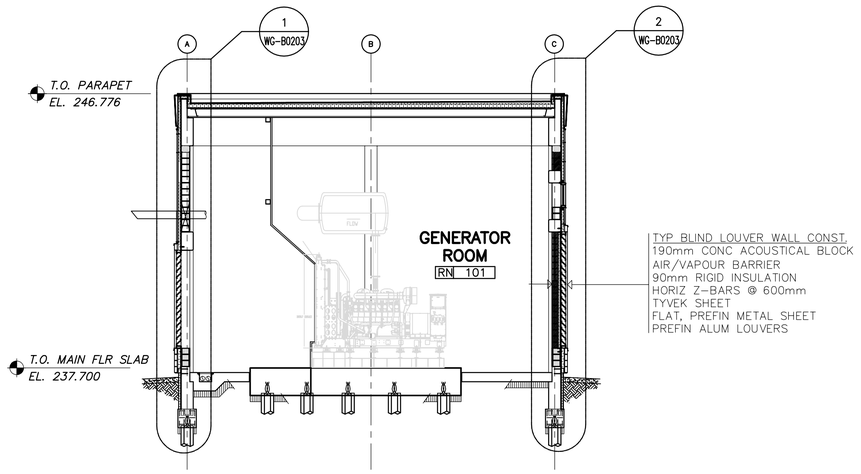

3 WG-B0100 BULDING SECTION
1:100

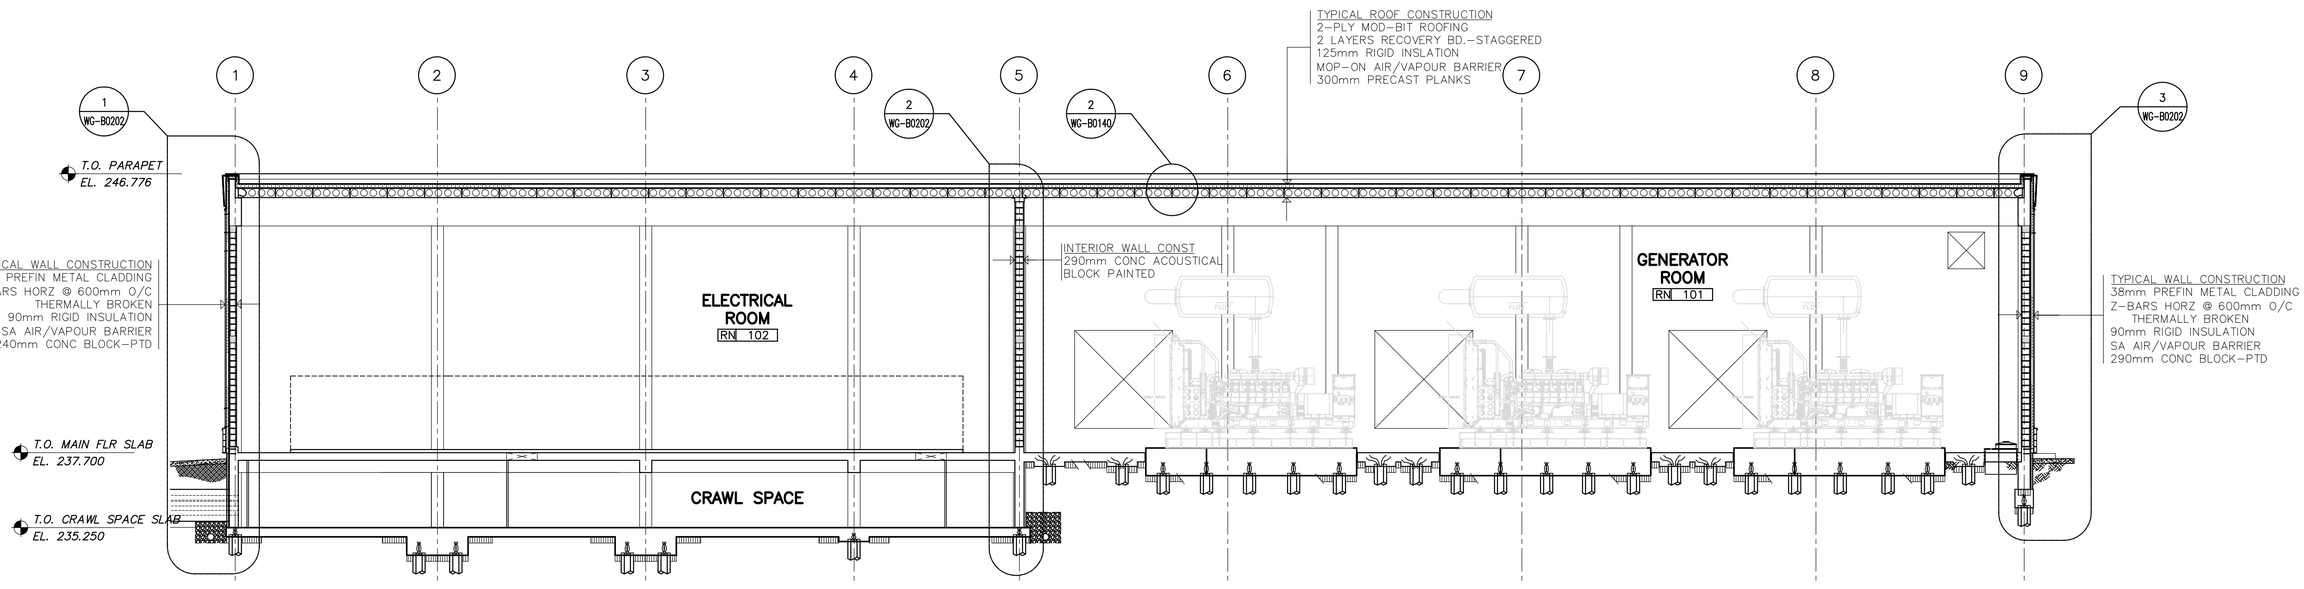

1 WG-B0100 BUILDING SECTION
1:100

B.M.
ELEV.

NO.	REVISIONS	DATE	BY
01	498-2006 ADDENDUM 10	06/10/24	AL
00	ISSUED FOR TENDER	06/08/28	AL

CH2MHILL
Frederickson Cooper ARCHITECTS
EarthTech A Tyco International Ltd. Company

DESIGNED BY	NC	CHECKED BY	LK
DRAWN BY	AL	APPROVED BY	AHL
SCALE:	AS SHOWN	RELEASED FOR CONSTRUCTION BY:	R. SOROKOWSKI
DATE	2006/06/01	DATE	2006/08/30

ENGINEER'S SEAL
ORIGINAL SIGNED BY
N. COOPER
2006/08/30

CONSULTANT DRAWING NO.
WG-B0201

Winnipeg
THE CITY OF WINNIPEG
WATER AND WASTE DEPARTMENT
ENGINEERING DIVISION

WATER TREATMENT PLANT
STANDBY POWER GENERATOR

CITY FILE NUMBER
SHEET OF

ARCHITECTURAL
BUILDING SECTIONS

CITY DRAWING NUMBER
1-0601G-A-B0201-001-01D

Last Save: 2006-10-26 10:02 AM

L:\WORK\79000\79538\02A-CAD\ARCH\CONTR\GENSET\DN_WG-B0201_FC BOUND.DWG