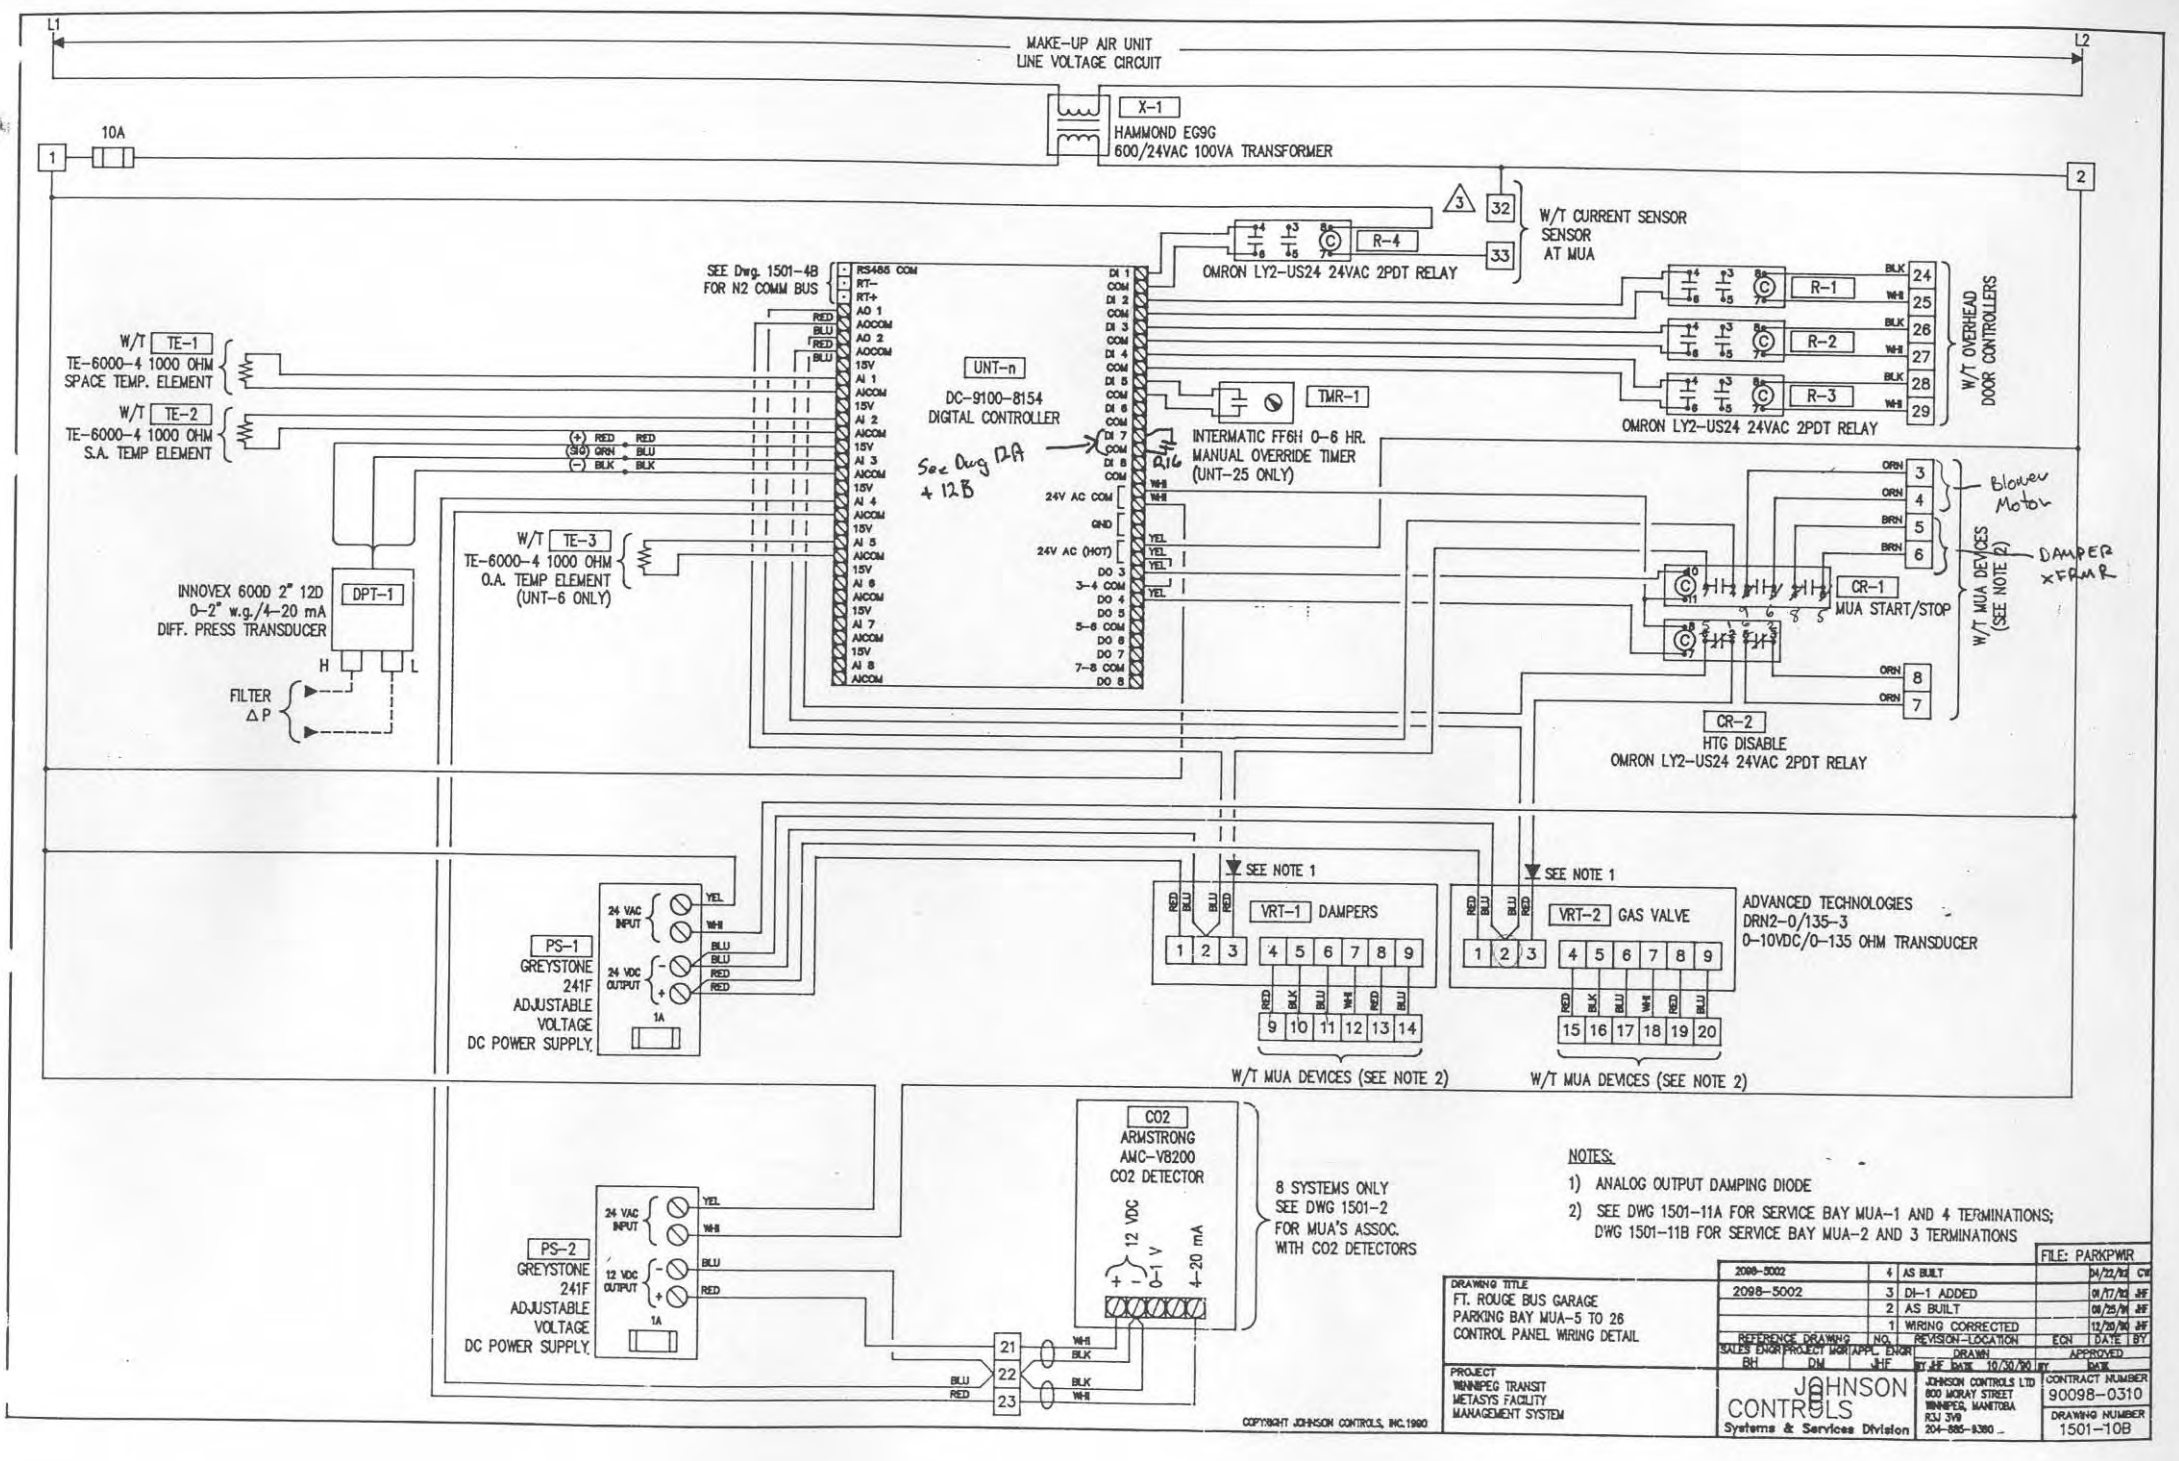

NOTES:

1) ANALOG OUTPUT DAMPING DIODE
2) SEE DWG 1501-11A FOR SERVICE BAY MUA-1 AND 4 TERMINATIONS; DWG 1501-11B FOR SERVICE BAY MUA-2 AND 3 TERMINATIONS

FILE: PARKPWR

2098-5002	4	AS BUILT		04/22/92 CW
2098-5002	3	DI-1 ADDED		01/17/92 JHF
	2	AS BUILT		08/25/91 JHF
	1	WIRING CORRECTED		12/20/90 JHF
REFERENCE DRAWING NO.	REVISION-LOCATION		ECN	DATE BY

SALES ENGR: BH | PROJECT MGR: DM | APPL. ENGR: JHF | DRAWN: JHF DATE 10/30/90 | APPROVED BY: DATE:

DRAWING TITLE
FT. ROUGE BUS GARAGE
PARKING BAY MUA-5 TO 26
CONTROL PANEL WIRING DETAIL

PROJECT
WINNIPEG TRANSIT
METASYS FACILITY
MANAGEMENT SYSTEM

JOHNSON CONTROLS
Systems & Services Division

JOHNSON CONTROLS LTD
800 MORAY STREET
WINNIPEG, MANITOBA
R3J 3V9
204-885-8380

CONTRACT NUMBER
90098-0310

DRAWING NUMBER
1501-10B